

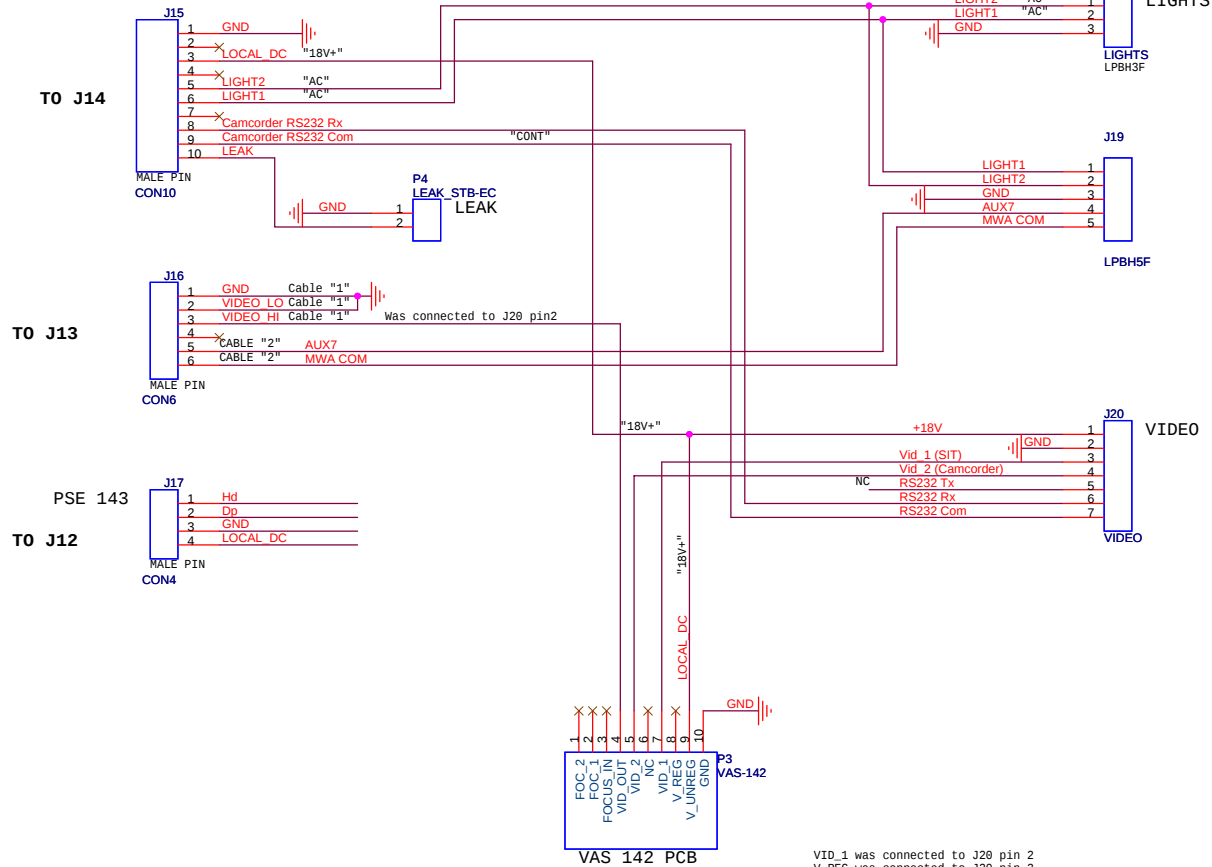
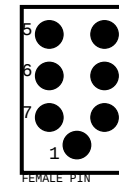


ALL CONNECT
TO U4:
STBD
TUBE

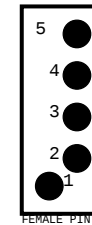

ALL STBD
BULKHEAD CONNECTORS

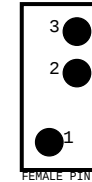

VID_1 was connected to J20 pin 2
V_REG was connected to J20 pin 3
V_UNREG as connected to +18v

		Monterey Bay Aquarium Research Institute 7700 Sandhold Road, Moss Landing, CA 95039		
		Title STARBOARD ENDCAP		
Engineer <Engineer>	Size B	Document Number <Doc>	Layout File <Layout File>	Rev <Rev>
Layout <Layout>	Date: Monday, March 10, 2008	Sheet 1	of 1	1