
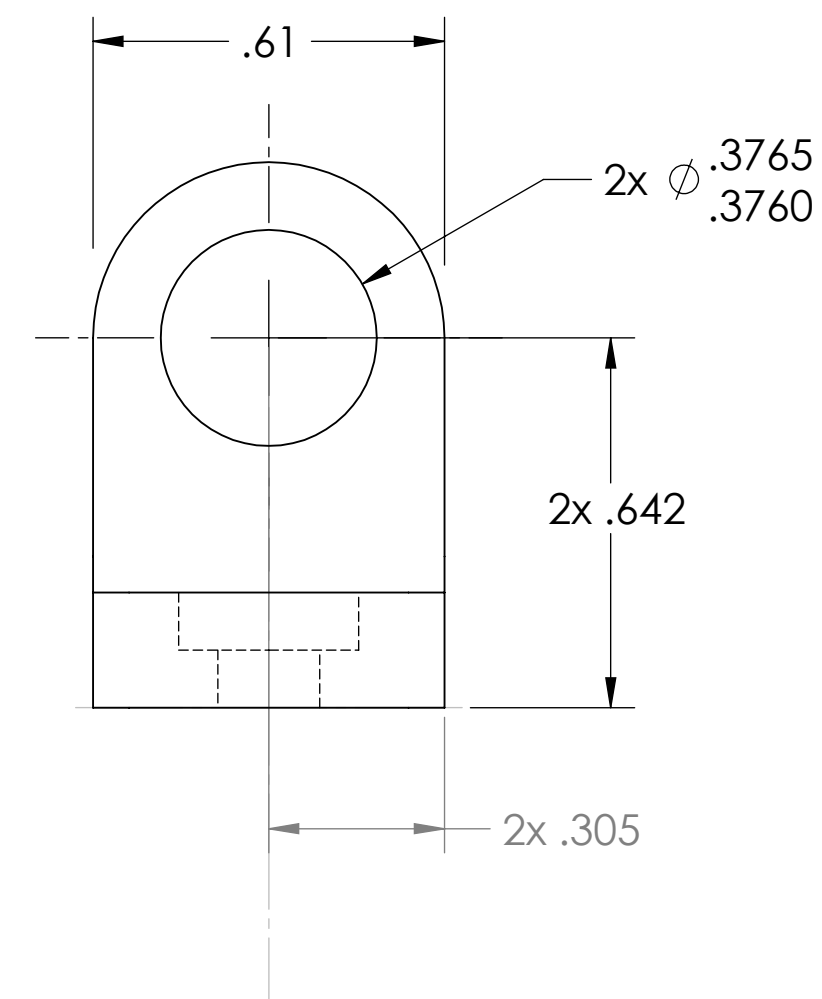
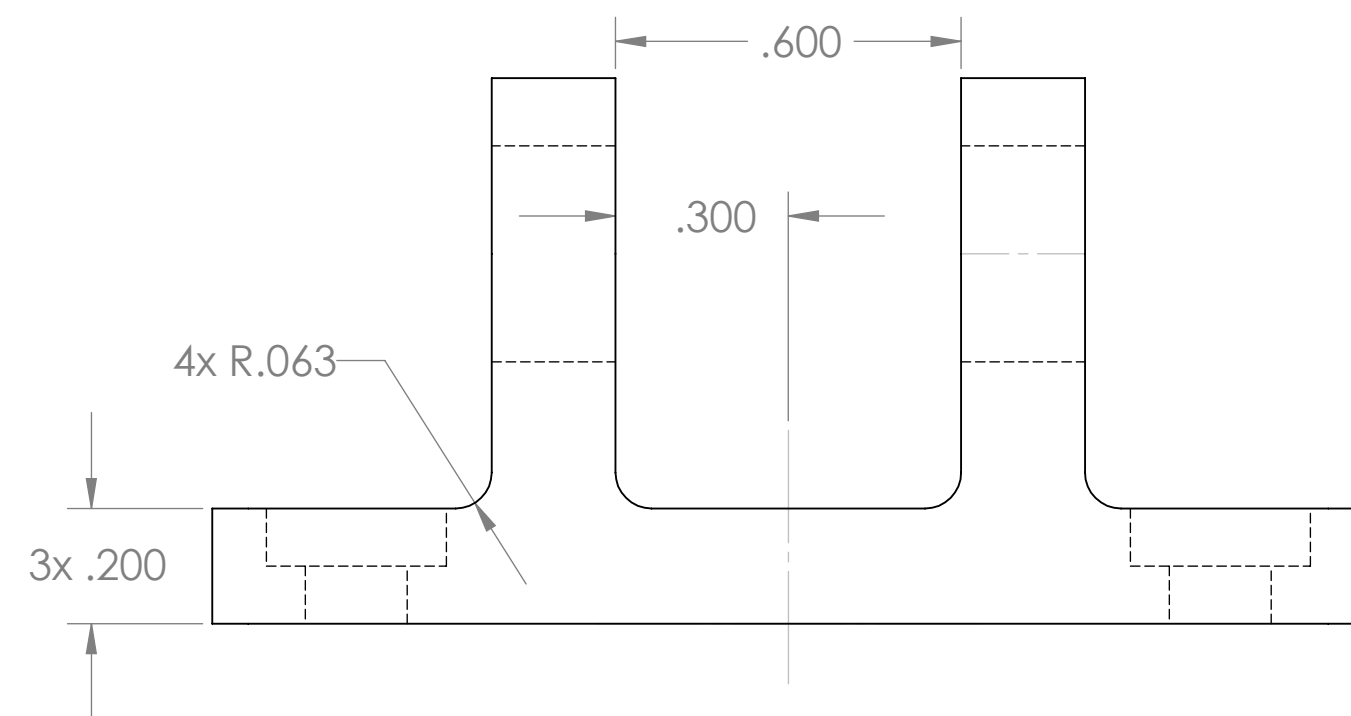
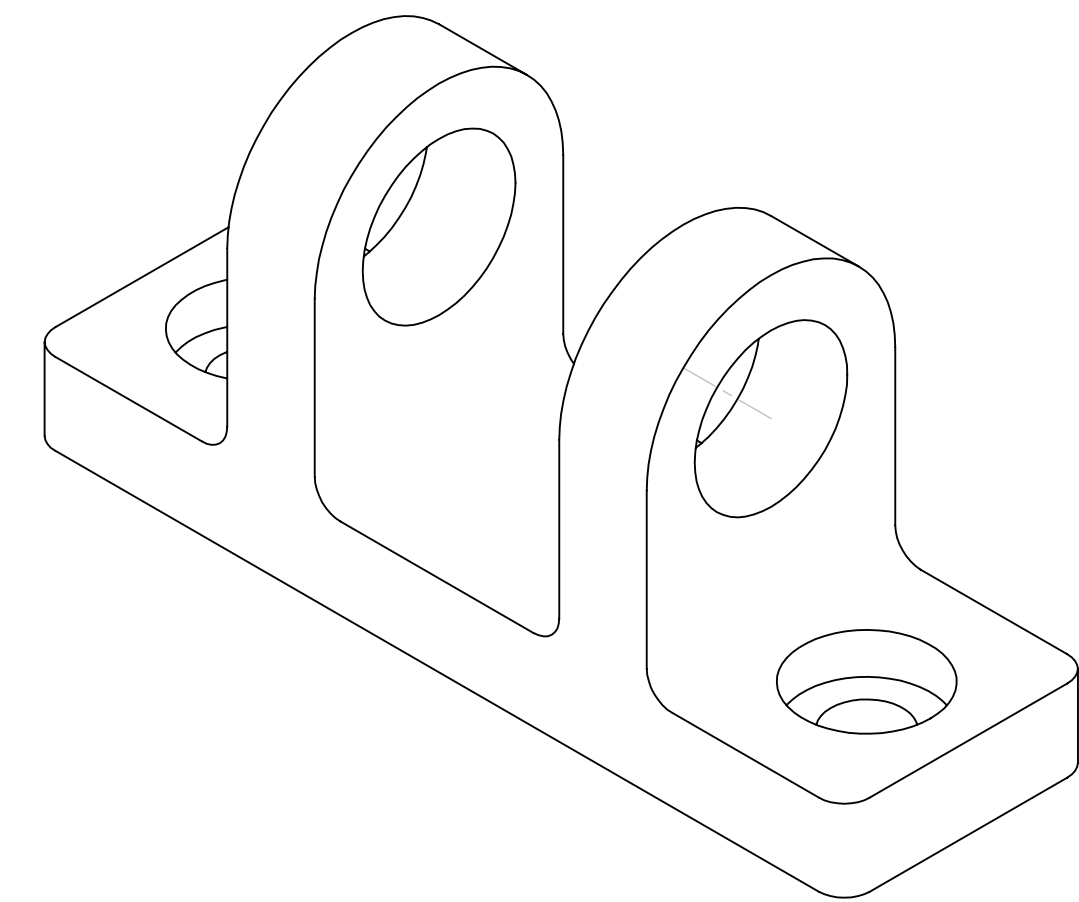


3 Items indicated have been changed or added since previous revision. Changed items are colored red in solid model.

REVISIONS				
ZONE	REV.	DESCRIPTION	DATE	APPROVED
	01	INITIAL DRAWING		
	02	INCREASE SPACING OF CLEVIS, HOLES, INCREASE THK	12/17/2007	WHA

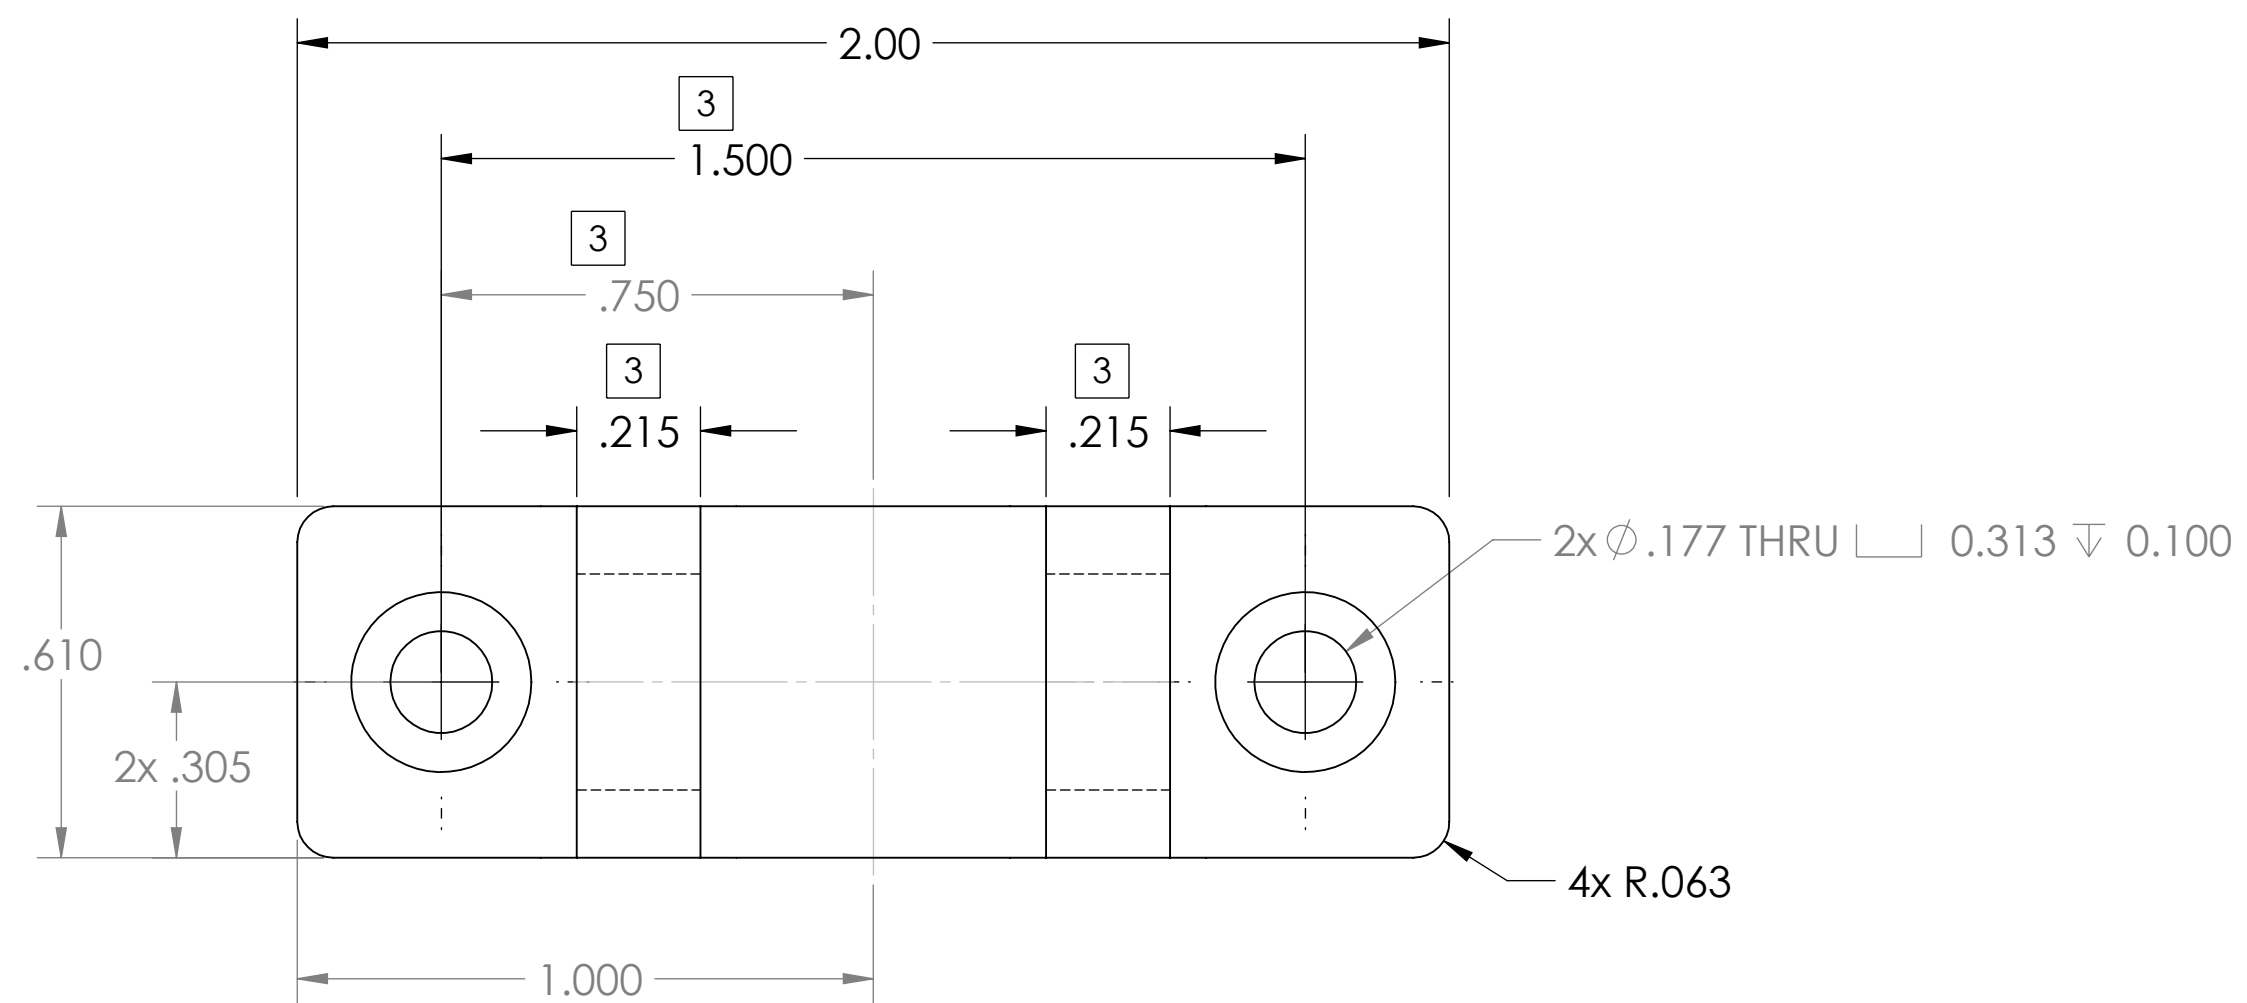

UNLESS OTHERWISE SPECIFIED:		NAME	DATE	SANTA CLARA UNIVERSITY/MBARI TITLE: CLEVIS BRACKET, GIMBAL
DIMENSIONS ARE IN INCHES		DRAWN	F. SHANE	
TOLERANCES:		CHECKED	W. ANDERSON 12/17/2007	
ANGULAR: ± 1.0		ENG APPR.	F. SHANE	
LINEAR:		MFG APPR.		
XX .XX ± 0.1				SIZE DWG. NO. REV D VPT-0007 02 SCALE: 3:1 WEIGHT: SHEET 1 OF 1
XX.X ± 0.03				
XXX.X ± 0.010				
INTERPRET DRAWING PER: ASME Y14.100-2004				
MATERIAL:		COMMENTS:		
SEE NOTES		PROJECT NO: 900744.00		
FRESH	SEE NOTES			