
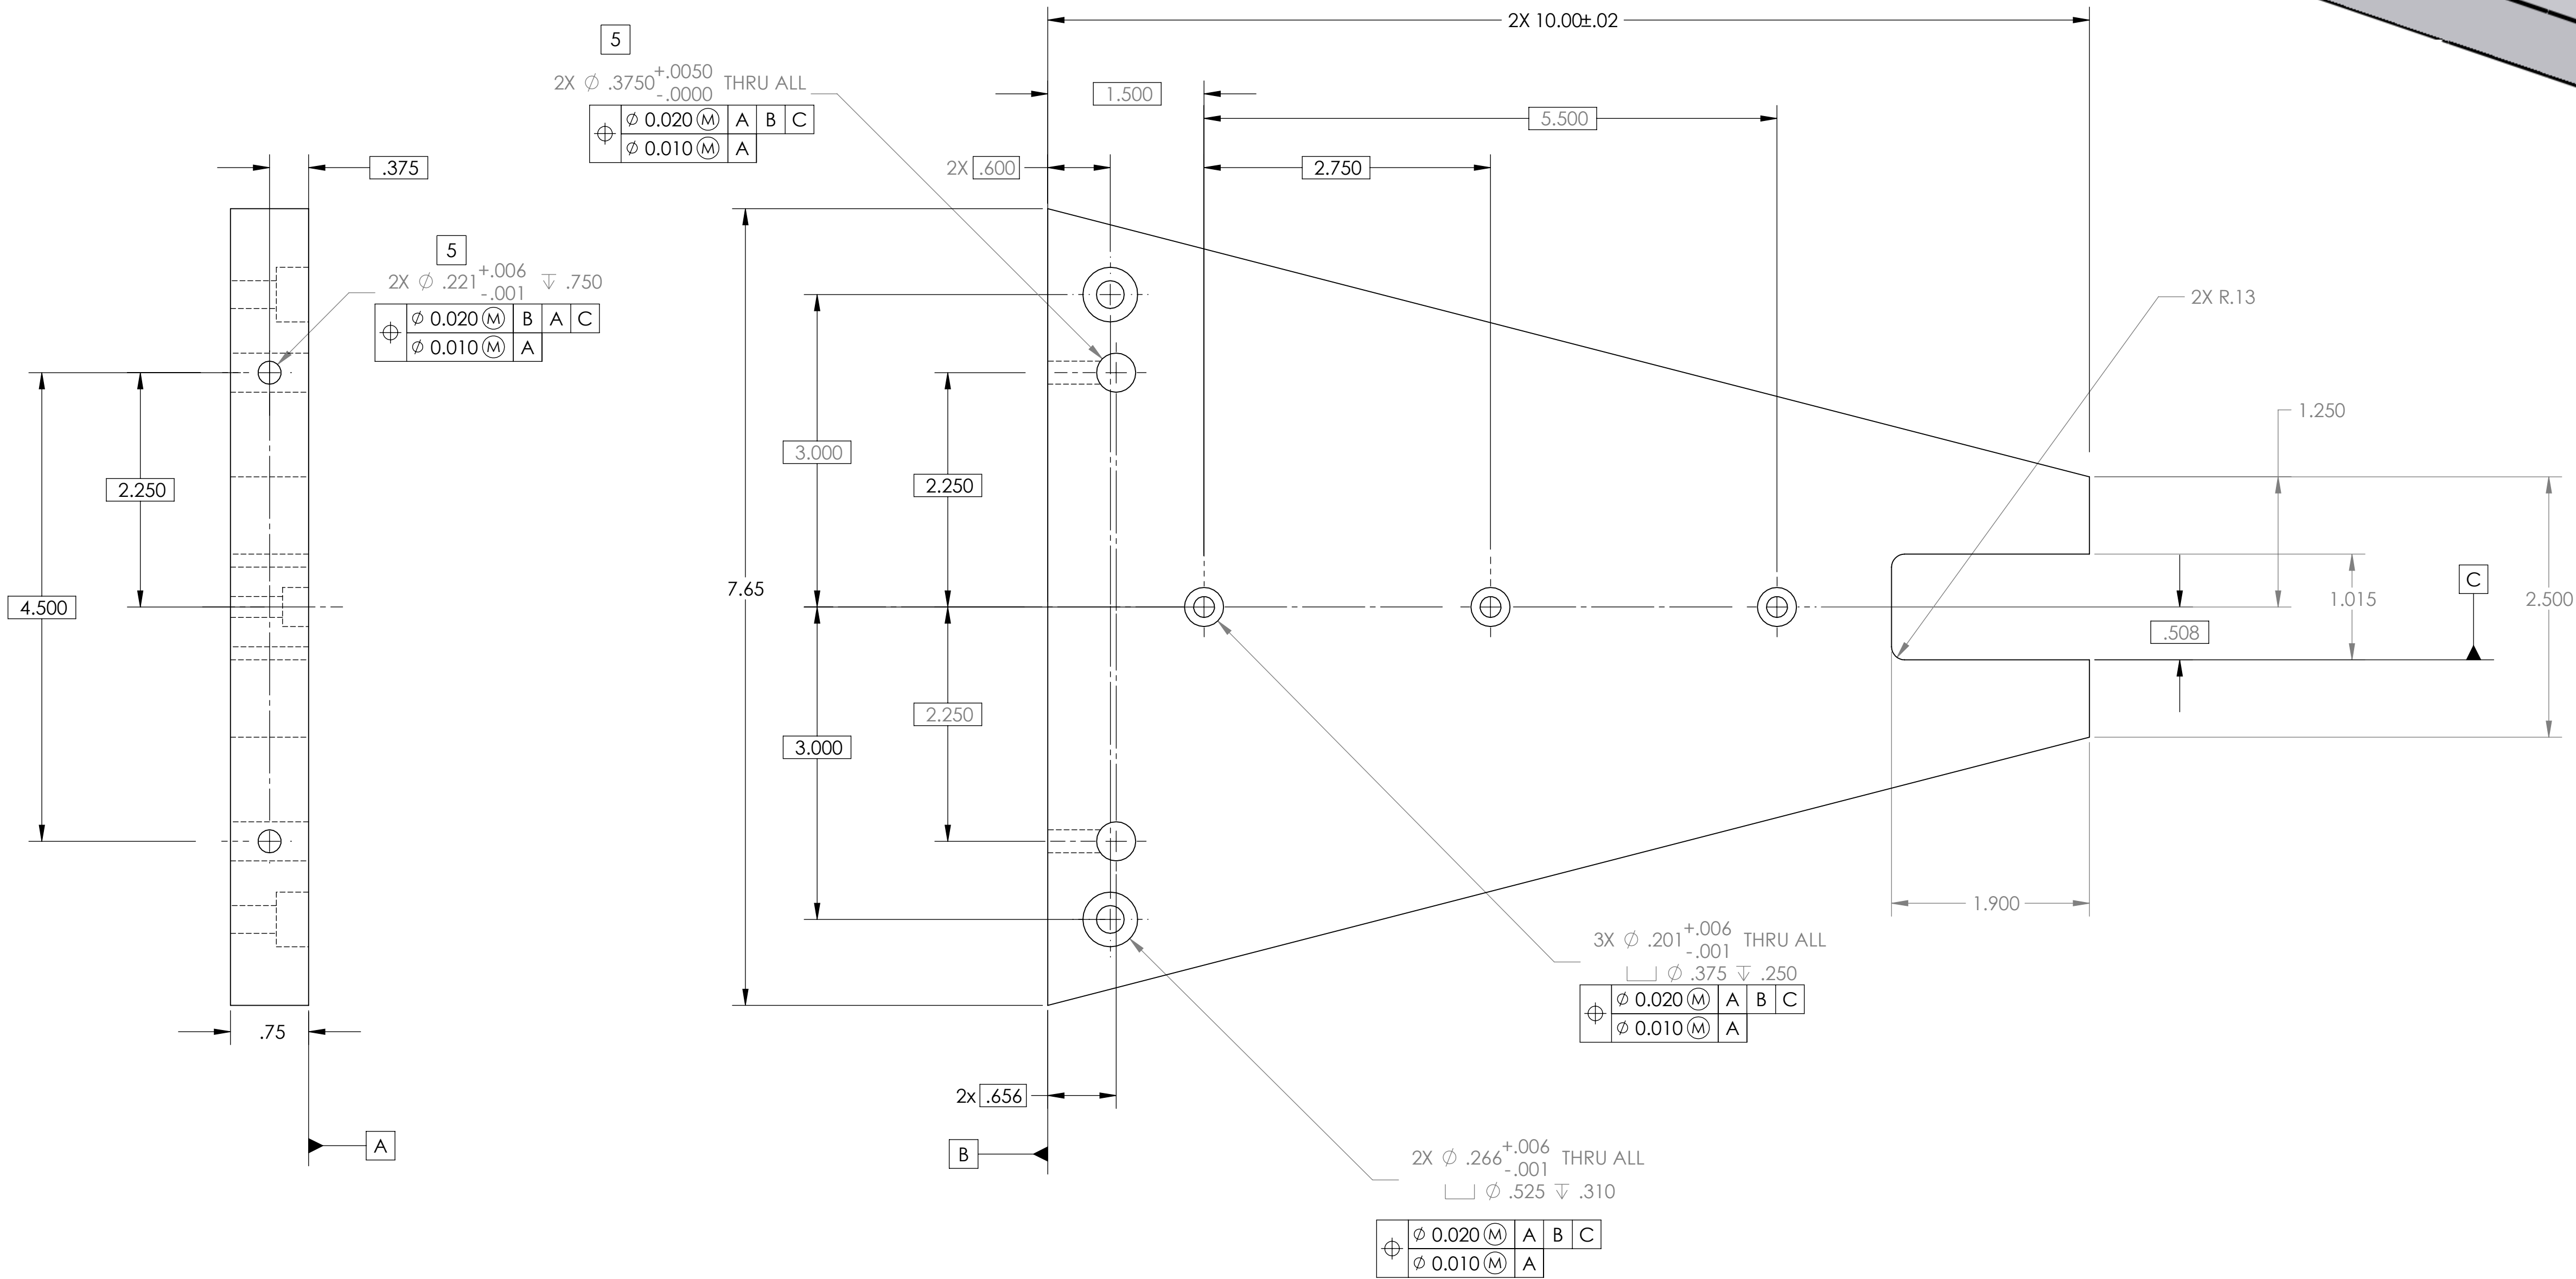


NOTES: UNLESS SPECIFIED OTHERWISE

1. MATERIAL: UHMW POLYETHELENE
2. COLOR: WHITE
3. FINISH: NONE
4. SURFACE FINISH $\sqrt[125]{\hspace{1cm}}$ MAX
- 5 INDICATED FEATURE HAS BEEN MODIFIED OR ADDED SINCE PREVIOUS REVISION

REVISIONS				
ZONE	REV.	DESCRIPTION	DATE	APPROVED
	01	INITIAL DRAWING, RELEASE FOR FABRICATION	11/19/2007	WHA
	02	CHANGED DIAMETER OF BARREL NUT HOLES	12/03/2007	WHA

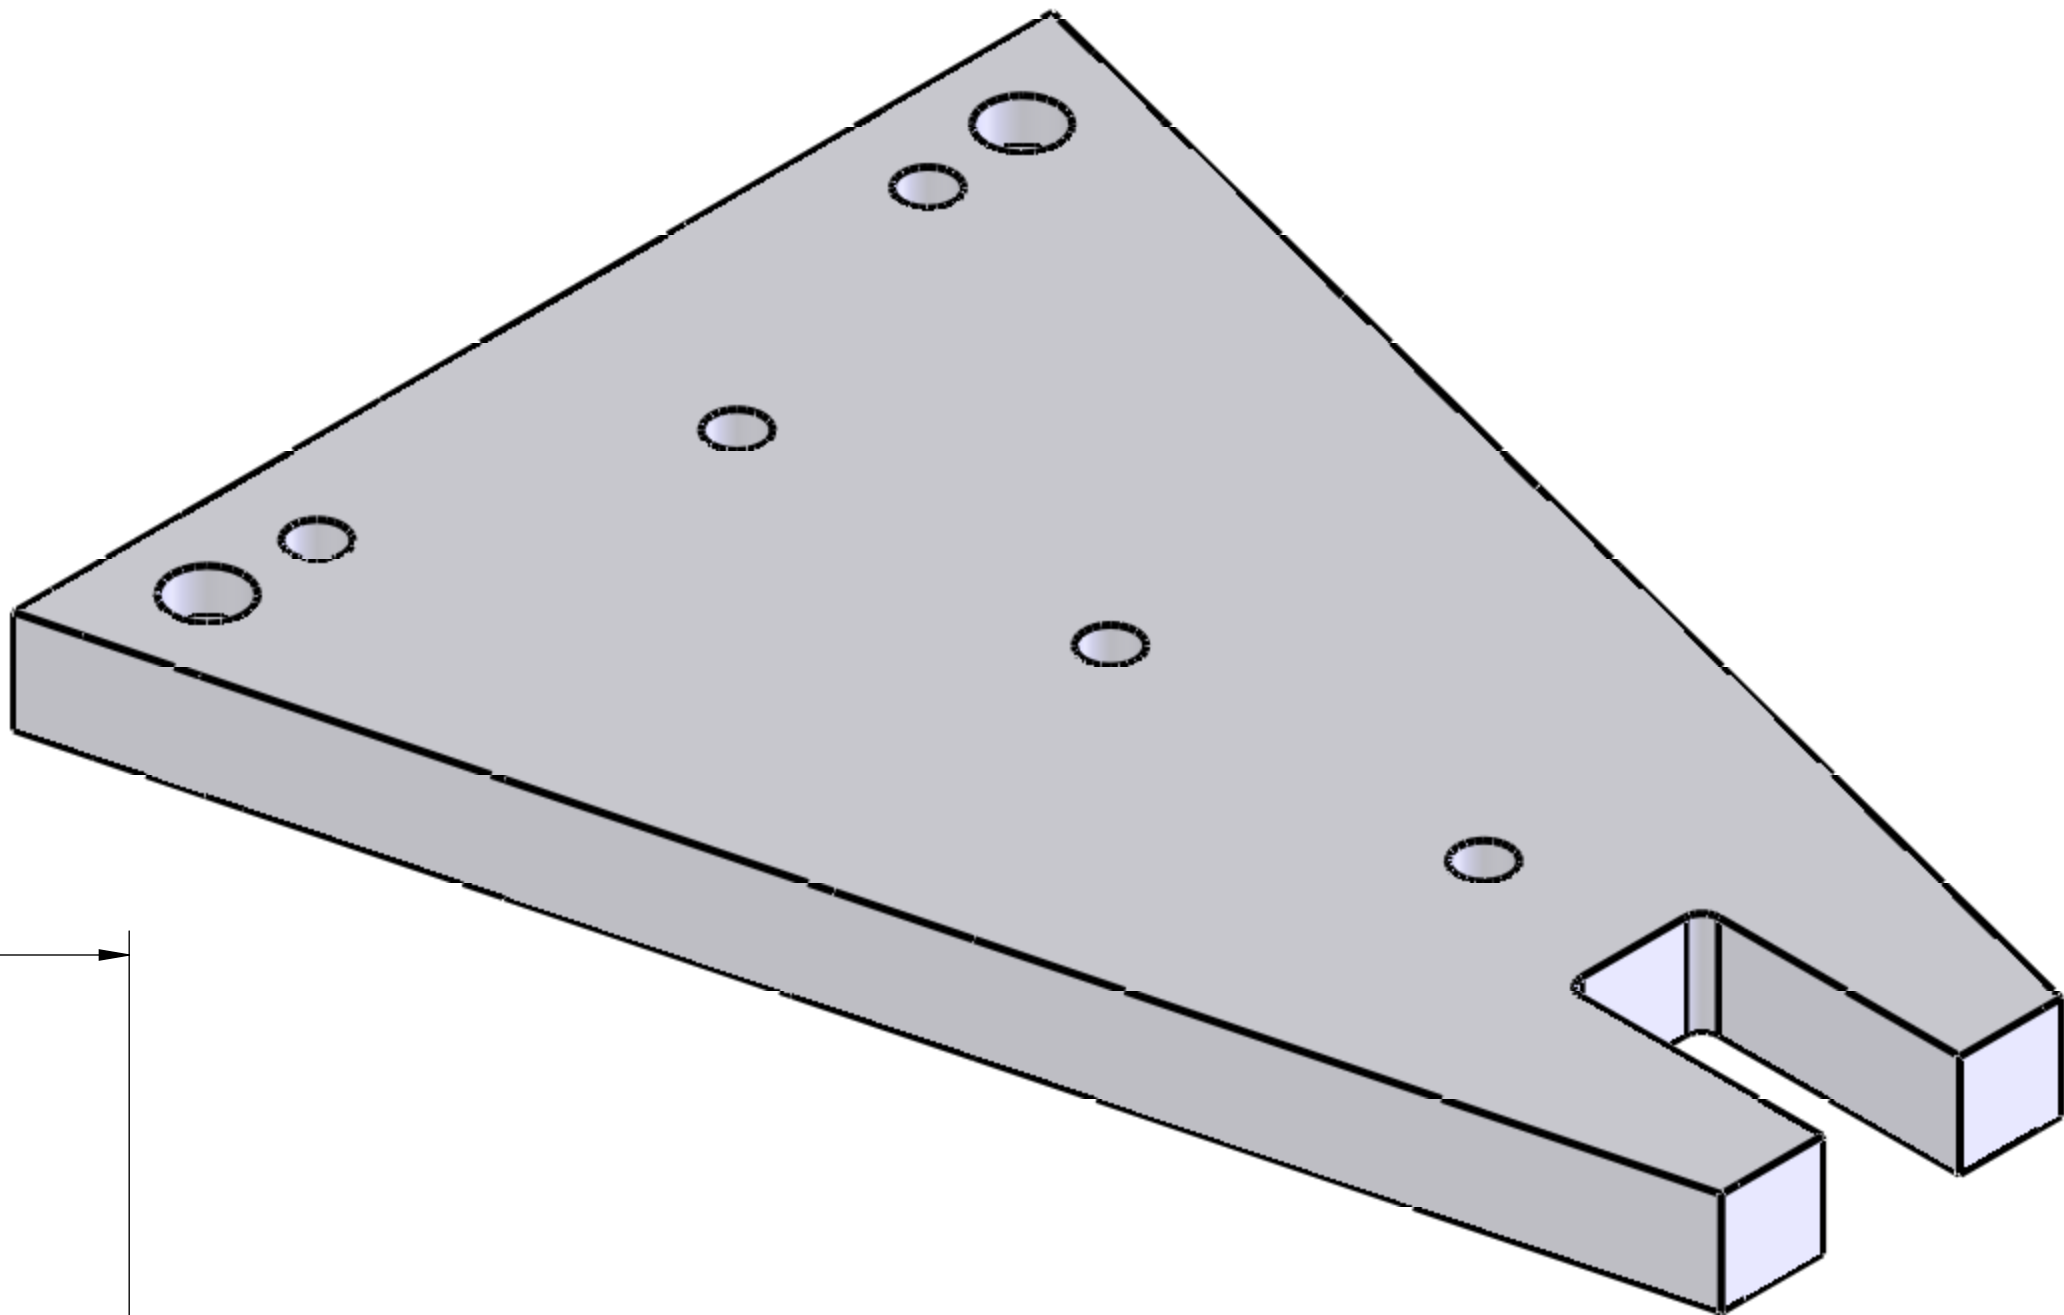

PROPRIETARY AND CONFIDENTIAL THE INFORMATION CONTAINED IN THIS DRAWING IS THE SOLE PROPERTY OF SANTA CLARA UNIVERSITY. ANY REPRODUCTION IN PART OR AS A WHOLE WITHOUT THE WRITTEN PERMISSION OF SANTA CLARA UNIVERSITY IS PROHIBITED.	MATERIAL	PROJECT NO: 900744.00	SIZE	DWG. NO.	REV
	SEE NOTES		D	VPT-0006	01
	FINISH	SEE NOTES	SCALE: 1:1 WEIGHT:		SHEET 1 OF 1