
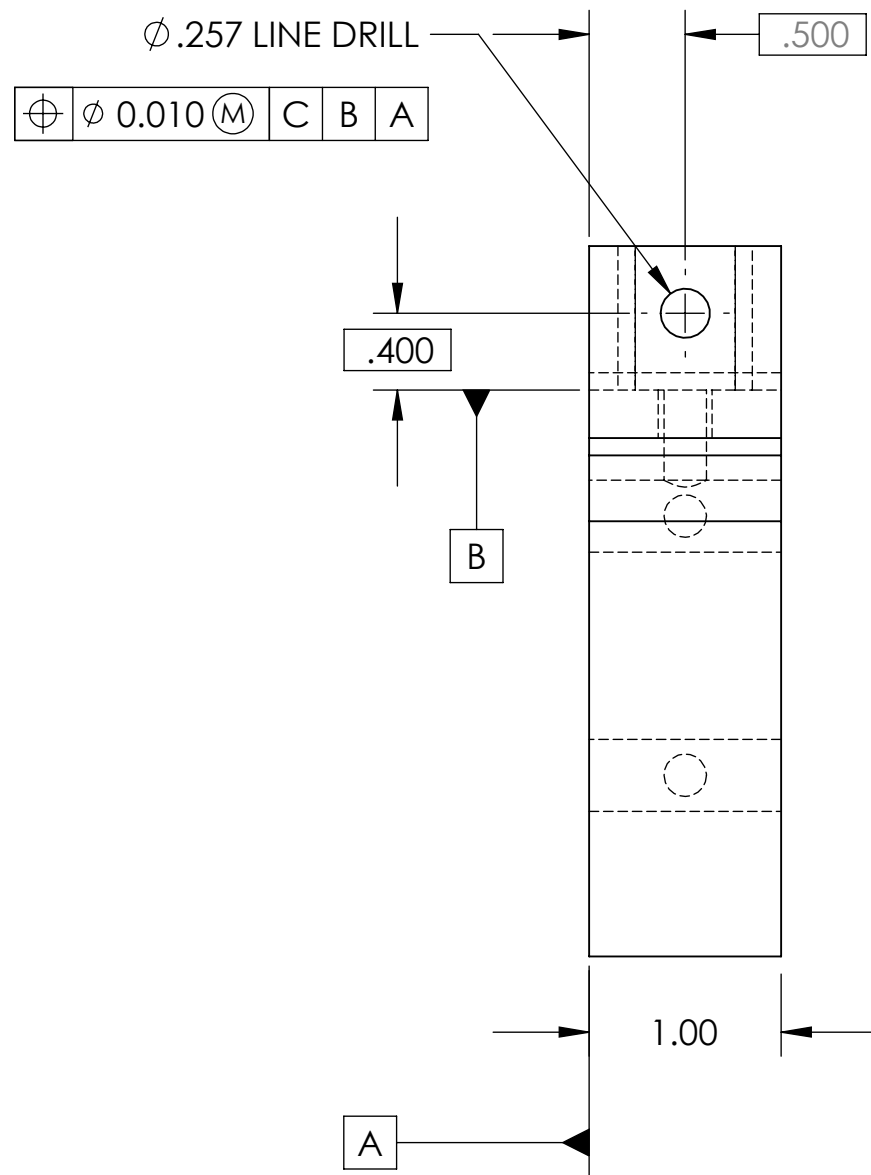
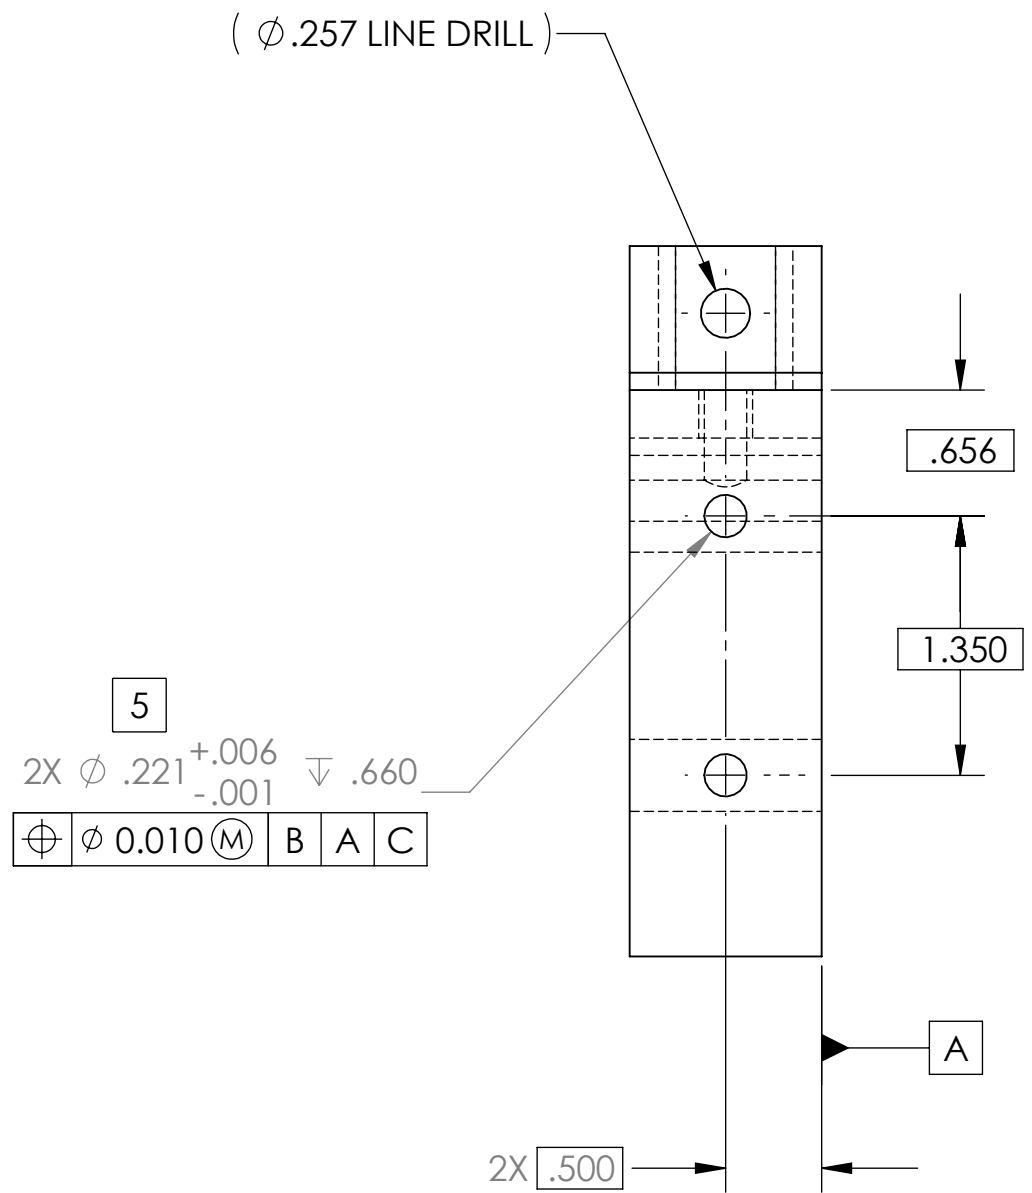
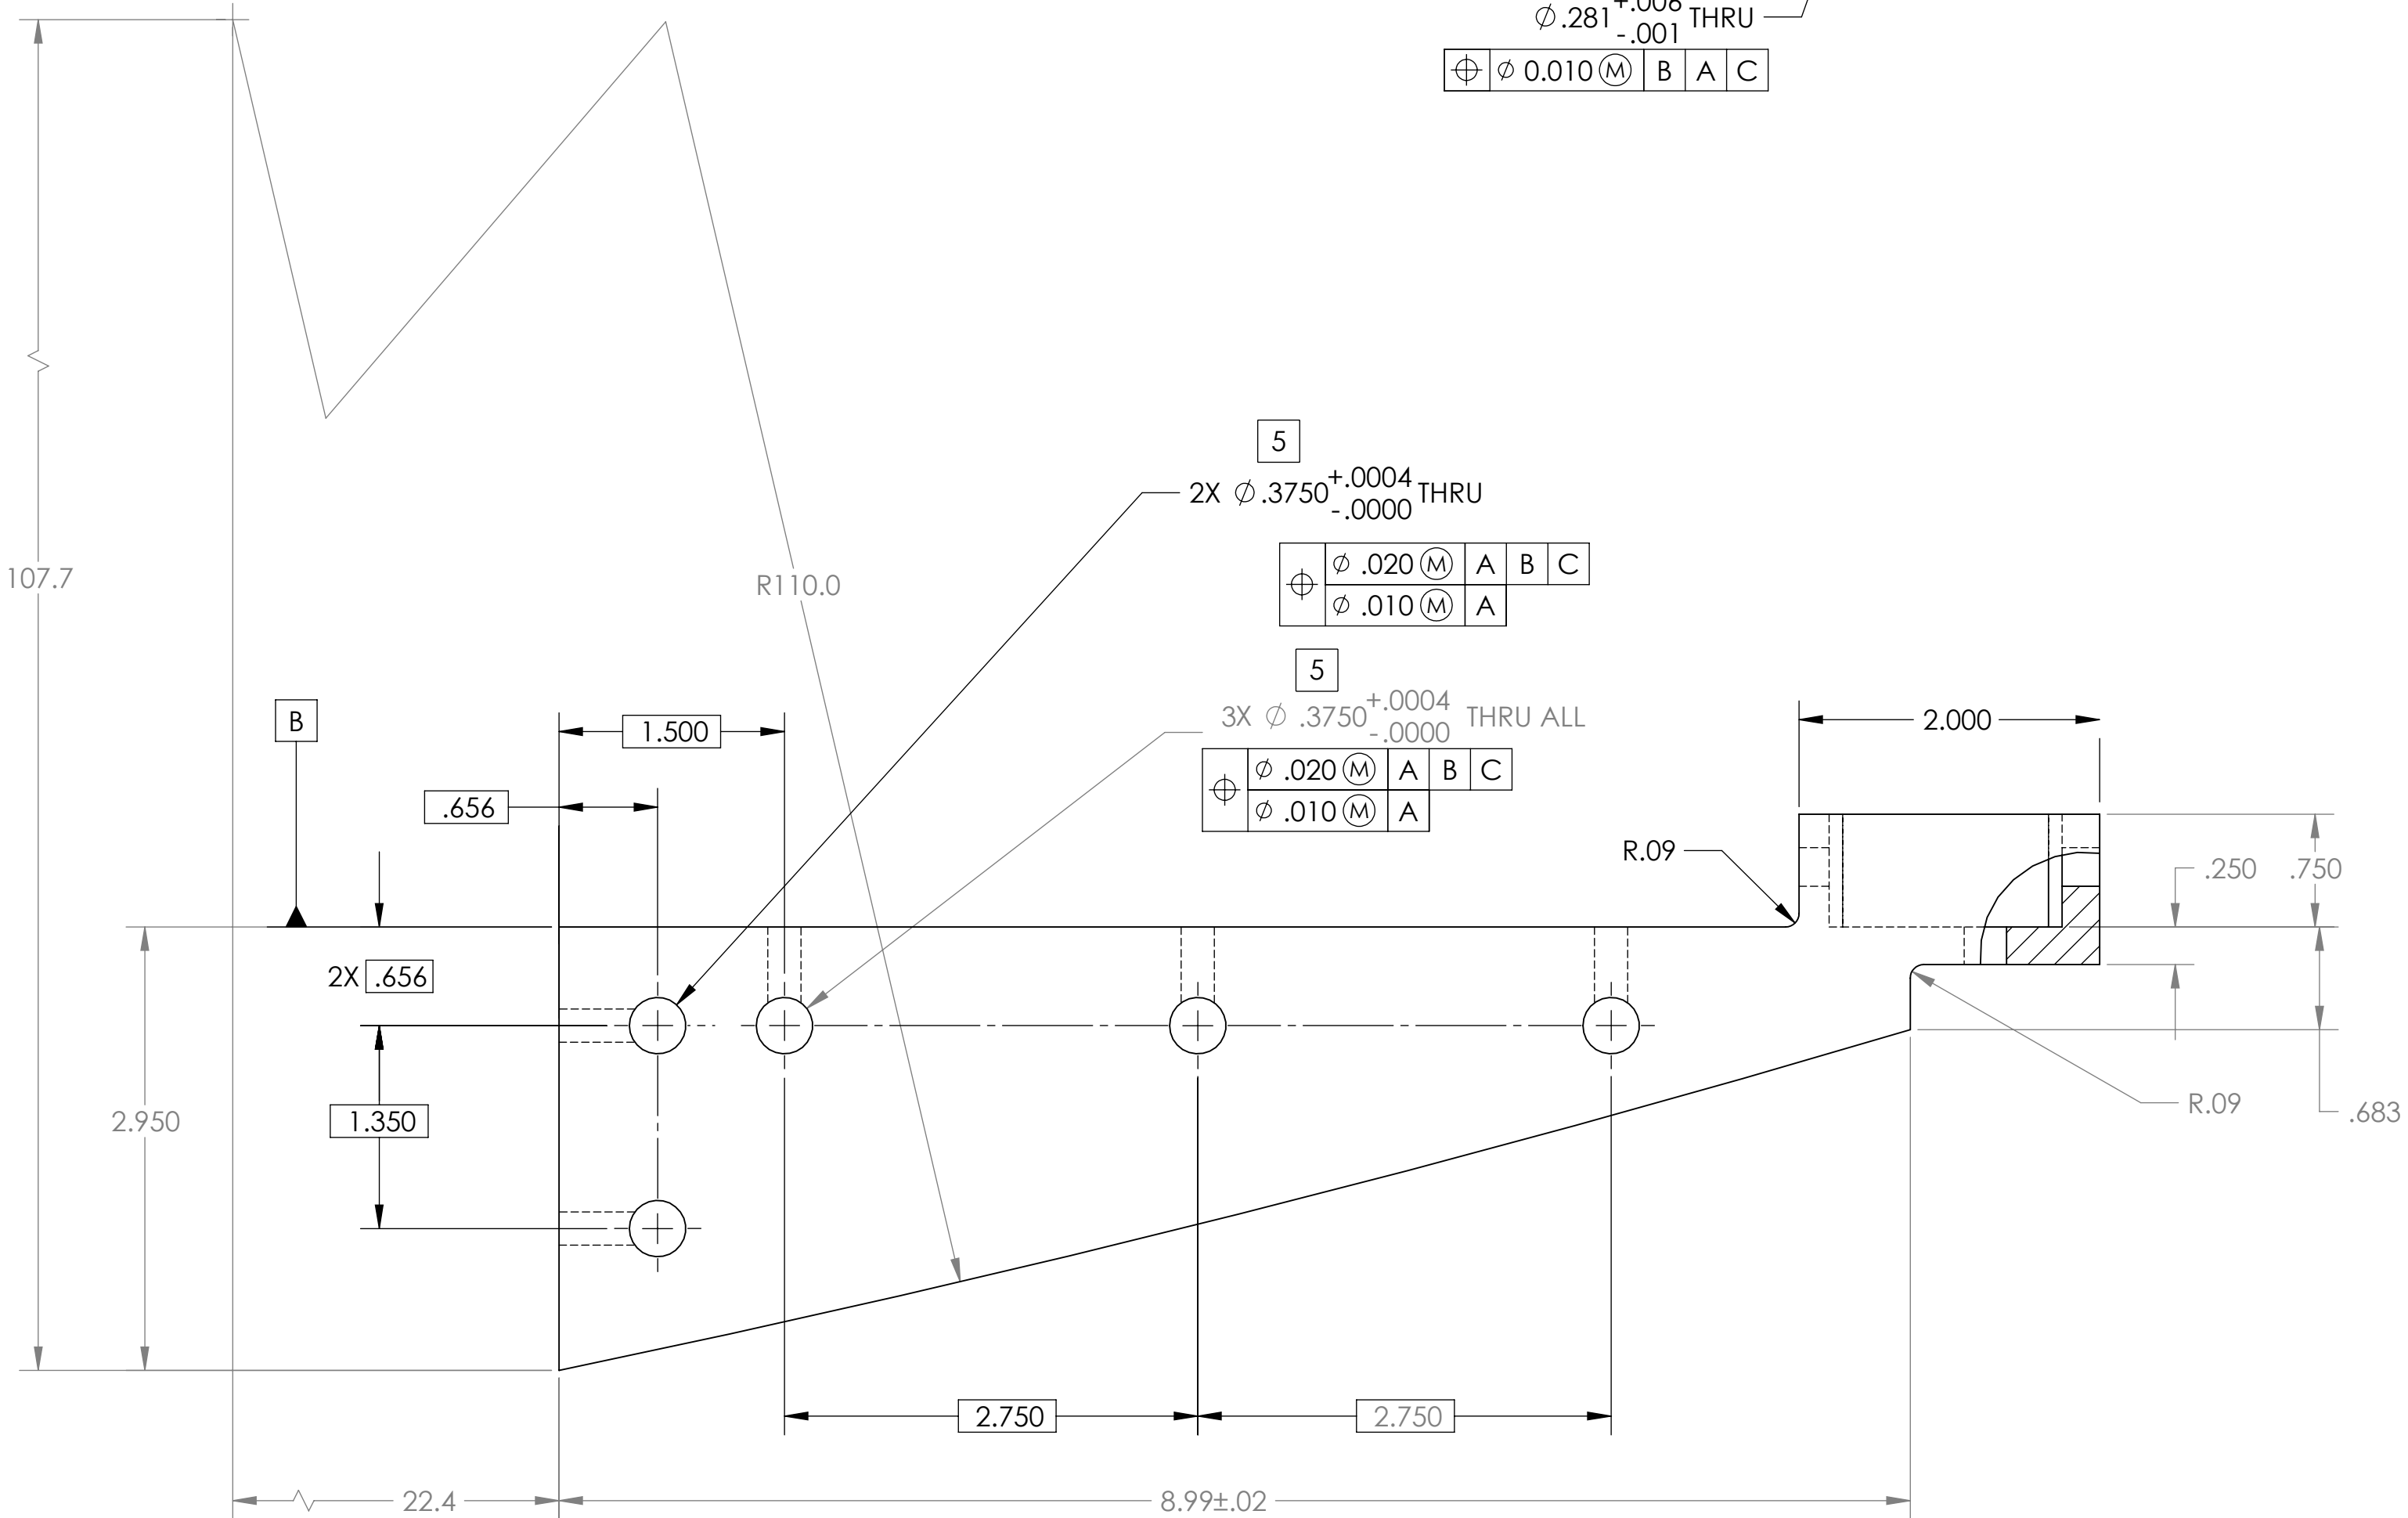
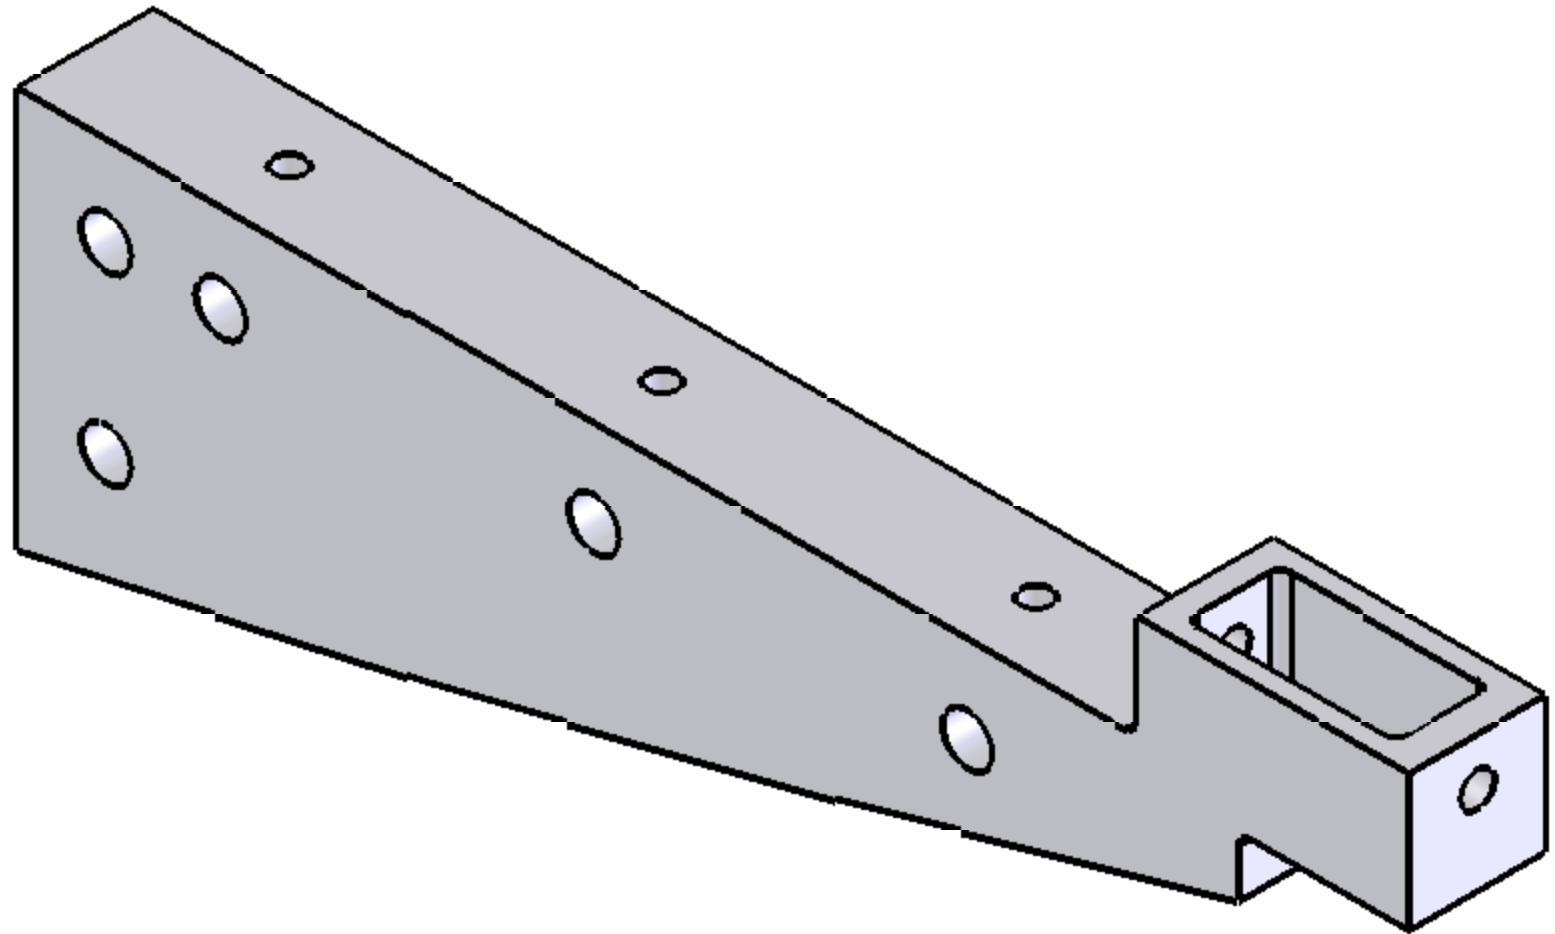


NOTES: UNLESS SPECIFIED OTHERWISE

1. MATERIAL: UHMW POLYETHELENE
2. COLOR: WHITE
3. FINISH: NONE
4. SURFACE FINISH $\sqrt{125}$ MAX
- 5 INDICATED FEATURE HAS BEEN MODIFIED OR ADDED SINCE PREVIOUS REVISION

REVISIONS				
ZONE	REV.	DESCRIPTION	DATE	APPROVED
	01	INITIAL DRAWING, RELEASE FOR FABRICATION	11/19/2007	WHA
	02	CHANGED DIAMETER OF BARREL NUT HOLES	12/03/2007	WHA

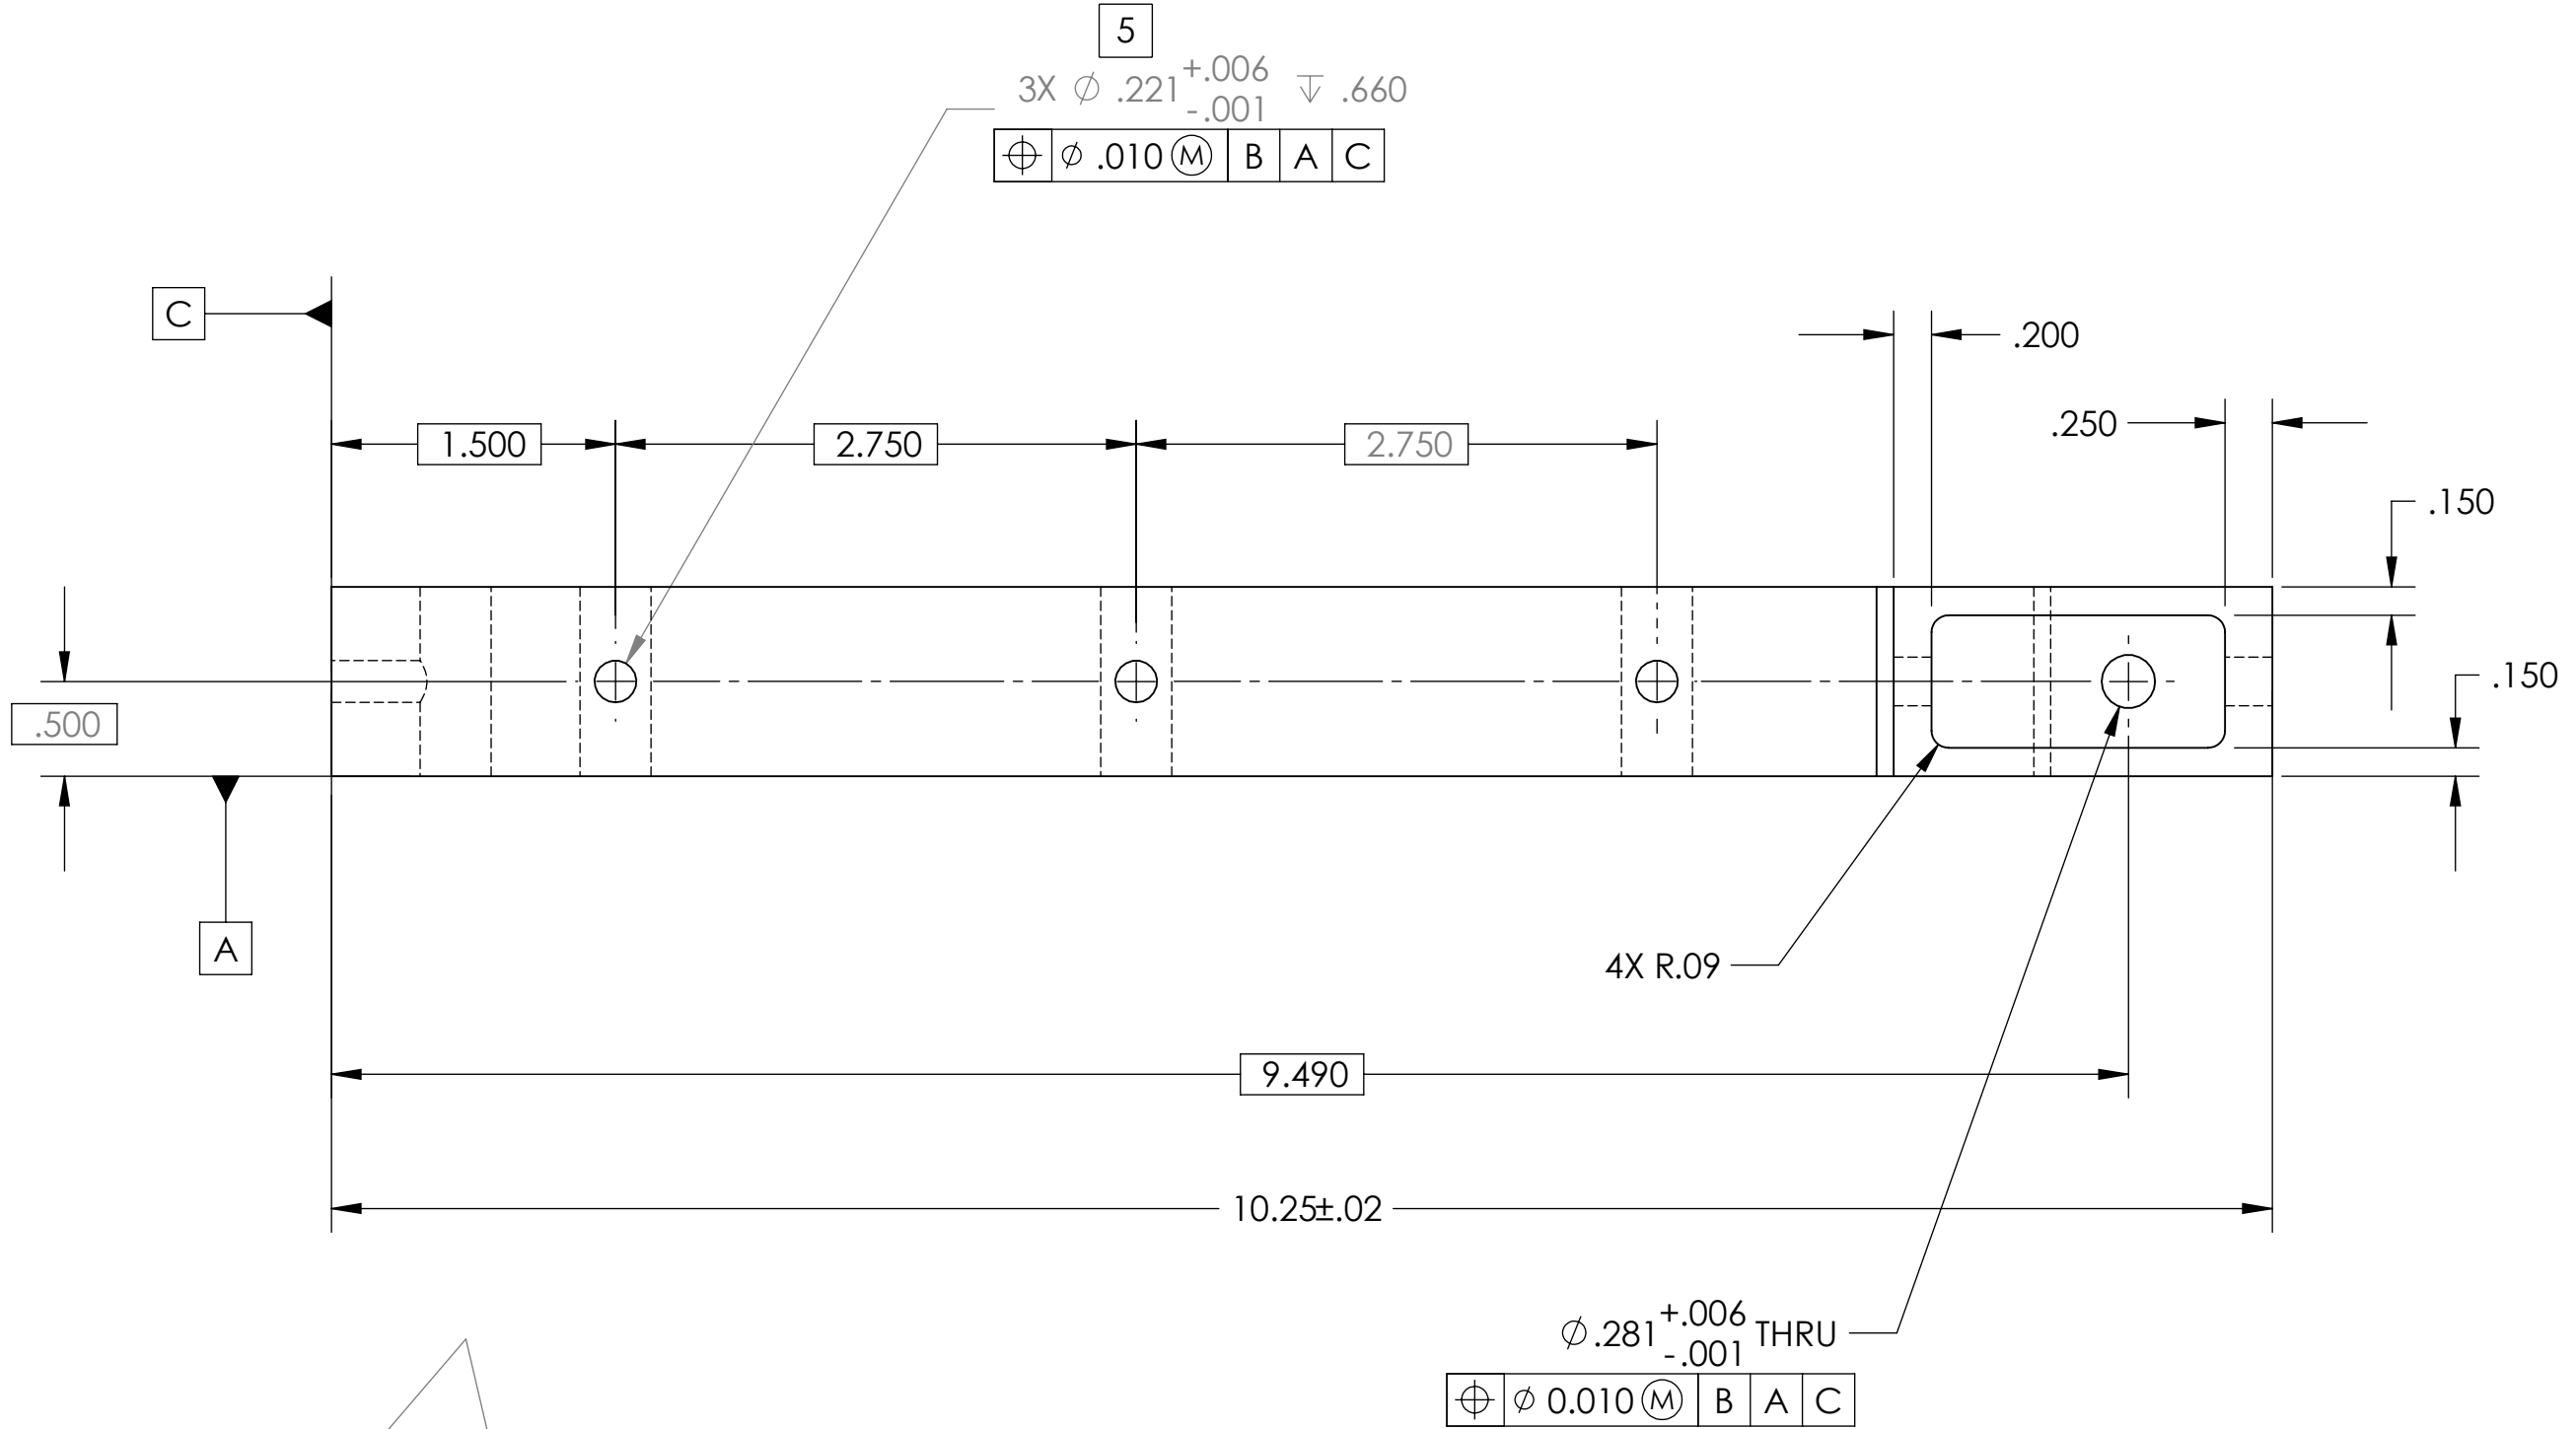

THE INFORMATION CONTAINED IN THIS DRAWING IS THE SOLE PROPERTY OF SANTA CLARA UNIVERSITY. ANY REPRODUCTION IN PART OR AS A WHOLE WITHOUT THE WRITTEN PERMISSION OF SANTA CLARA UNIVERSITY IS PROHIBITED.	UNLESS OTHERWISE SPECIFIED: DIMENSIONS ARE IN INCHES TOLERANCES: ANGULAR: ± 1.0 LINEAR: X.X ± 0.1 X.XX ± 0.025 X.XXX ± 0.010		NAME W. ANDERSON	DATE 9/8/2007	SANTA CLARA UNIVERSITY/MBARI TITLE: LOWER STRINGER SIZE DWG. NO. D VPT-0005 SCALE: 1:1 WEIGHT: SHEET 1 OF 1
			CHECKED	10/27/07	
			ENG APPR. W. ANDERSON		
			MFG APPR.		
			G.A.		
			COMMENTS:		
INTERPRET DRAWING PER: ASME Y14.100-2004					
MATERIAL: SEE NOTES		PROJECT NO: 900744.00			
FINISH SEE NOTES					