
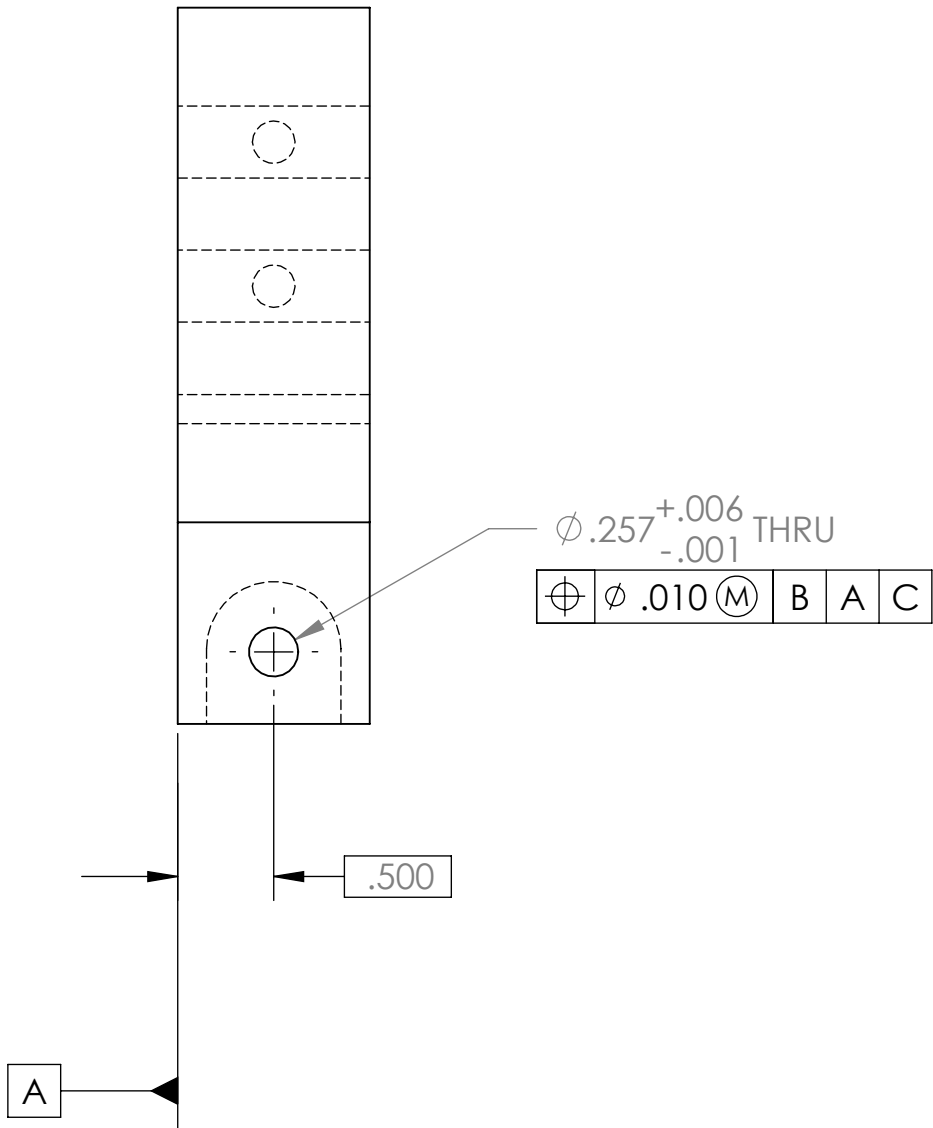
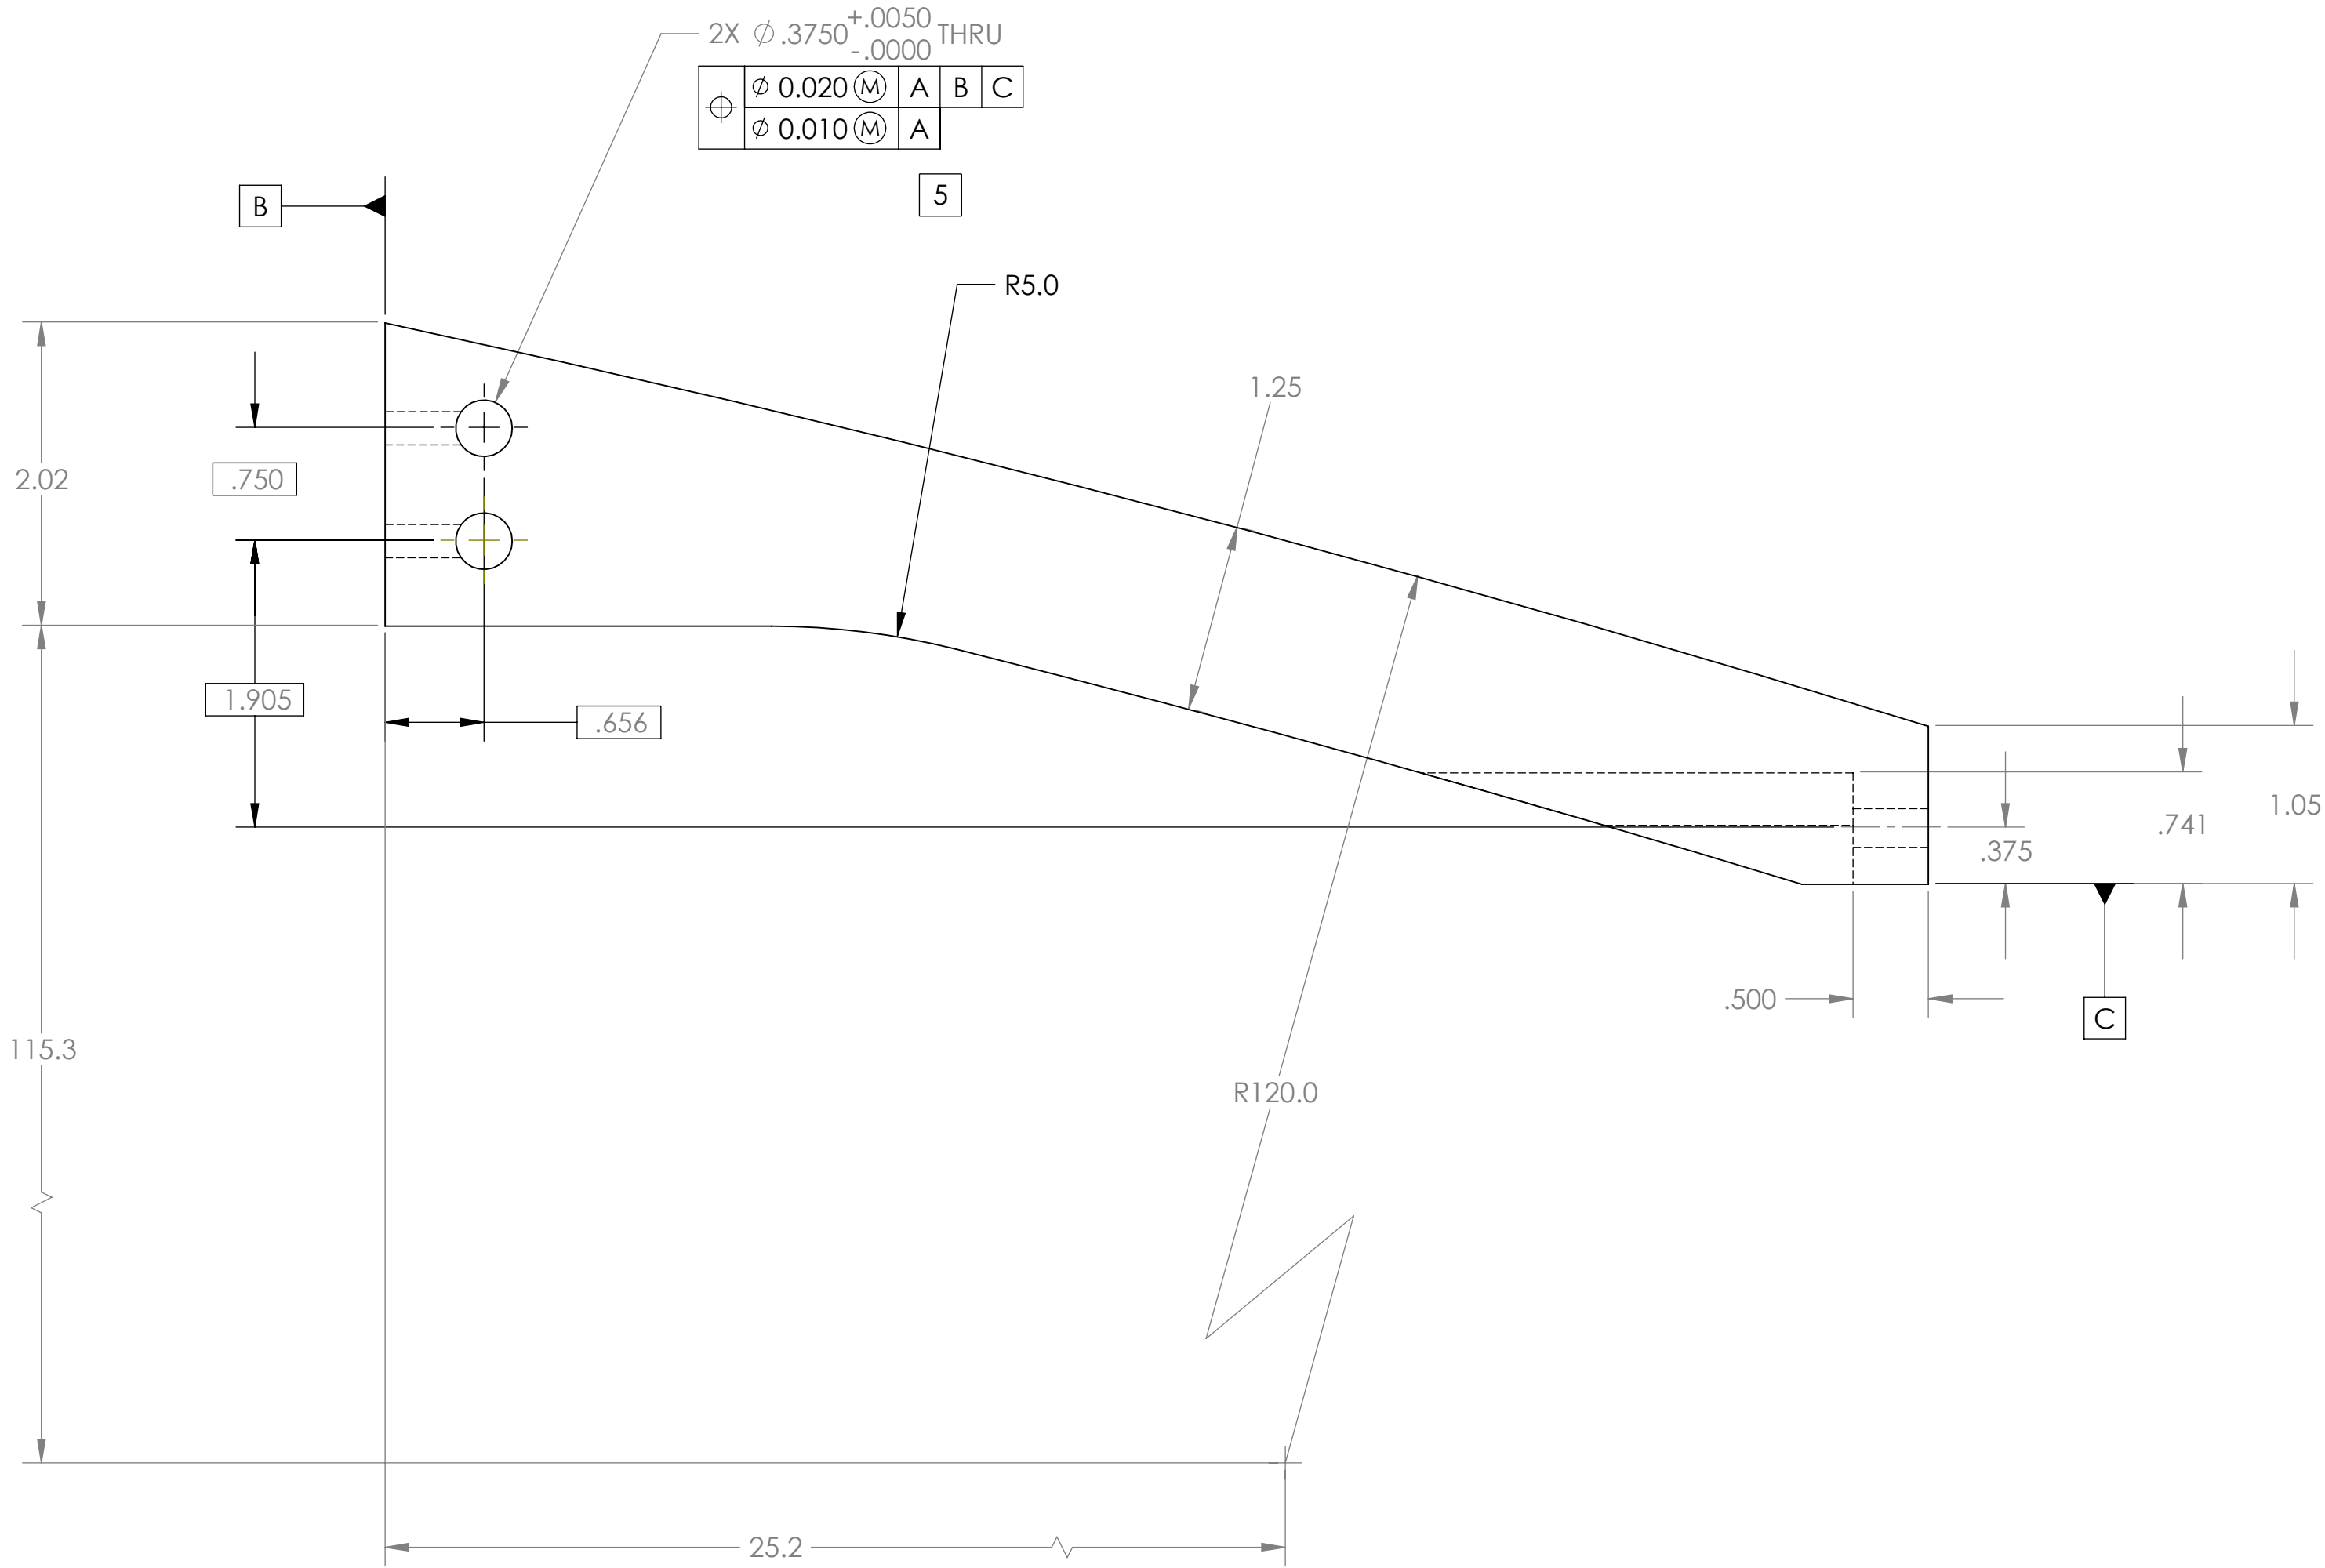
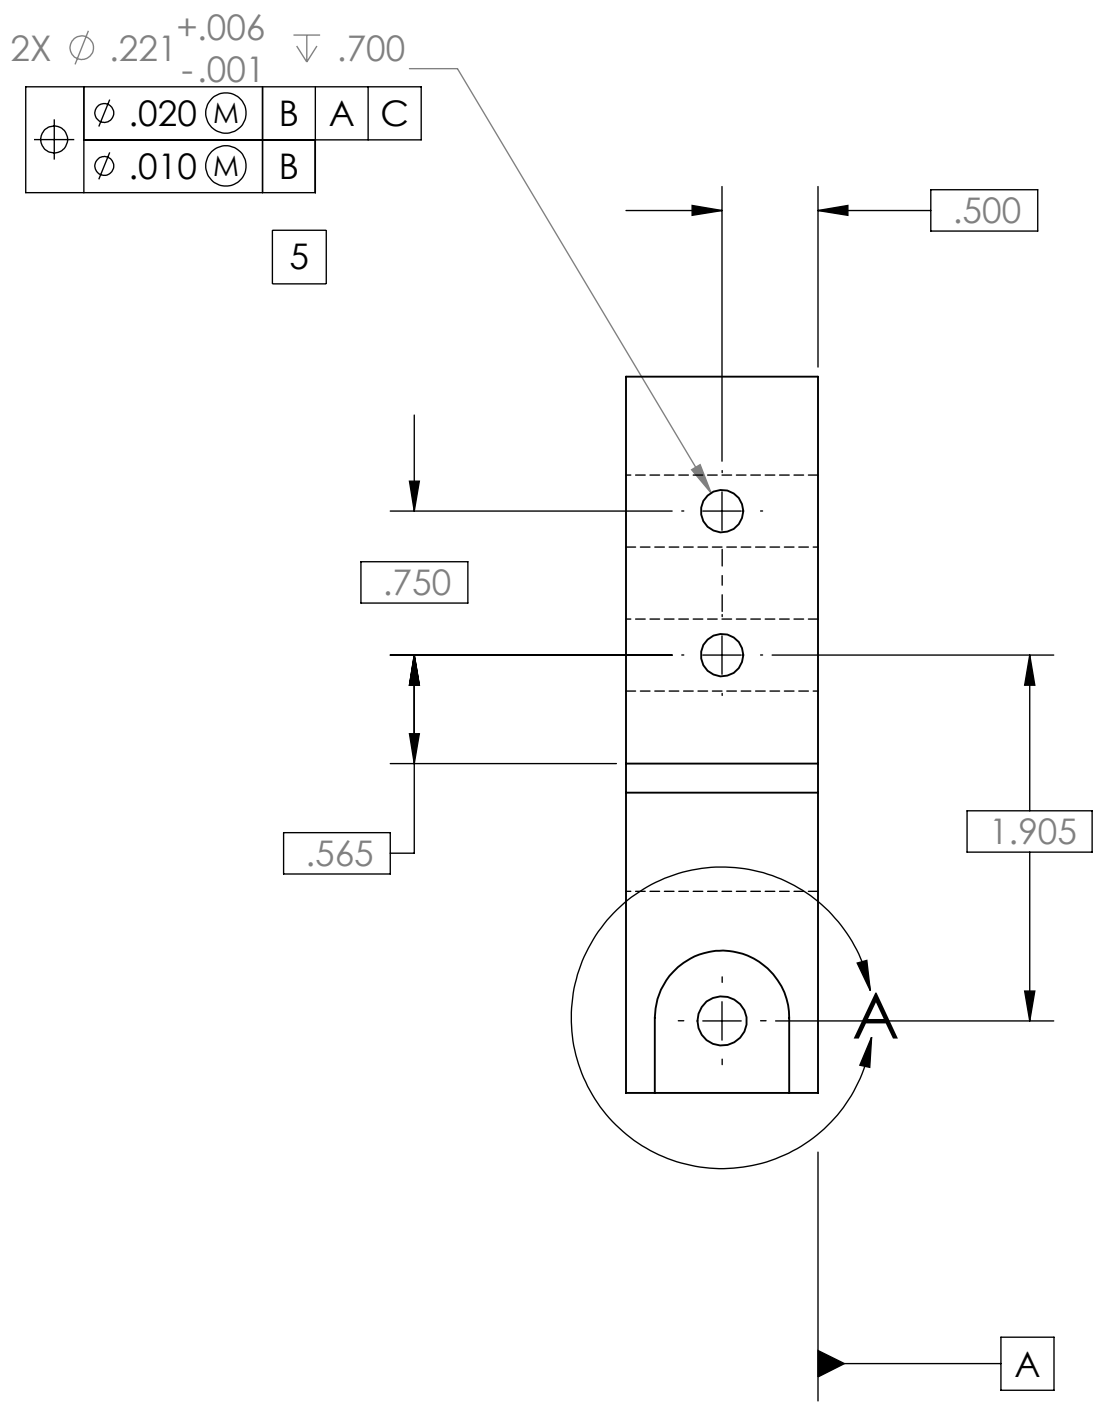
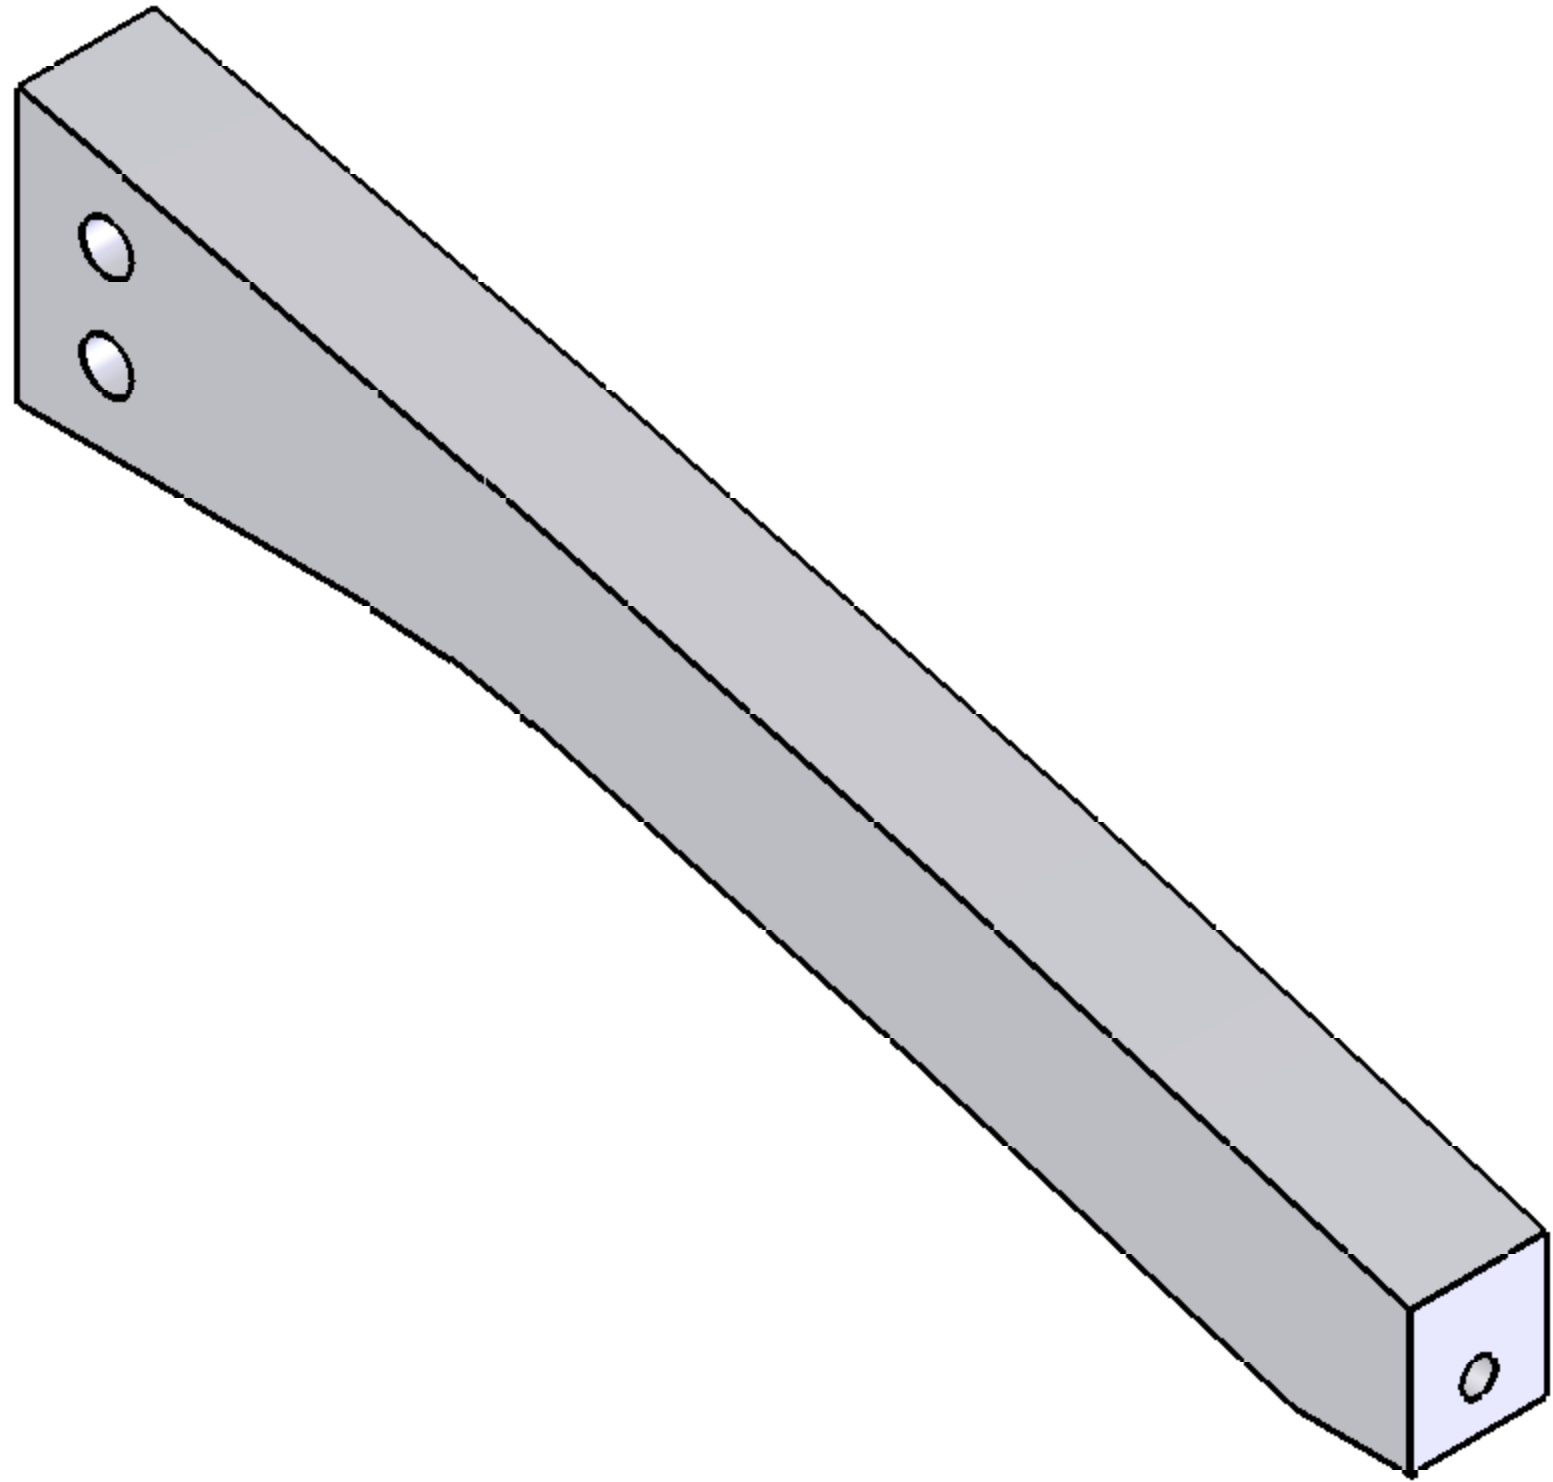
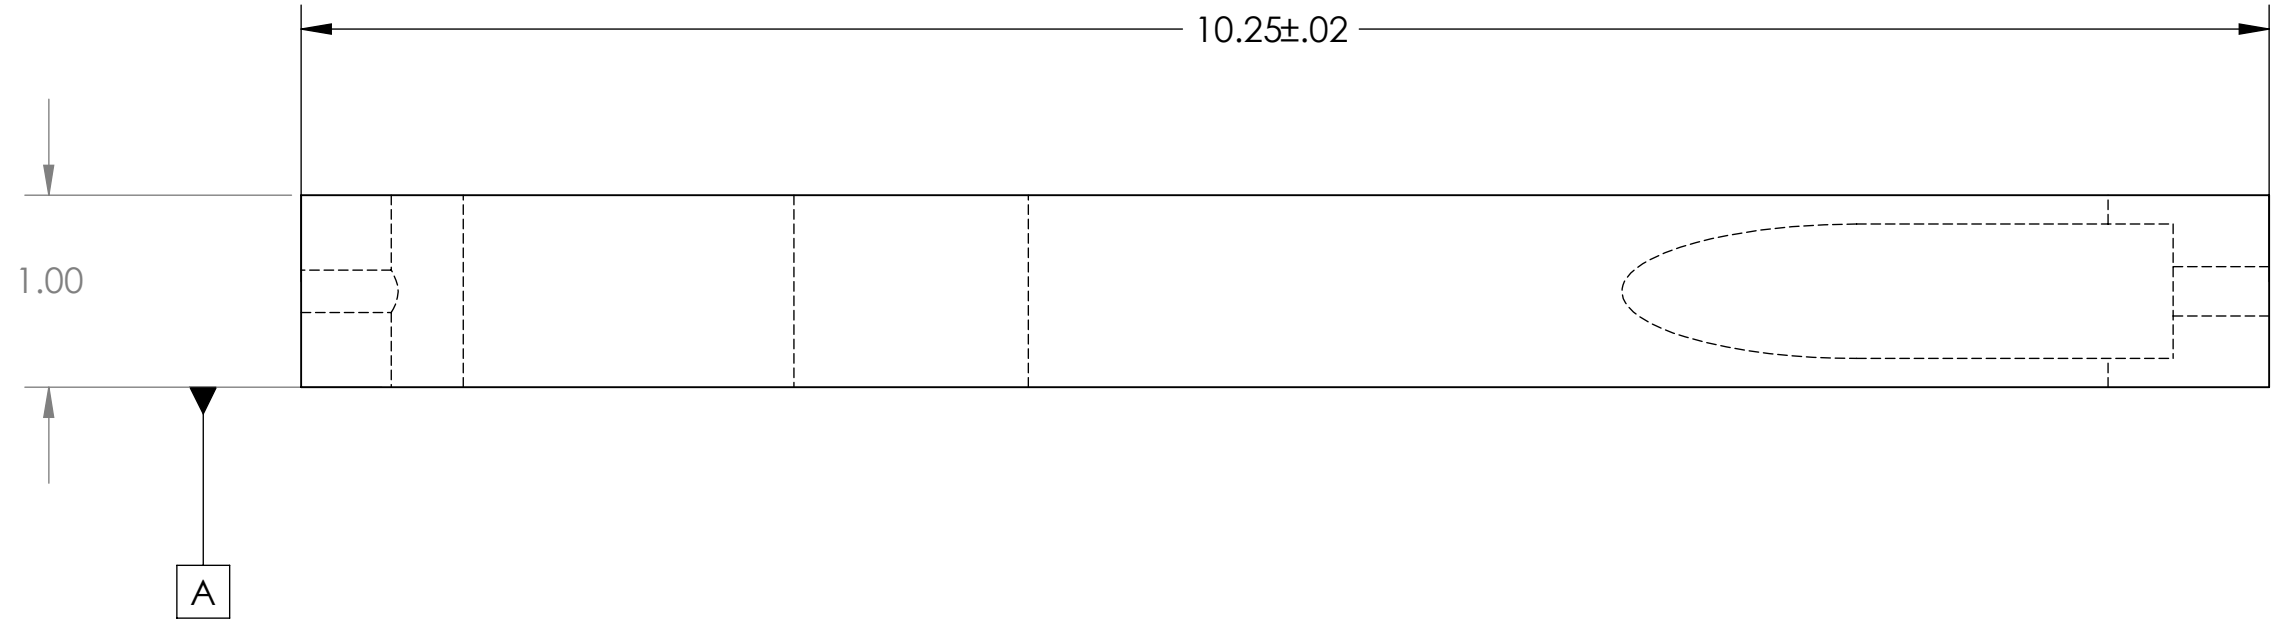


NOTES: UNLESS SPECIFIED OTHERWISE

1. MATERIAL: UHMW POLYETHELENE
2. COLOR: WHITE
3. FINISH: NONE
4. SURFACE FINISH $\sqrt{125}$ MAX

5 INDICATED FEATURE HAS BEEN MODIFIED OR CHANGED SINCE PREVIOUS REVISION

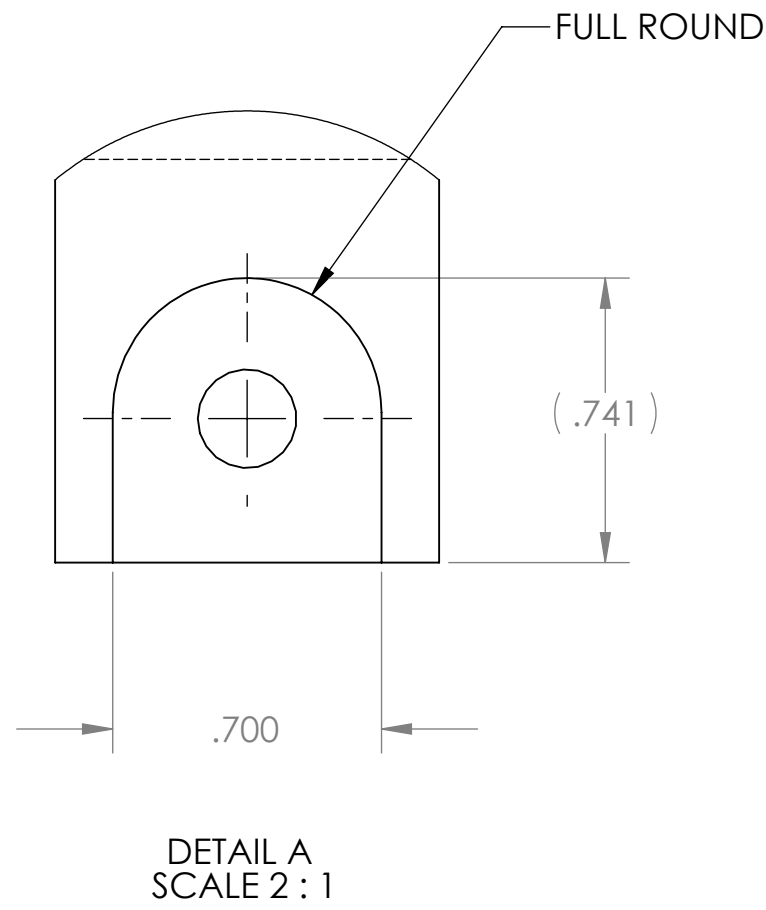

PROPRIETARY AND CONFIDENTIAL THE INFORMATION CONTAINED IN THIS DRAWING IS THE SOLE PROPERTY OF SANTA CLARA UNIVERSITY. ANY REPRODUCTION IN PART OR AS A WHOLE WITHOUT THE WRITTEN PERMISSION OF SANTA CLARA UNIVERSITY IS PROHIBITED.	UNLESS OTHERWISE SPECIFIED: DIMENSIONS ARE IN INCHES TOLERANCES: ANGULAR: ± 1.0 LINEAR: XX ± 0.1 XXX ± 0.03 XXXX ± 0.010		NAME W. ANDERSON	DATE 9/8/2007	SANTA CLARA UNIVERSITY/MBARI	
	INTERPRET DRAWING PER: ASME Y14.100-2004		CHECKED ENG APPR. W. ANDERSON	10/30/07	TITLE:	
	MATERIAL SEE NOTES		COMMENTS: PROJECT NO: 900744.00		SIZE DWG. NO. D VPT-0004	REV 01
	FINISH SEE NOTES		SCALE: 1:1 WEIGHT:		SHEET 1 OF 1	