

4


3

2

1

NOTES:

REV	DESCRIPTION	BY	DATE	ZONE
A	PRODUCTION RELEASE	T.O.	7/98	
B1	DIM WAS 4 PLS @ 90°	G.H.	09.98	A4

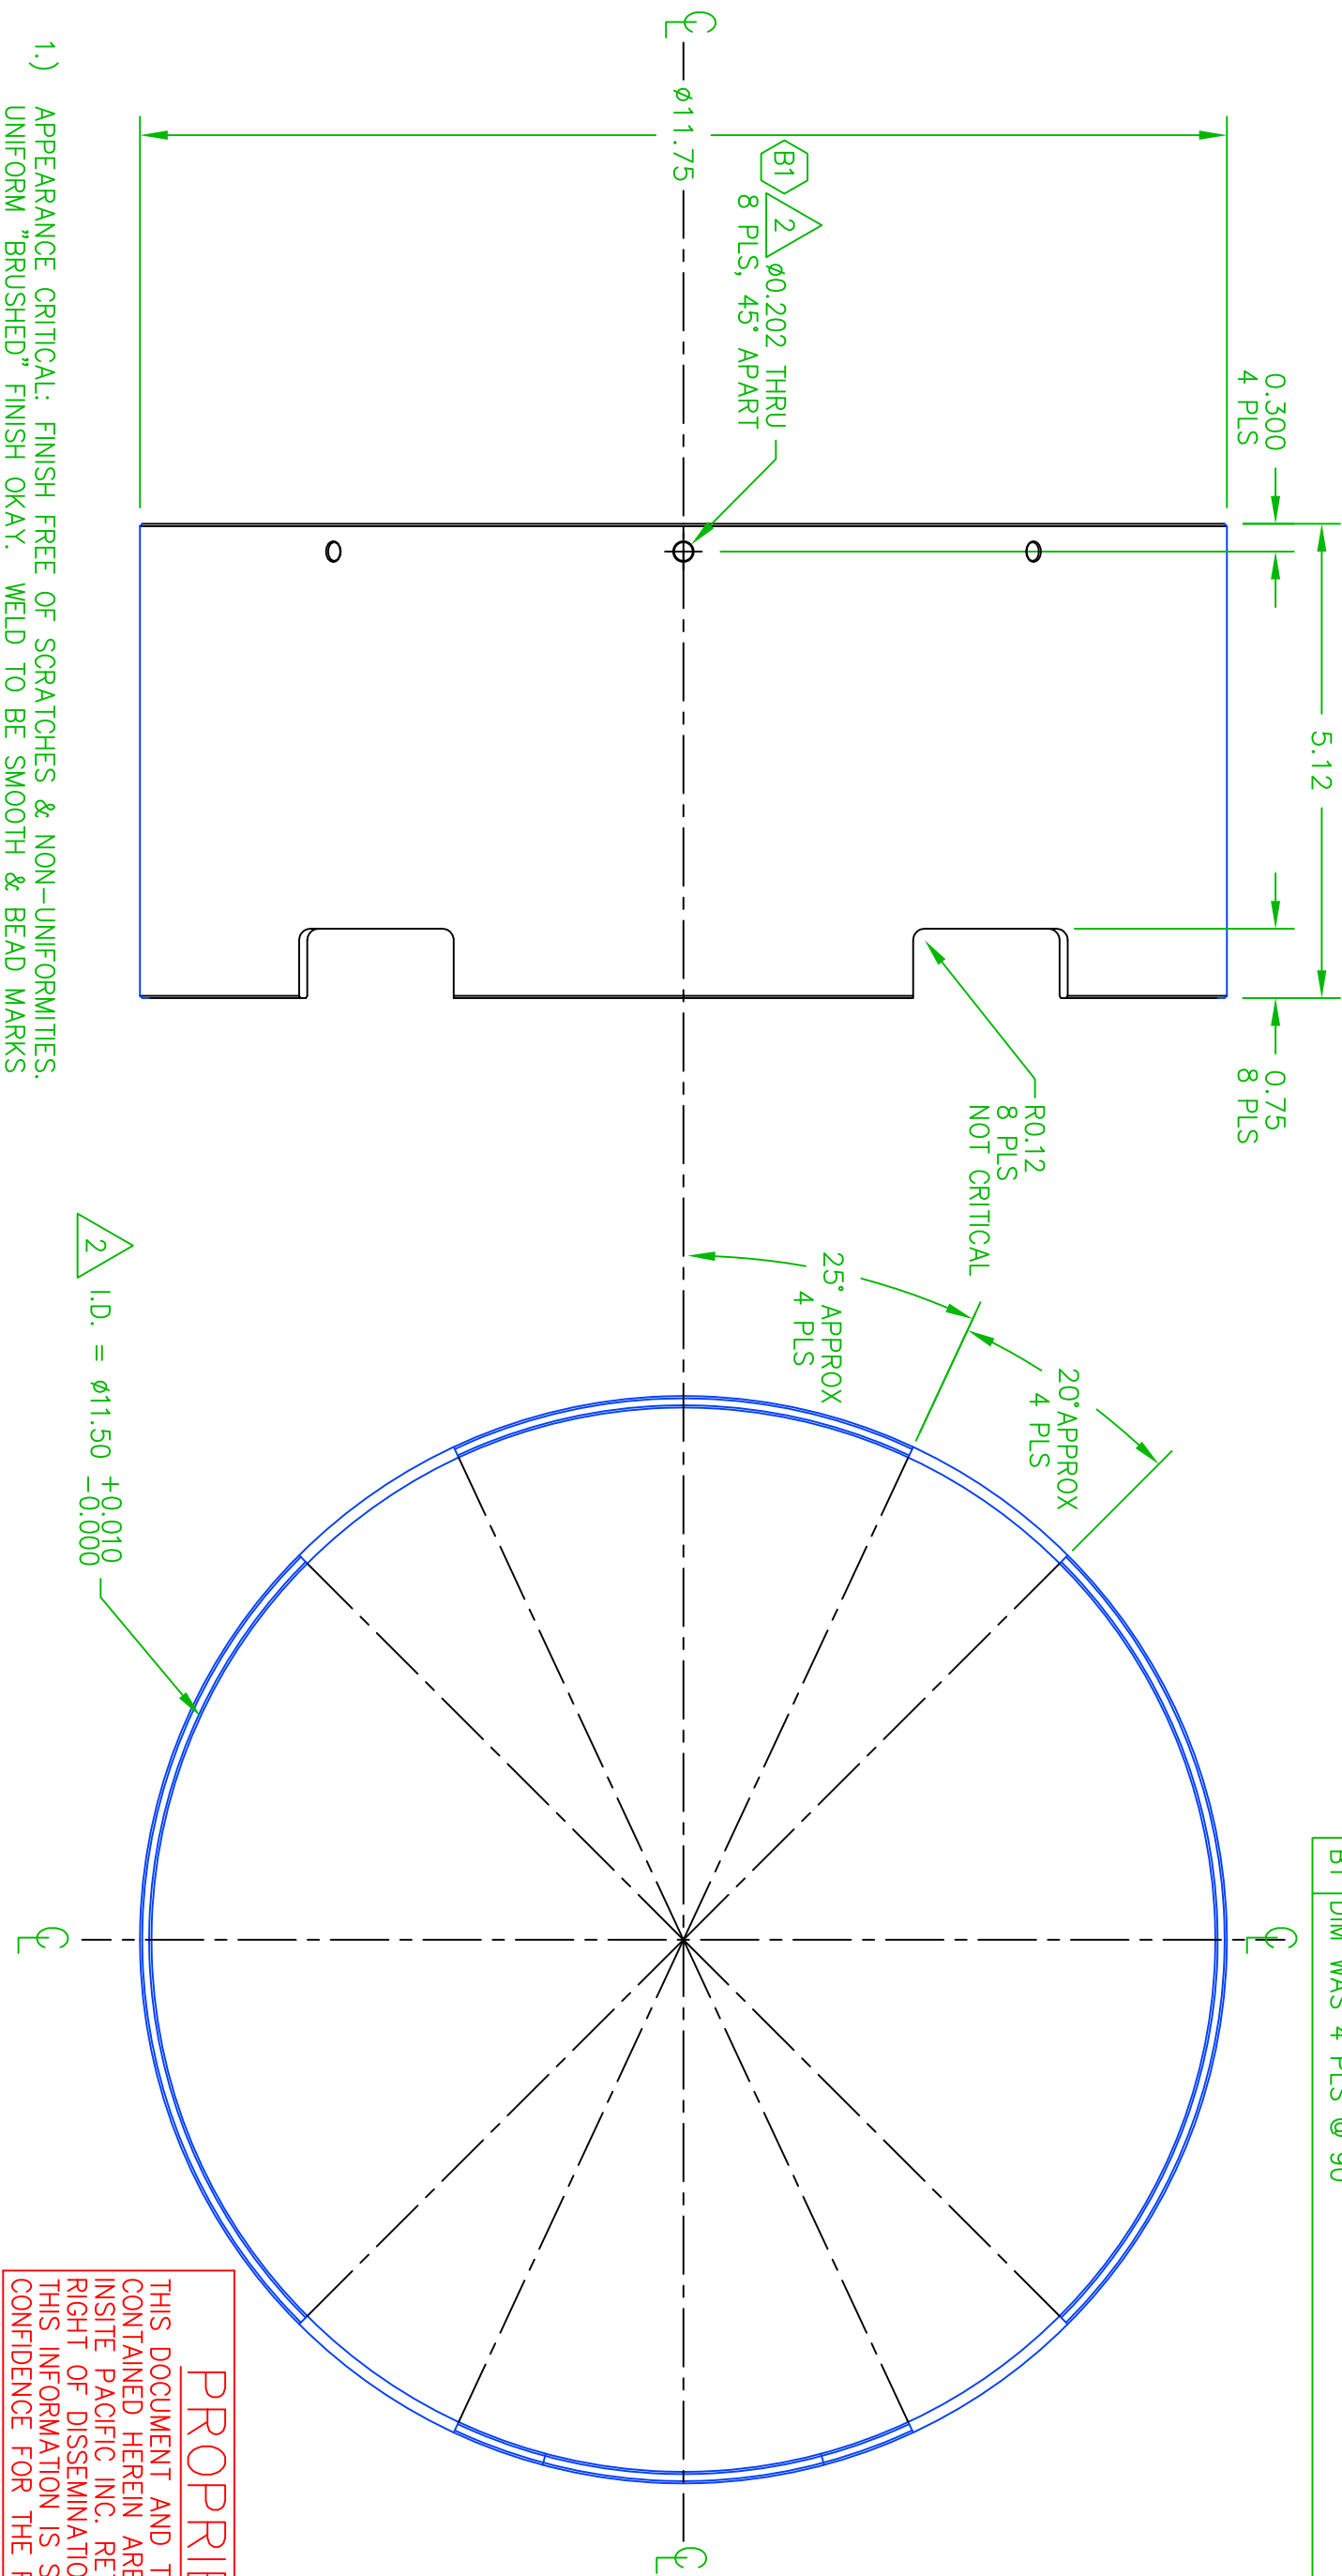

- 1.) APPEARANCE CRITICAL: FINISH FREE OF SCRATCHES & NON-UNIFORMITIES. UNIFORM "BRUSHED" FINISH OKAY. WELD TO BE SMOOTH & BEAD MARKS REMOVED FOR BEST APPEARANCE.
- 2.) MATES WITH ZS6-0218. USE THIS PART AS DRILL GUIDE FOR 8-32 HOLES.
- 3.) SANDBLAST BEFORE POWDER COAT.

UNLESS OTHERWISE SPECIFIED:

TOLERANCES:	SURFACE FINISH
.XX~	: ±.02
.XX	: ±.01
.XXX	: ±.005
HOLES	: ±.003
ANGULAR	: ±0.5°
FRACTIONAL	: ±1/64

QTY	1
PER	1
NEXT ASSEMBLY	ZS6-0200
USED ON	ZEUS 6K
APPLICATION	

MATERIAL	300 SERIES S/S (316 PREFERRED)
SPECIFICATION	1/8" SHEET
FINISH	NOTE 1, UNIFORM APPEARANCE
PLATING	BLACK POWDER COAT, 10-15 MILS, NOTE 3

ENG. G.H.	DRAW M.SPEARMAN	CHECKED	APPROVED
SIZE	DRAWING NO.	DATE	REV
B	ZS6-0219	3/98	B

INSITE PACIFIC Inc

SOLANA BEACH * CALIFORNIA * U.S.A. * TEL: 858-523-0642

PROPRIETARY

THIS DOCUMENT AND THE SUBJECT MATTER CONTAINED HEREIN ARE PROPRIETARY. INSITE PACIFIC INC. RETAINS THE EXCLUSIVE RIGHT OF DISSEMINATION AND REPRODUCTION. THIS INFORMATION IS SUBMITTED IN CONFIDENCE FOR THE RECIPIENT ALONE.

SHROUD

DOME PROTECTOR

ZS6-0219

SHEET 1

OF 2

4

3

2

1