

4

3

2


1

NOTES:



MATES WITH ZS6-0219. MATCH DIA. TO FIT ZS6-0219.

REV	DESCRIPTION	BY	DATE	ZONE
A	PRODUCTION RELEASE	T.O.	7/98	
B1	DIM WAS (4) 8-32 x 0.25	G.H.	09.98	C6
B2	DIM WAS 6.800 (TYP0)	G.H.	09.98	D5
C	WAS 0.325	G.H.	10/00	D6

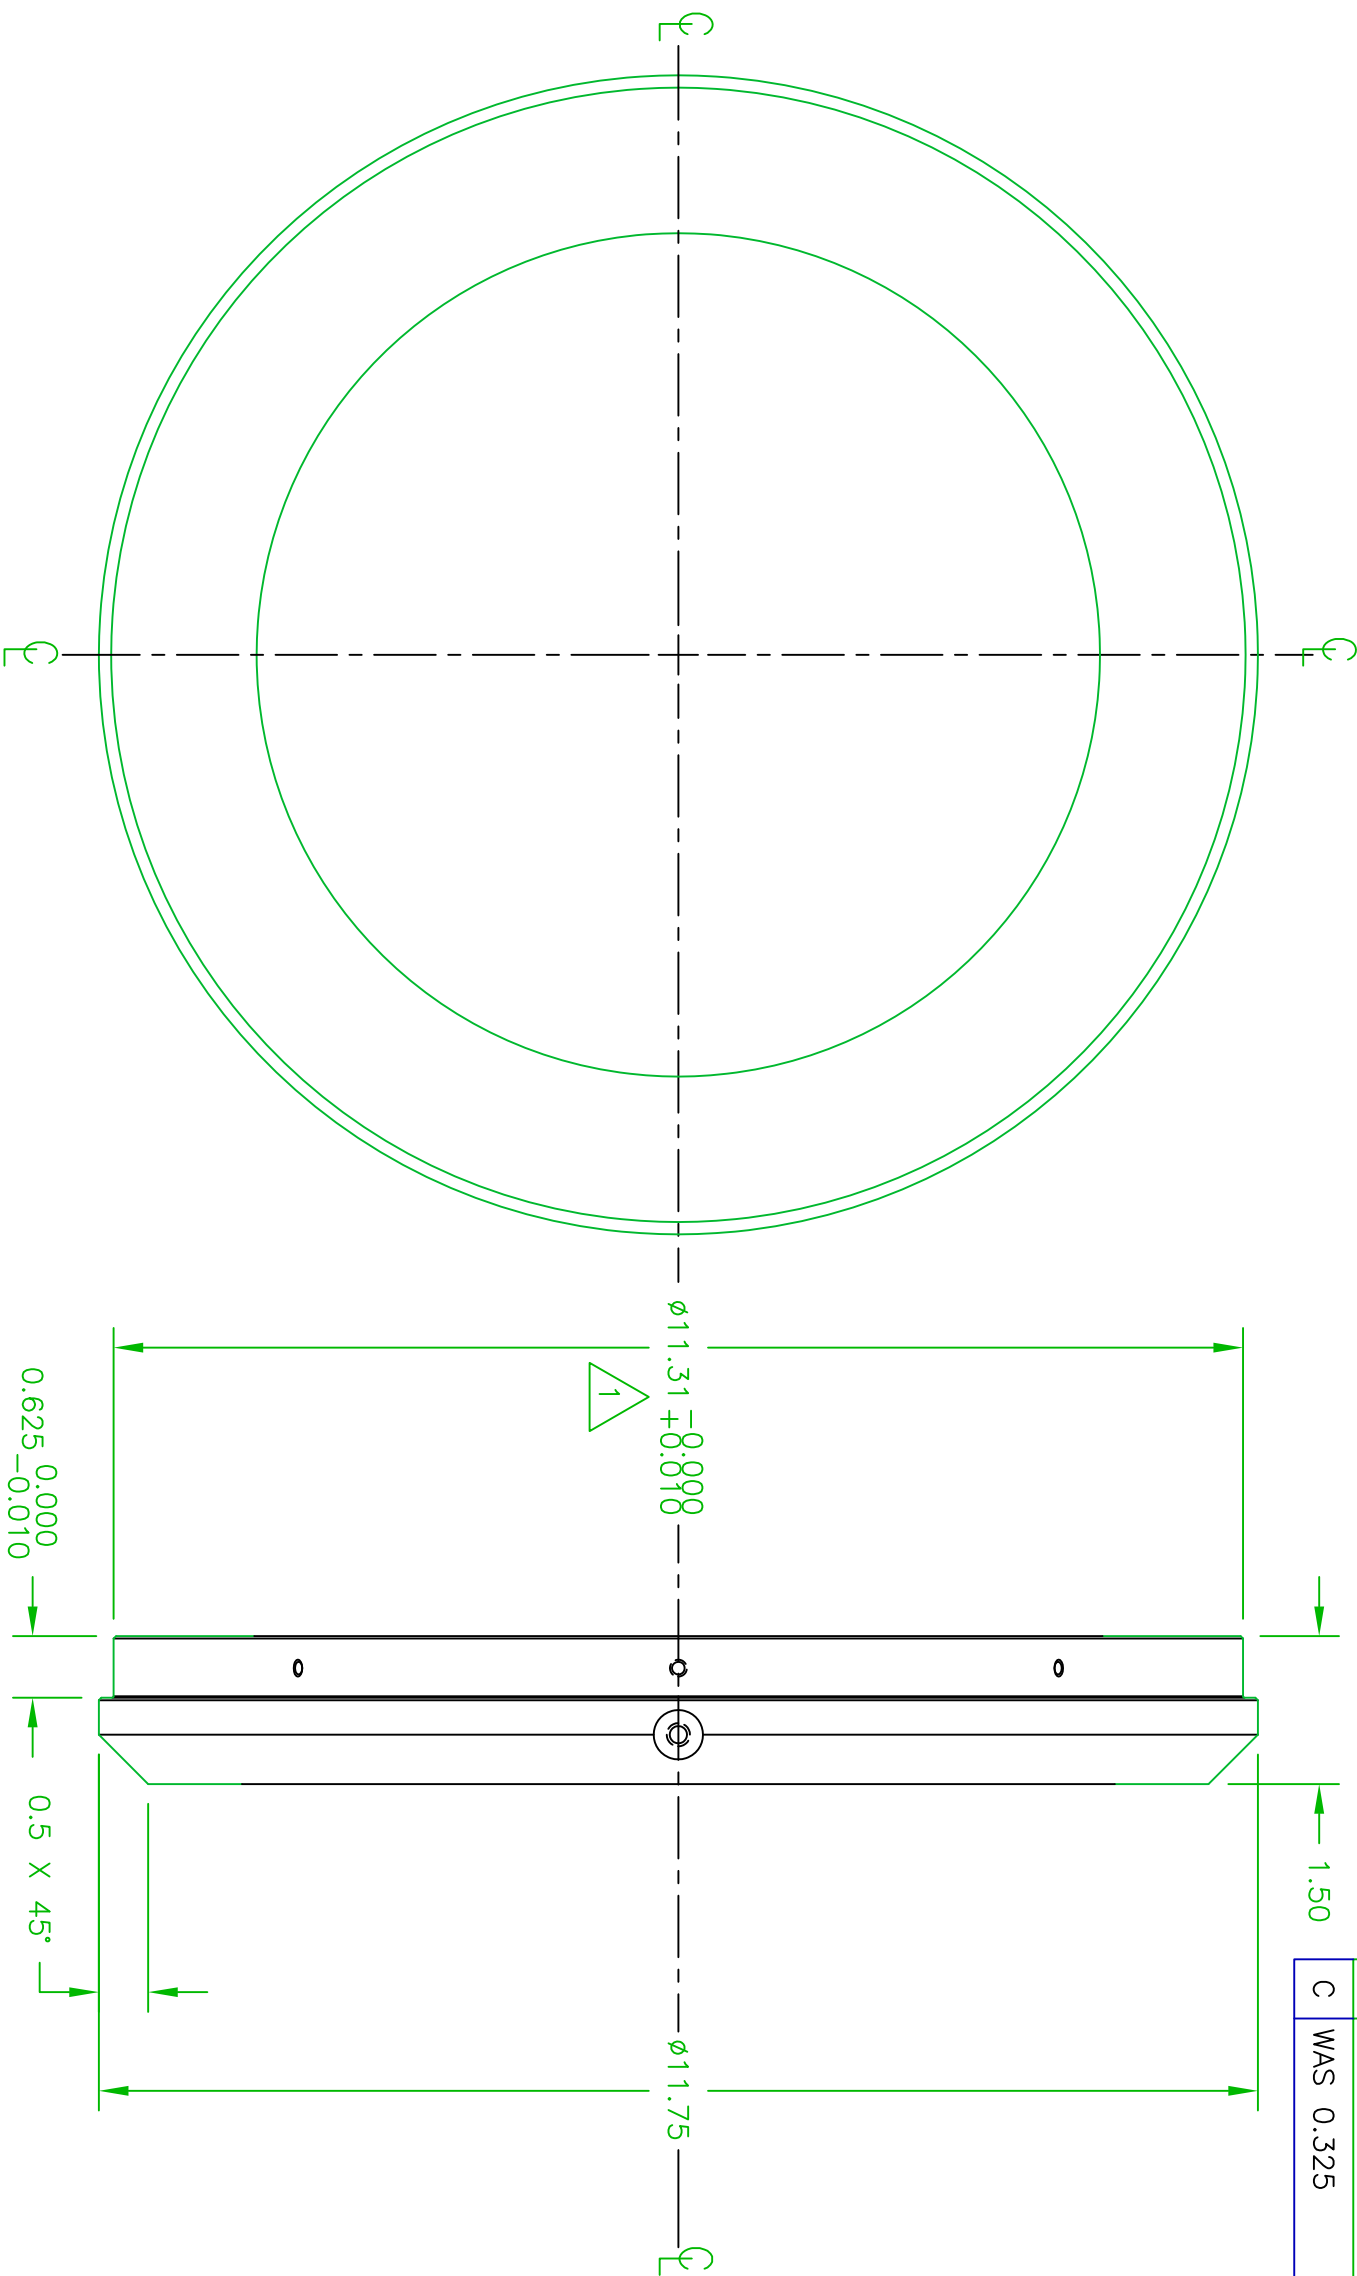

PROPRIETARY

THIS DOCUMENT AND THE SUBJECT MATTER CONTAINED HEREIN ARE PROPRIETARY. INSITE PACIFIC INC. RETAINS THE EXCLUSIVE RIGHT OF DISSEMINATION AND REPRODUCTION. THIS INFORMATION IS SUBMITTED IN CONFIDENCE FOR THE RECIPIENT ALONE.

INSITE PACIFIC Inc

SOLANA BEACH * CALIFORNIA * U.S.A. * TEL: 858-523-0642

UNLESS OTHERWISE SPECIFIED:

63

TOLERANCES:

.XX~ : ±.02
.XX : ±.01
.XXX : ±.005
HOLES : ±.003
ANGULAR : ±0.5°
FRACTIONAL : ±1/64

SURFACE FINISH



ALL DIMIENSIONS ARE IN INCHES (MM)

REMOVE ALL BURRS

BREAK ALL SHARP EDGES .02 - .03

DIMENSIONS APPLY BEFORE PLATING

DO NOT SCALE DRAWING

MATERIAL
ACETAL (DELFIN), BLACK

SPECIFICATION

1-1/2" PLATE

FINISH
UNIFORM APPEARANCE

PLATING

NONE

ENG.
G.H.

DRAW

M.SPEARMAN

CHECKED

APPROVED

SIZE
B

DRAWING NO.

DATE

7/98

MOUNTING BASE

DOME PROTECTOR

ZS6-0218

SCALE

1 = 1

SHEET

1

OF

2

REV

C

4

3

2

1