


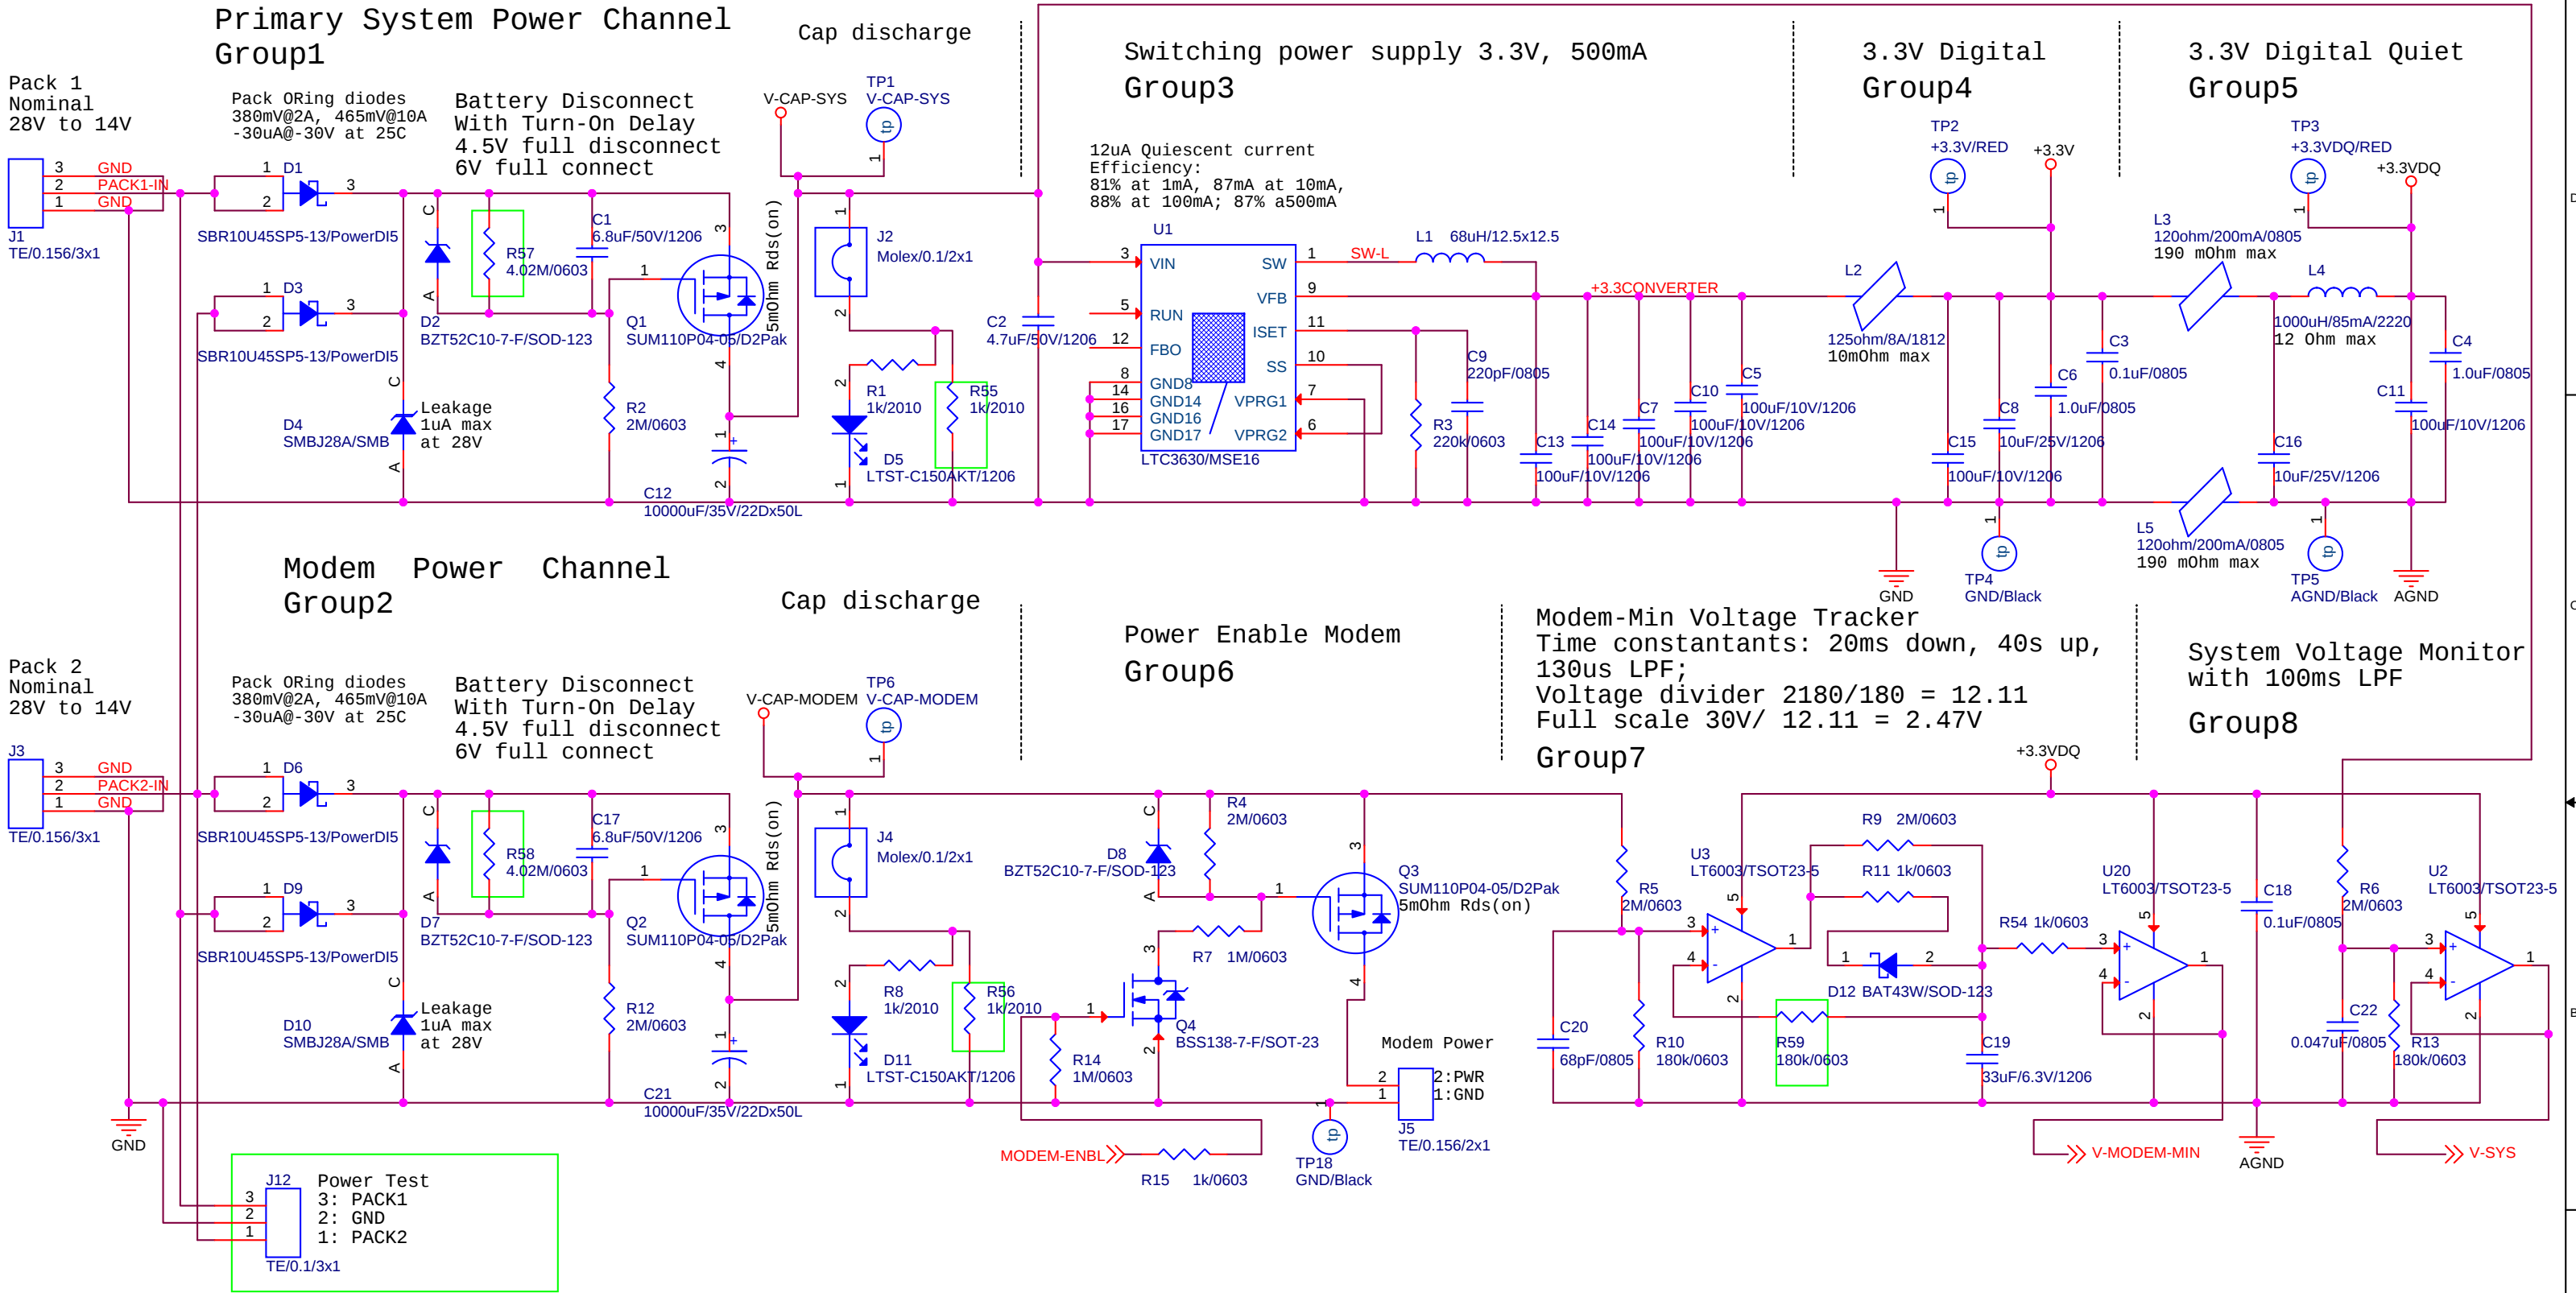


Rev0(01/24/2013): Initial Release
Rev1(05/07/2013): C1,C17(2.2uF to 6.8uF+4M), R2,R12(1M to 2M), R55,R56(1k, added), L3(1k to 120ohm), L5(600ohm to 120ohm), C11(10uF to 100uF), C19(10uF to 33uF), cont. Page2



MOB1 to MOB2 revision:
R55: 1k/2010 added
R56: 1k/2010 added
R57: 4.02M/0603 added
R58: 4.02M/0603 added
R59: 180k/0603 added
J12: Molex C-grid 3x1 added

		Monterey Bay Aquarium Research Institute 7700 Sandholdt Rd, Moss landing CA 95076	
Engineer Klimov		Page Title BEDS Mother Board/ Power	Project: 901006
Size B	Doc. or Part Number <Doc>	File Name (auto) 10020895-MOB3	Rev 0
Page Modify Date (auto): Design Modify Date (auto):		Friday, February 16, 2018 Friday, February 16, 2018	Sheet: 1 of 4
Full path (auto):			
ECTS\BEDS\10020895-MOB3\10020895-MOB3.DSN			


Group16
PPS/GPS: 5V 100ms active high
PPS/Clock: 3.3V 400us active high
5nS low pass filter

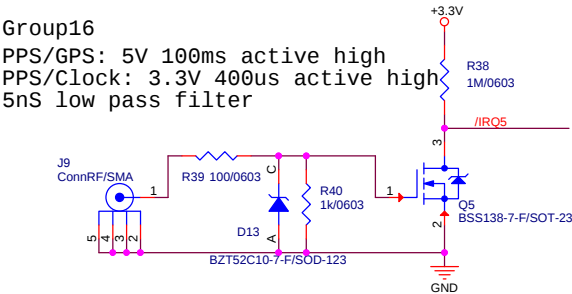



Group15 Persistor Board

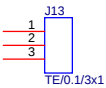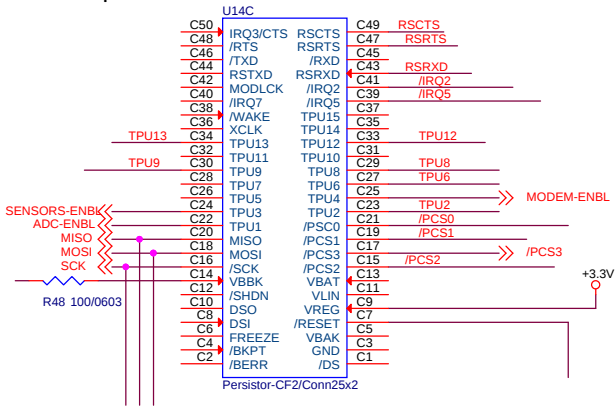


MPU-6050 With Power Enable
Group17

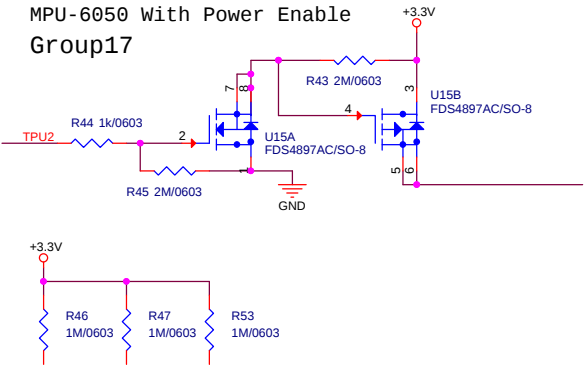

MOB1 to MOB2 revision:
J11: BU2032-1-ND-G added
R60: 100/0603 added
J13: TE 0.1/3x1 added
J14, R61, R62, R63, R64, R65, U21 added
Rev2 (cont. from Page2): Install J11 (BU2032)
instead of J10 (Keystone/3003)

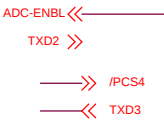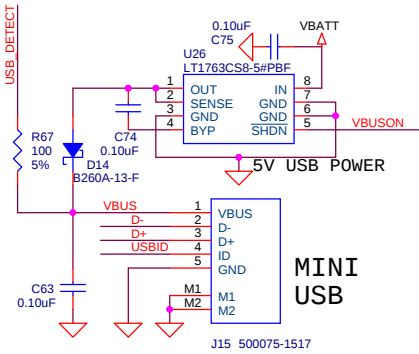

Title			
<Title>			
Size	Document Number	Rev	
C	<Doc>	<RevCode>	
Date:	Friday, February 16, 2018	Sheet	1 of 1

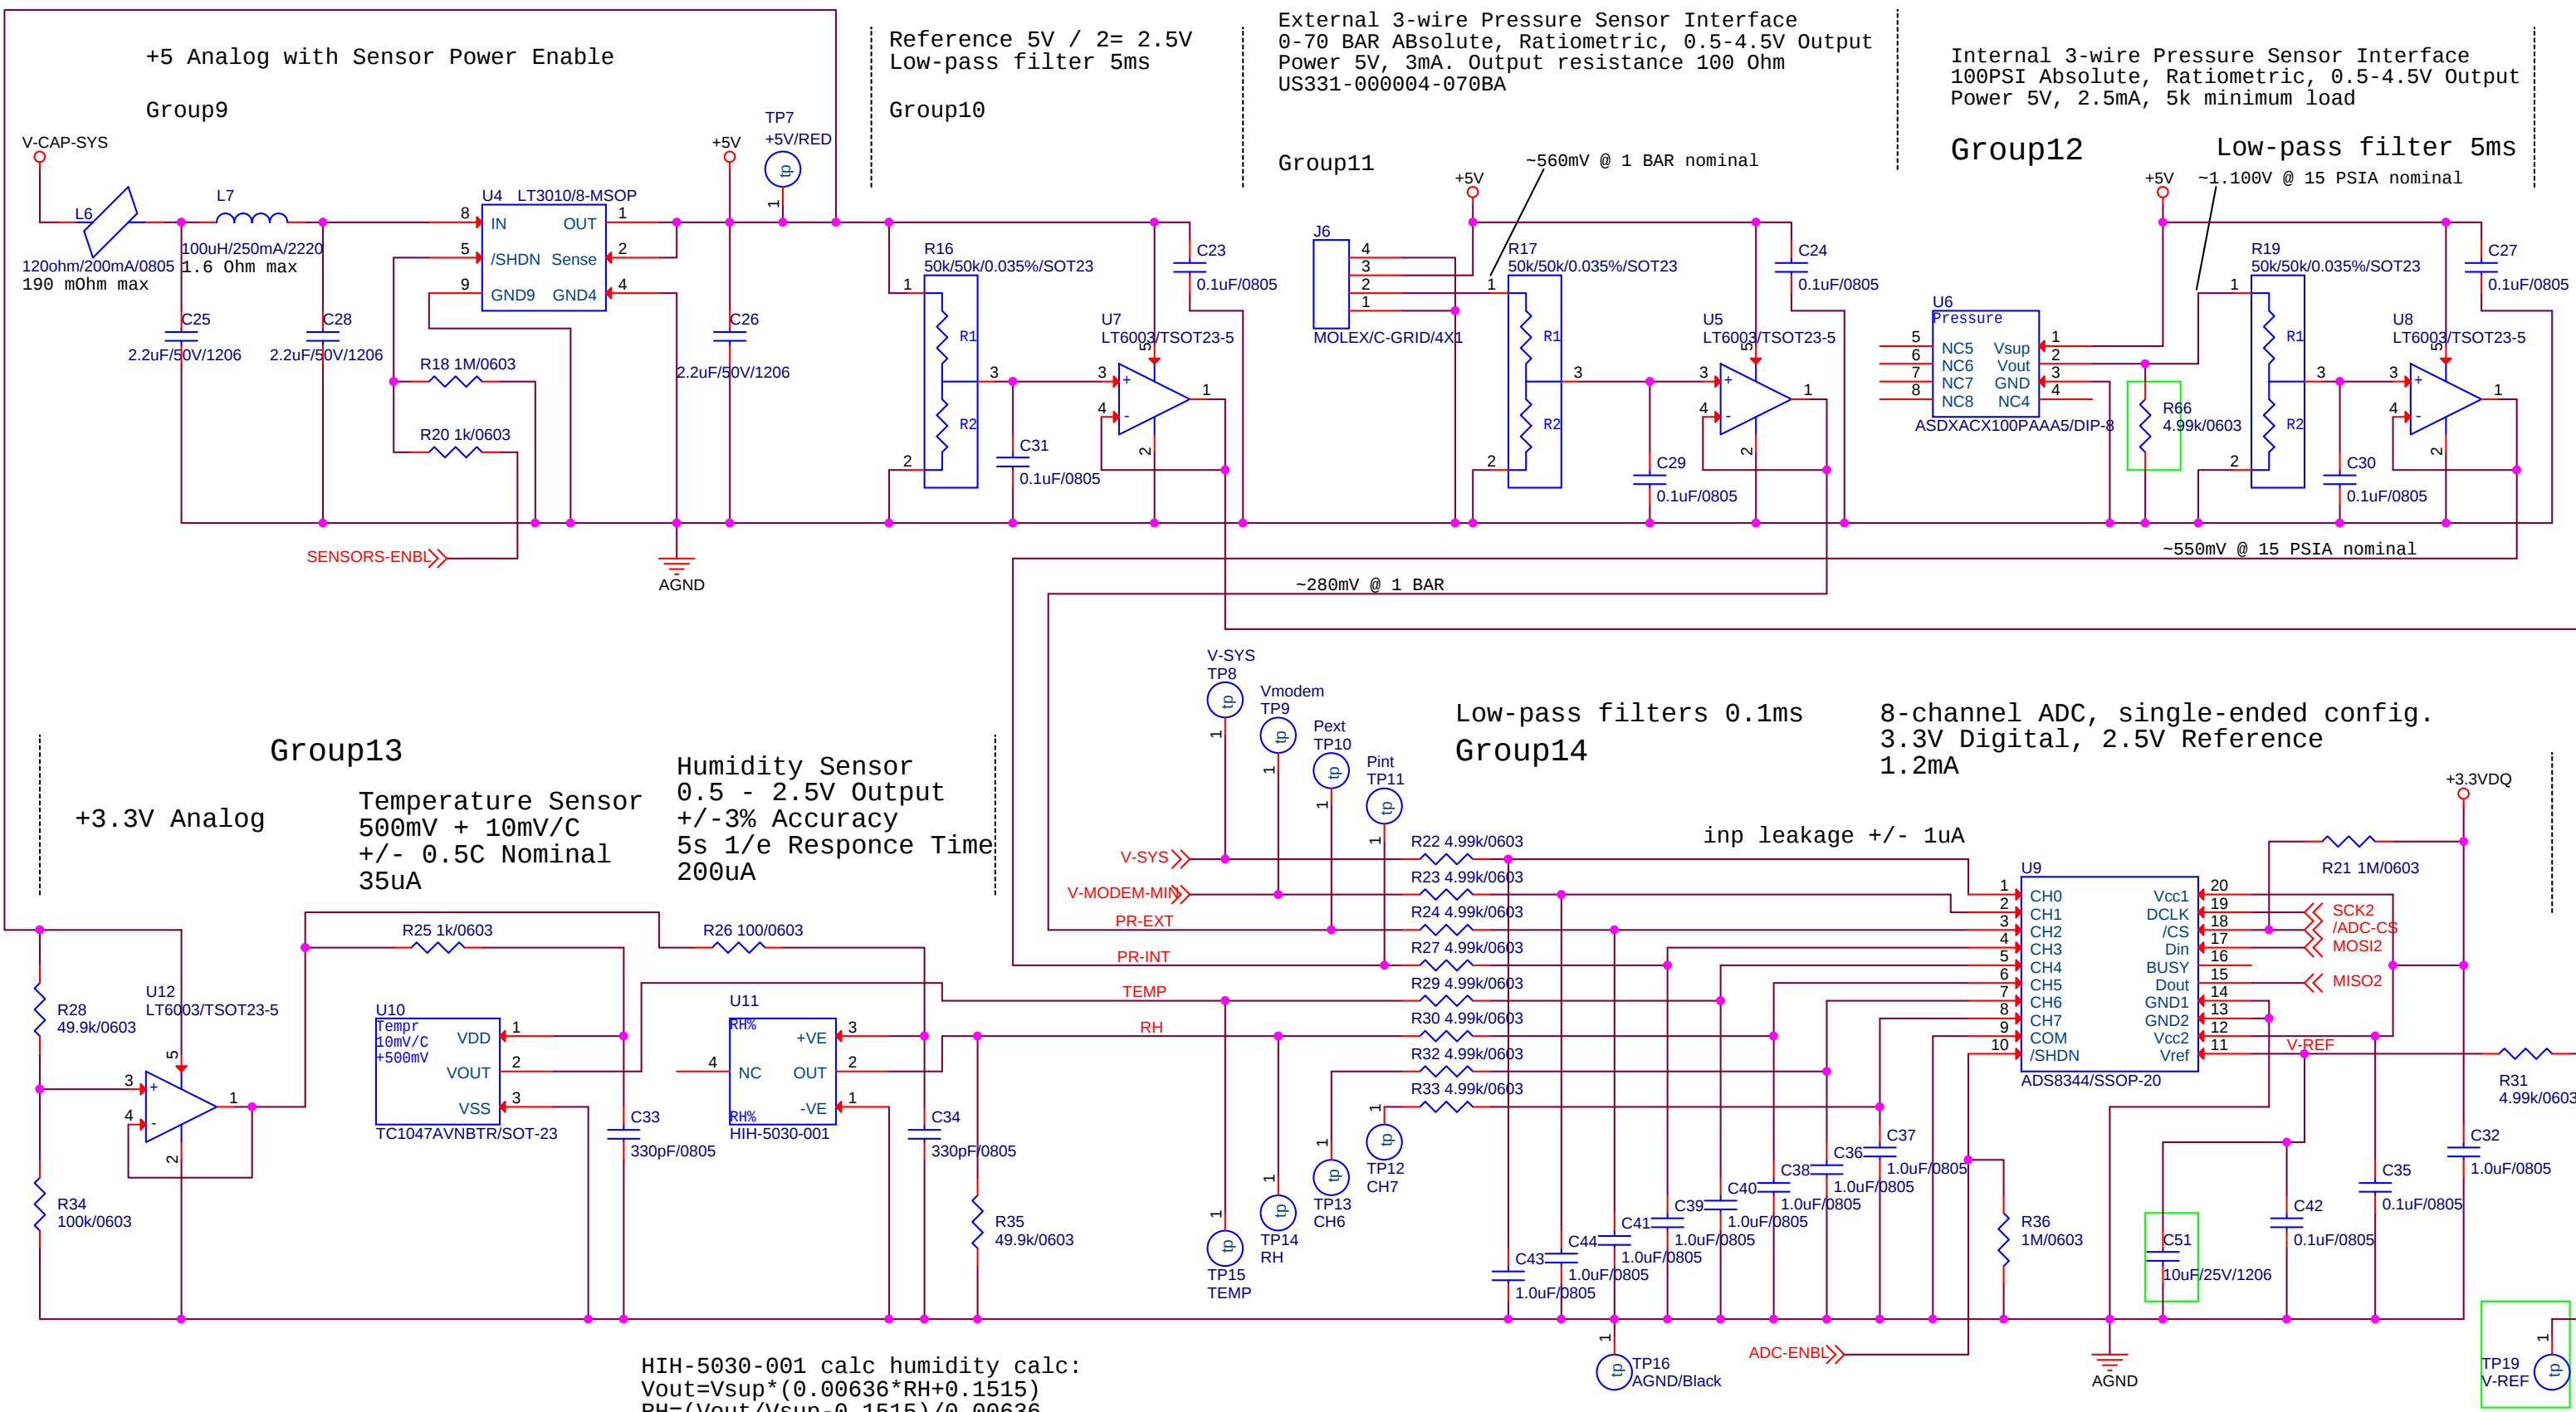


HIH-5030-001 calc humidity calc:
Vout=Vsup*(0.00636*RH+0.1515)
RH=(Vout/Vsup-0.1515)/0.00636

MOB1 to MOB2 revision:
C51: 10uF/25V/1206 added
TP19: V-REF added
R66: 4.99k/0603 added



Rev2 (cont. from Page1): L6(1k/200mA to 120ohm/200mA), R25(100 to 1k),
C33,C34(0.1uF to 330pF), R22-R33(1k to 5k), C37-C41,C43,C44(0.1uF to
1.0uF), C42(0.1uF to 0.1uF+10uF), R31(1k to 5k), cont. to Page3

		Monterey Bay Aquarium Research Institute 7700 Sandholdt Rd, Moss landing CA 95076	
Engineer Klimov		Project: see page 1	
Size B		Rev see page 1	
Document Number see page 1		File Name (auto) 10020895-MOB3	
Page Modify Date (auto): Friday, February 16, 2018		Sheet: 2 of 4	
Design Modify Date (auto): Friday, February 16, 2018		Full path (auto): U:\ORCAD PROJECTS\BEDS\10020895-MOB3\10020895-MOB3.DSN	


Test Points

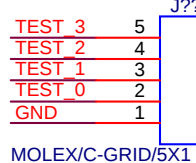

Test Points



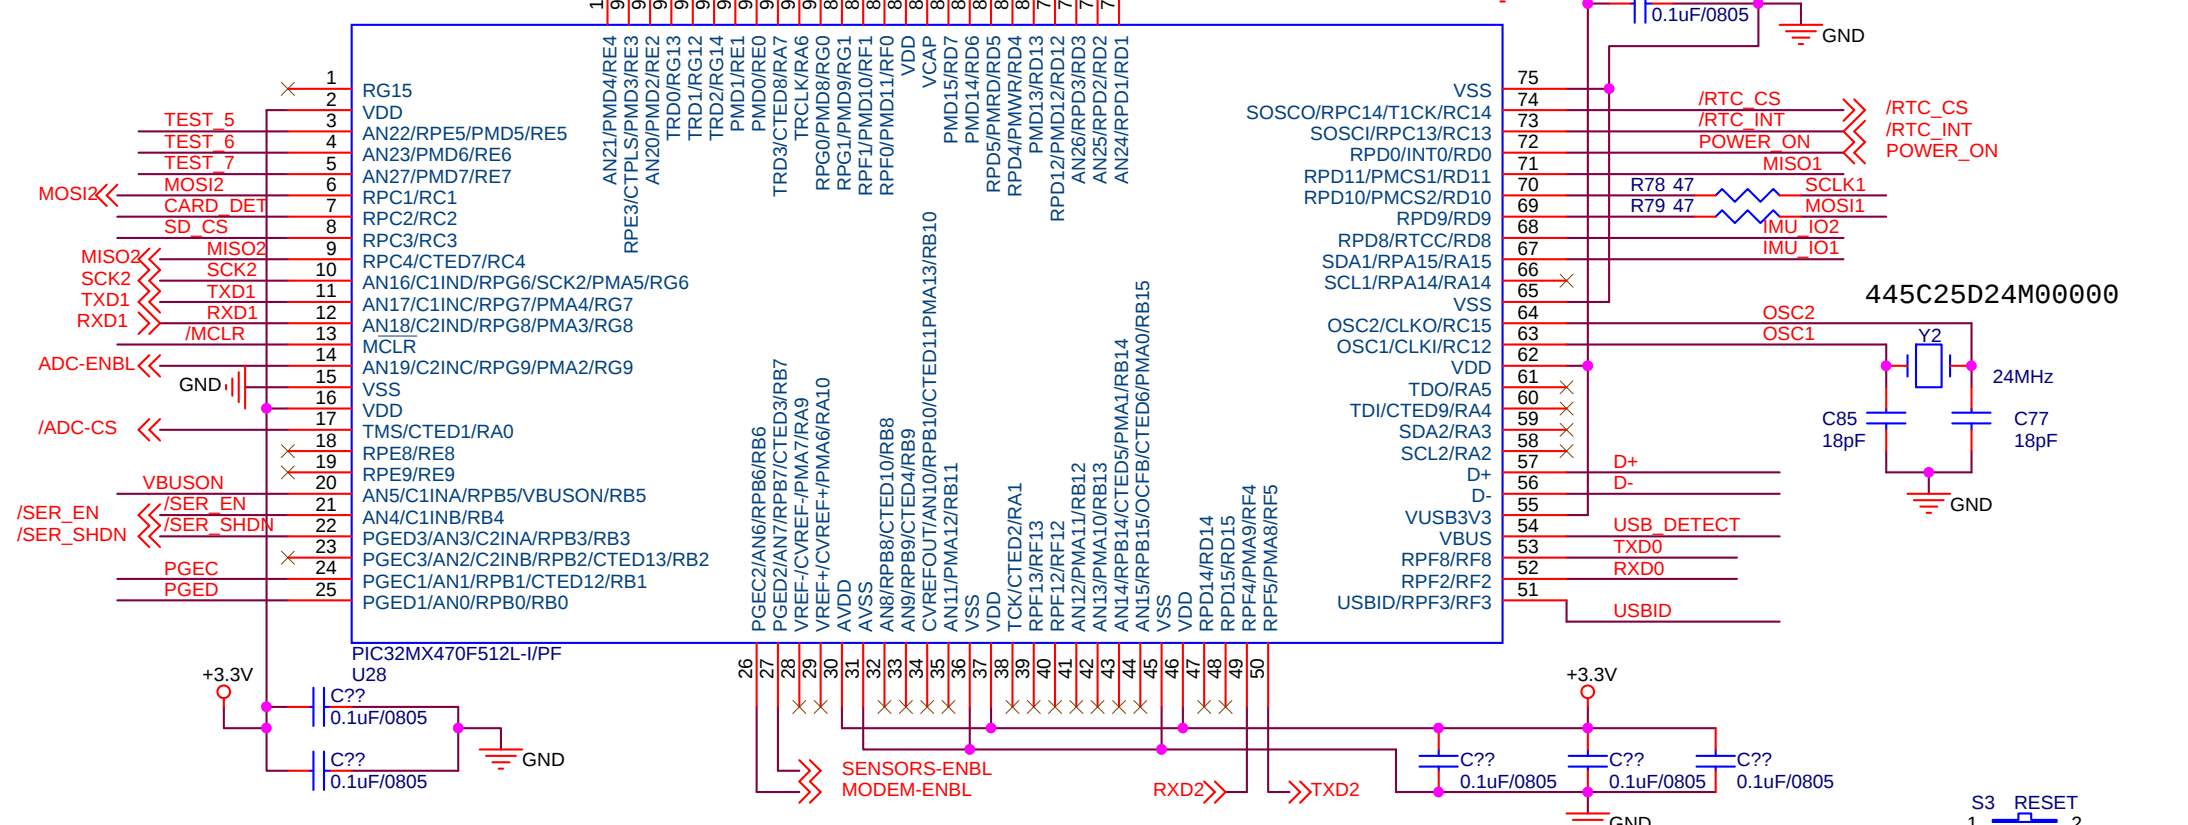
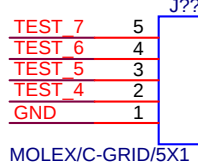


Micro SD Card

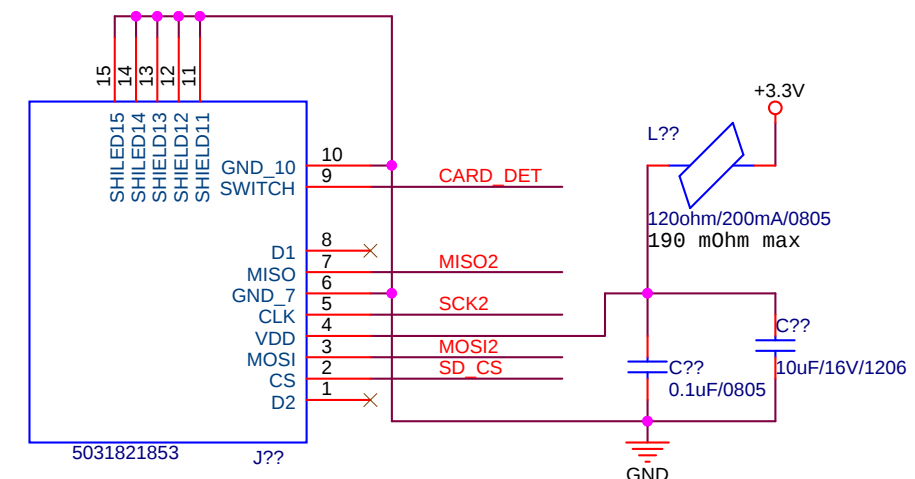


18123D106KAT2A



Serial Port Controller 0.3mA; 1uA in shutdown Group19

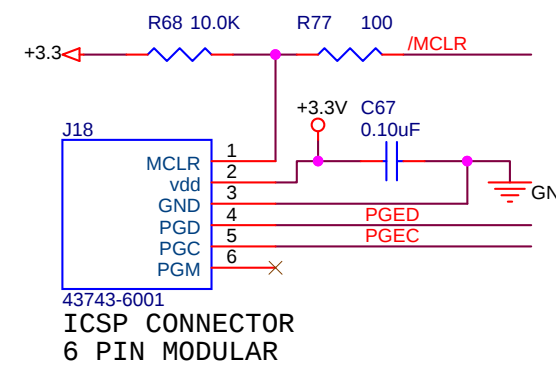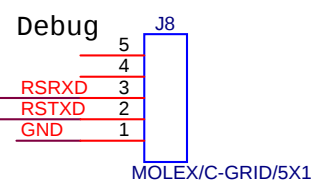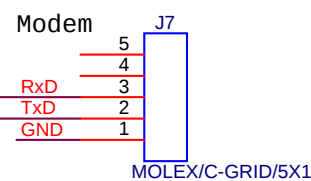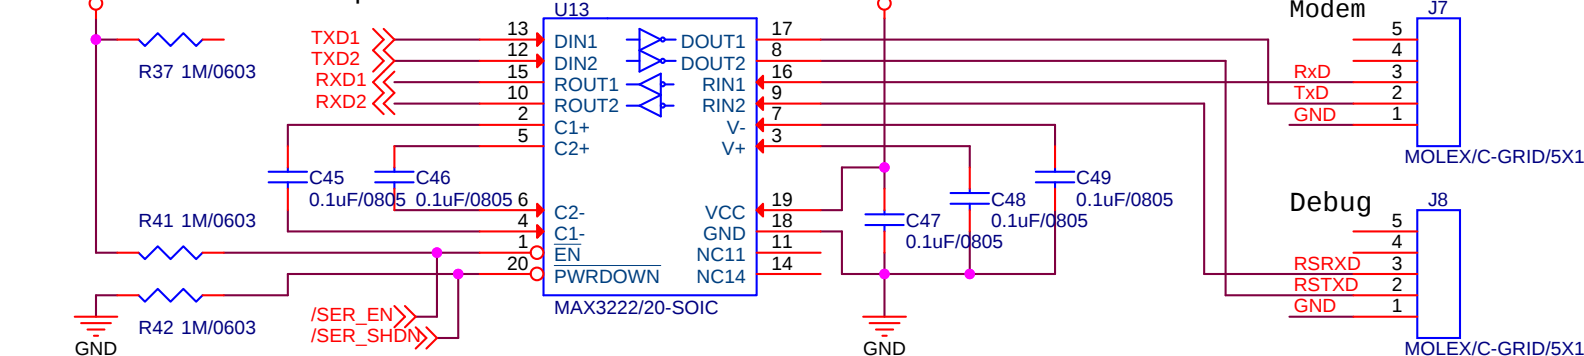

Reset circuitry using Release Enable 3.3V active, 50mS low pass filter

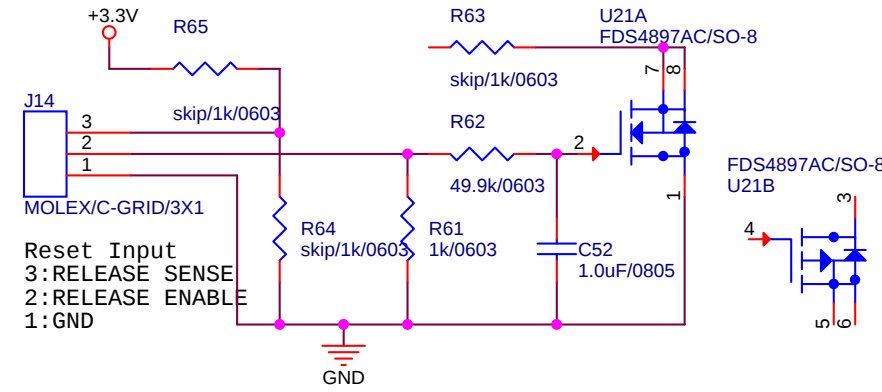

SPI Bus RTC with Integrated Crystal and SRAM 400uA active, 120uA standby

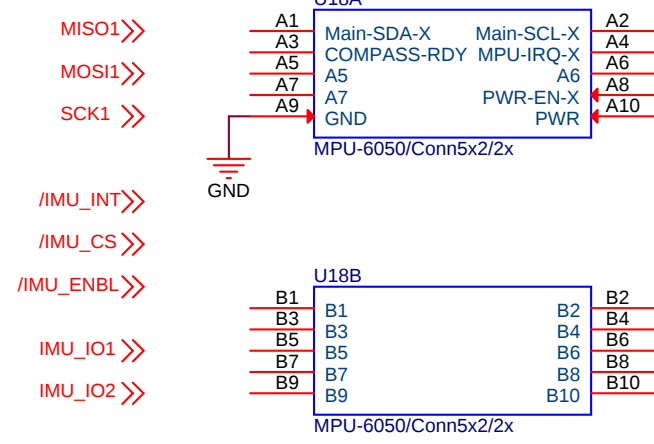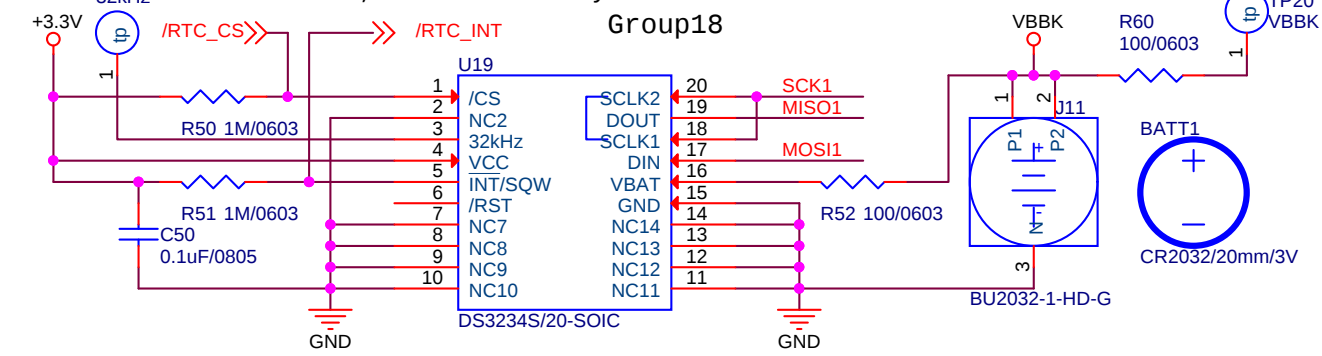

		Monterey Bay Aquarium Research Institute 7700 Sandholdt Rd, Moss landing CA 95076	
Engineer Klimov 831-775-1914		Page Title BEDS Mother Board/ Persistor	Project: <i>see page 1</i>
Size B	Document Number <i>see page 1</i>	File Name (auto) 10020895-MOB3	Rev <i>see page 1</i>
Page Modify Date (auto): Friday, February 16, 2018		Sheet: 3 of 4	
Design Modify Date (auto): Friday, February 16, 2018			
Full path (auto): PROJECTS\BEDS\10020895-MOB3\10020895-MOB3.DSN			

Bring-up Checklist

Fully assembled Mother Board, no Persistor Board, no MPU-6050 board. Set power supply to 12V, power up.

- 0. Connect jumpers to J2 and J4, verify LEDs light up, record PS current with and without LEDs running
- 1. Check voltage level and noise on 3.3V (TP2) with test load on 3.3V, 100mA (33 Ohm) and 200mA (16 Ohm)
- 2. Check voltage level and noise on 3.3VDQ (TP3) with 100mA (33 Ohm) test load on 3.3V power
- 3. Check operation of Modem_Enable with 5 Ohm 50W test load in J5 (2.3A).
- 4. Measure V-CAP-MODEM (TP6), voltage at J5.2, and difference between them (<50mV)
- 5. Check V-SYS (TP8) and V-MODEM-MIN (TP9) trackers with Modem-ENBL cycling and 5 Ohm 50W test load in J5
- 6. Check operation of SENSOR-ENBL and measure 5V (TP7) value and noise.
- 7. Check operation of TPU6 (U14.C27) and voltage on U18.A10

Sensors

- 8. External pressure sensor. Check voltages on J6.3, J6.2, and TP10
- 9. Internal Pressure sensor. Check voltages on U6.1, U6.2, TP11
- 10. Temperature sensor. Check voltage on U10.1 (3.3V) and TP15
- 11. Humidity sensor. Check voltage on U11.3 (3.3V) and TP14.

Plug test Persistor board and run AD Test.
Record values on channels:

- 0:
- 1:
- 2:
- 3:
- 4:
- 5:

		Monterey Bay Aquarium Research Institute 7700 Sandholdt Rd, Moss landing CA 95076	
Engineer Klimov		831-775-1914	Project: see page 1
Size B		Document Number see page 1	Rev see page 1
Page Modify Date (auto): Design Modify Date (auto):		Friday, February 16, 2018 Friday, February 16, 2018	Sheet: 4 of 4
Full path (auto): U:\ORCAD PROJECTS\BEDS\10020895-MOB3\10020895-MOB3.DSN			