


THE INFORMATION CONTAINED IN THIS DRAWING IS THE SOLE PROPERTY OF MBARI ANY REPRODUCTION IN PART OR WHOLE WITHOUT THE WRITTEN PERMISSION OF MBARI IS PROHIBITED.

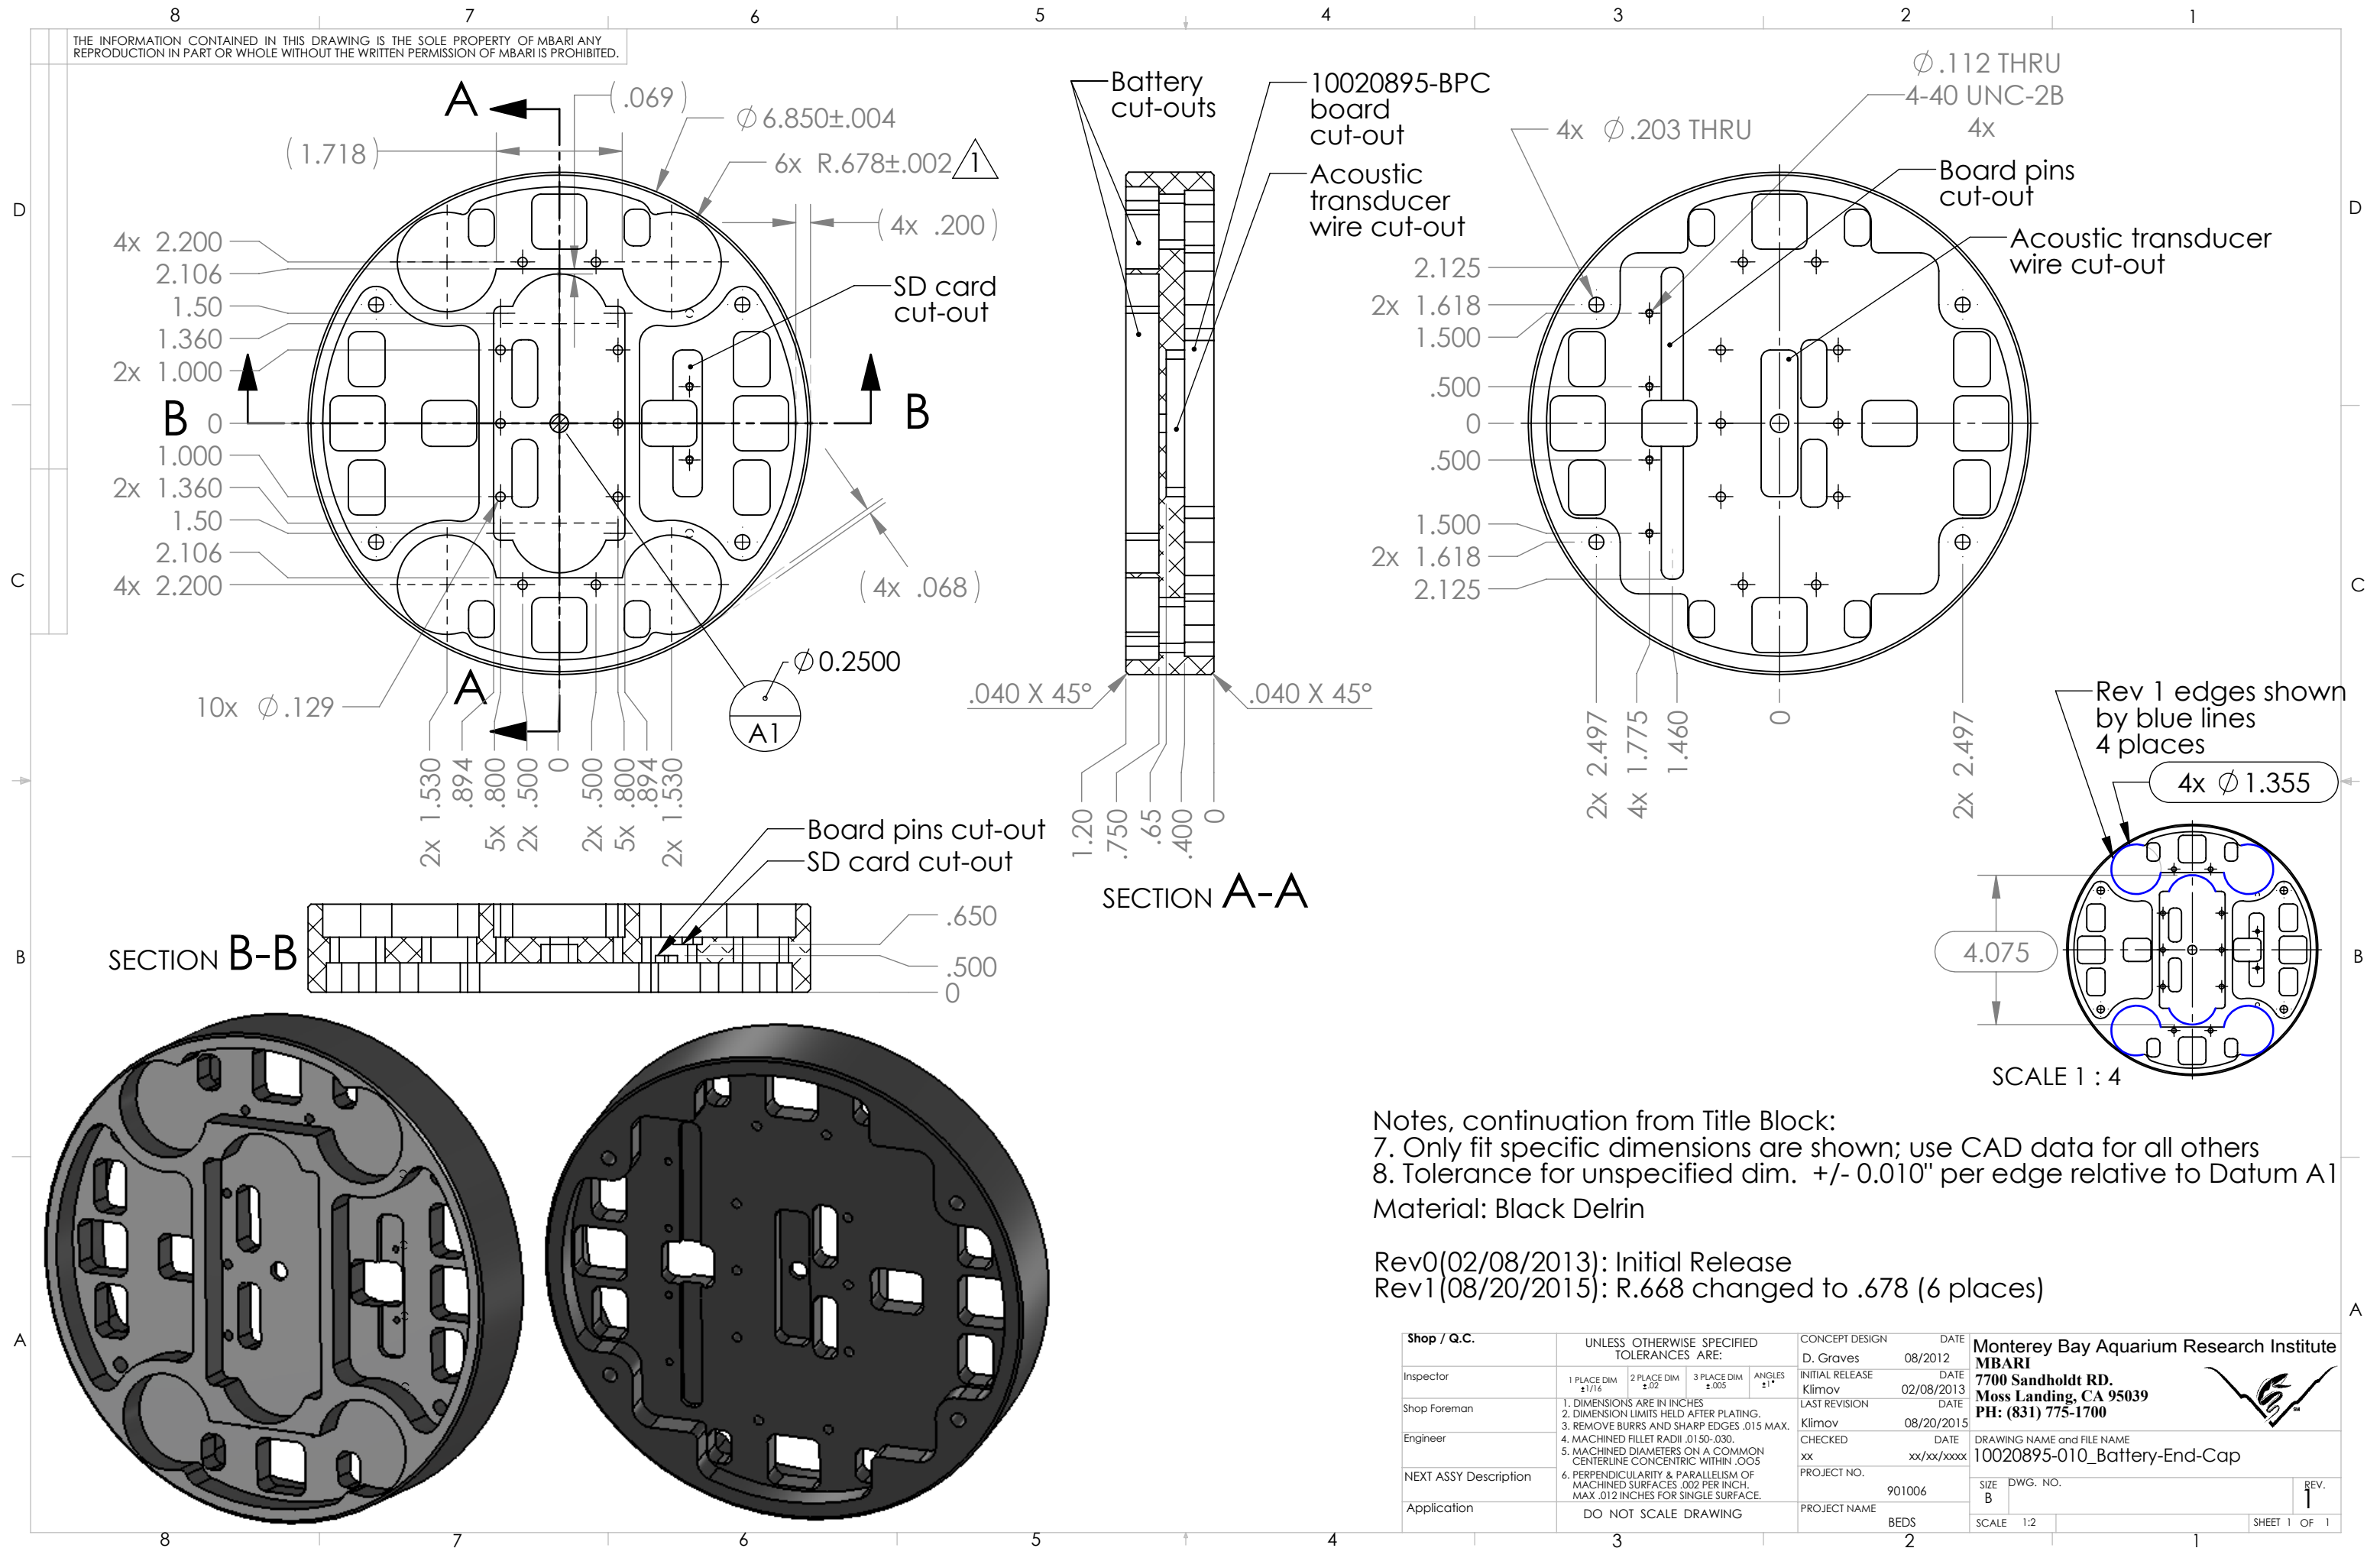

Notes, continuation from Title Block:
 7. Only fit specific dimensions are shown; use CAD data for all others
 8. Tolerance for unspecified dim. ± 0.010 " per edge relative to Datum A1
 Material: Black Delrin

Rev0(02/08/2013): Initial Release
Rev1(08/20/2015): R.668 changed to .678 (6 places)

Shop / Q.C.		UNLESS OTHERWISE SPECIFIED TOLERANCES ARE:				CONCEPT DESIGN D. Graves 08/2012		DATE		Monterey Bay Aquarium Research Institute MBARI				
Inspector	1 PLACE DIM ±.176	2 PLACE DIM ±.02	3 PLACE DIM ±.005	ANGLES ±.1°	INITIAL RELEASE Klimov 02/08/2013	DATE		7700 Sandholdt RD. Moss Landing, CA 95039 PH: (831) 775-1700						
Shop Foreman	1. DIMENSIONS ARE IN INCHES 2. DIMENSION LINES HELD AFTER PLATING. 3. REMOVE BURRS AND SHARP EDGES .015 MAX. 4. MACHINED FILLET RADII .0150-.030. 5. MACHINED DIAMETERS ON A COMMON CENTERLINE CONCENTRIC WITHIN .005				LAST REVISION Klimov 08/20/2015	DATE								
Engineer					CHECKED xx	DATE xx/xx/xxxx		DRAWING NAME AND FILE NAME 10020895-010_Battery-End-Cap						
NEXT ASSY Description	6. PERPENDICULARITY & PARALLELISM OF MACHINED SURFACES .002 PER INCH. MAX .012 INCHES FOR SINGLE SURFACE.				PROJECT NO. 901006	SIZE B		DWG. NO.		REV. 1				
Application					DO NOT SCALE DRAWING				PROJECT NAME BEDS	SCALE 1:2		SHEET 1 OF 1		