
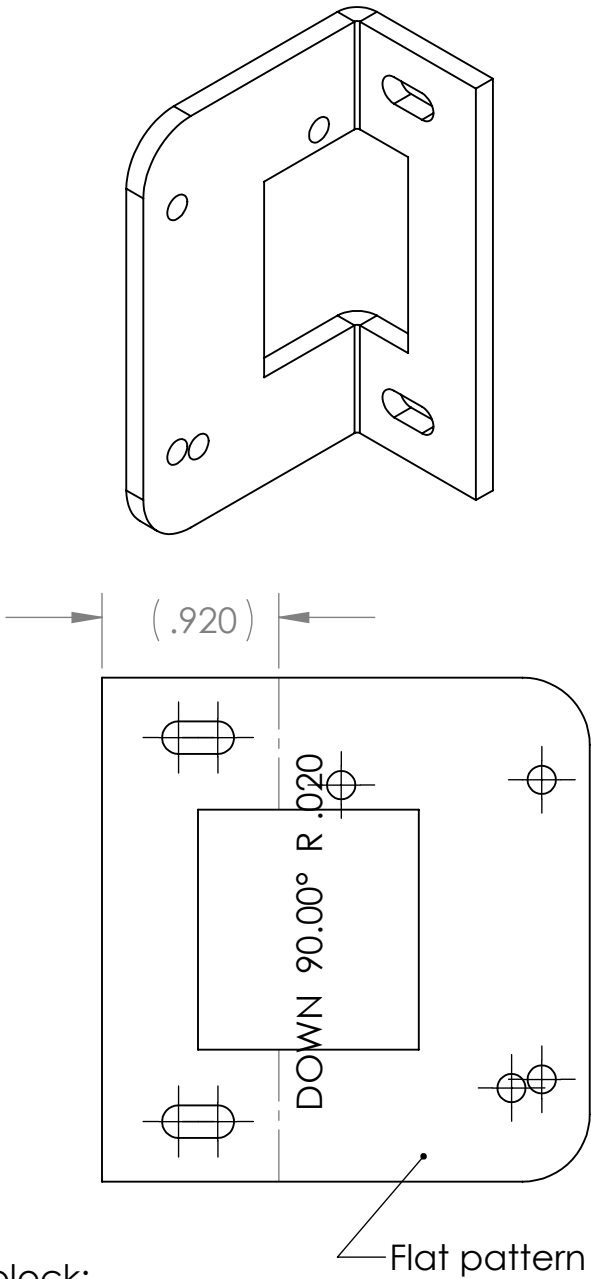


THE INFORMATION CONTAINED IN THIS DRAWING IS THE SOLE PROPERTY OF MBARI ANY REPRODUCTION IN PART OR WHOLE WITHOUT THE WRITTEN PERMISSION OF MBARI IS PROHIBITED.

D
C
B
A

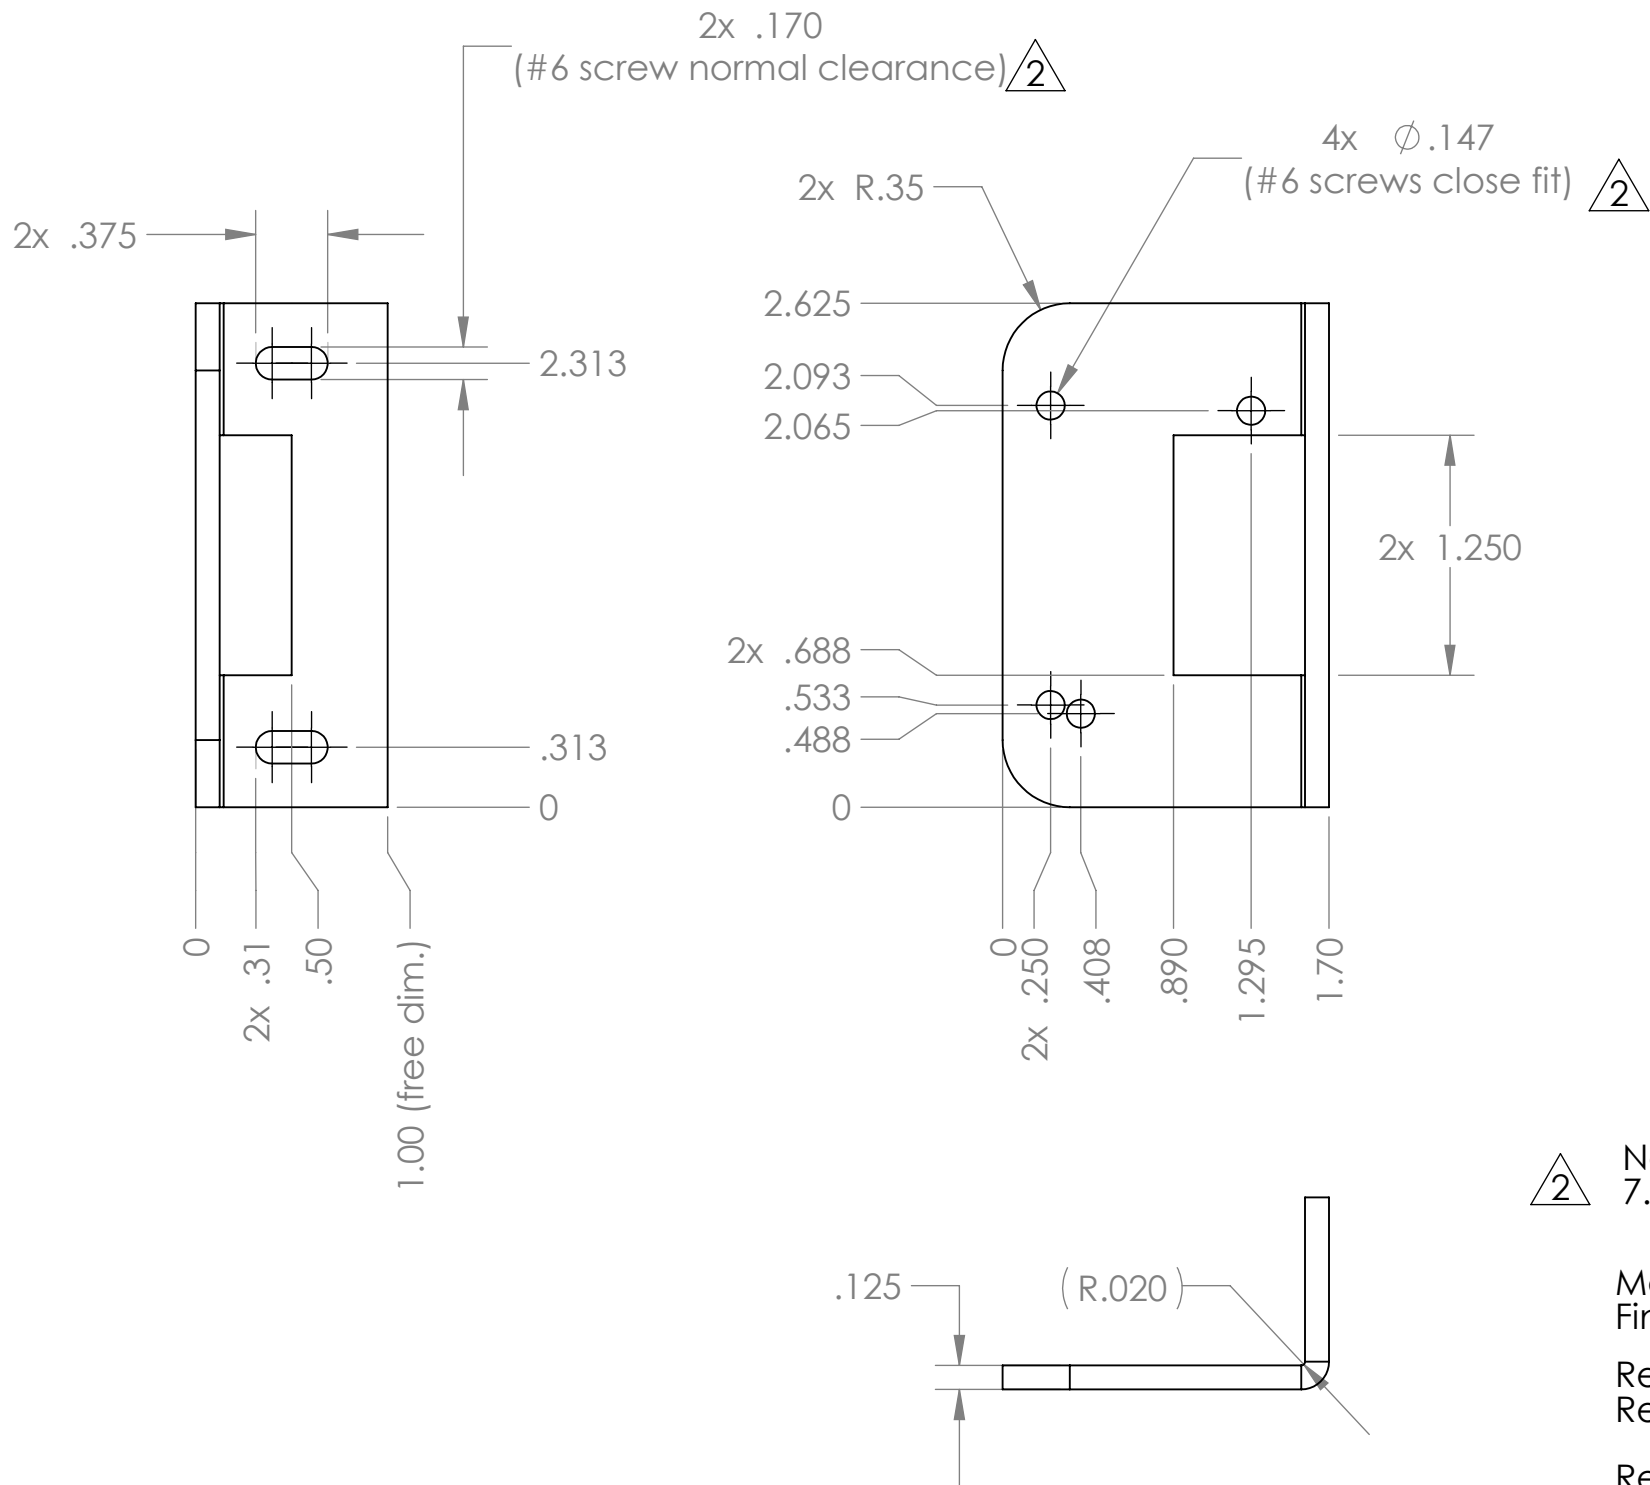

$\triangle 2$ Notes, continuation from title block:
7. Waterjet ok.

Material: Aluminum
Finish: Black Anodized

Rev0(02/08/2013): Initial release
Rev1(03/07/2013): Too many changes (inc. overall dimensions) from Rev0 to indicate. Use only Rev1 CAD data and drawing.
Rev2(10/29/2015): Waterjet note 7 and hole clearance comments added

Shop / Q.C.	UNLESS OTHERWISE SPECIFIED TOLERANCES ARE:				CONCEPT DESIGN	DATE	Monterey Bay Aquarium Research Institute		
Inspector	1 PLACE DIM ±1/16	2 PLACE DIM ±.02	3 PLACE DIM ±.005	ANGLES ±1°	Klimov	02/2013	MBARI		
Shop Foreman	1. DIMENSIONS ARE IN INCHES 2. DIMENSION LIMITS HELD AFTER PLATING. 3. REMOVE BURRS AND SHARP EDGES .015 MAX. 4. MACHINED FILLET RADII .015-.030. 5. MACHINED DIAMETERS ON A COMMON CENTERLINE CONCENTRIC WITHIN .005 6. PERPENDICULARITY & PARALLELISM OF MACHINED SURFACES .002 PER INCH, MAX .012 INCHES FOR SINGLE SURFACE.				INITIAL RELEASE	DATE	7700 Sandholdt RD.		
Engineer					Klimov	02/08/2013	Moss Landing, CA 95039		
					LAST REVISION	DATE	PH: (831) 775-1700		
					Klimov	10/29/2015			
					CHECKED	DATE	DRAWING NAME and FILE NAME		
NEXT ASSY Description					xx	xx/xx/xxxx	10020895-014Rev2_Modem-Bracket		
					PROJECT NO.		SIZE	DWG. NO.	REV.
Application	DO NOT SCALE DRAWING				901006		B	XX	2
					PROJECT NAME		SCALE	1:1	SHEET 1 OF 1
					BEDS				