
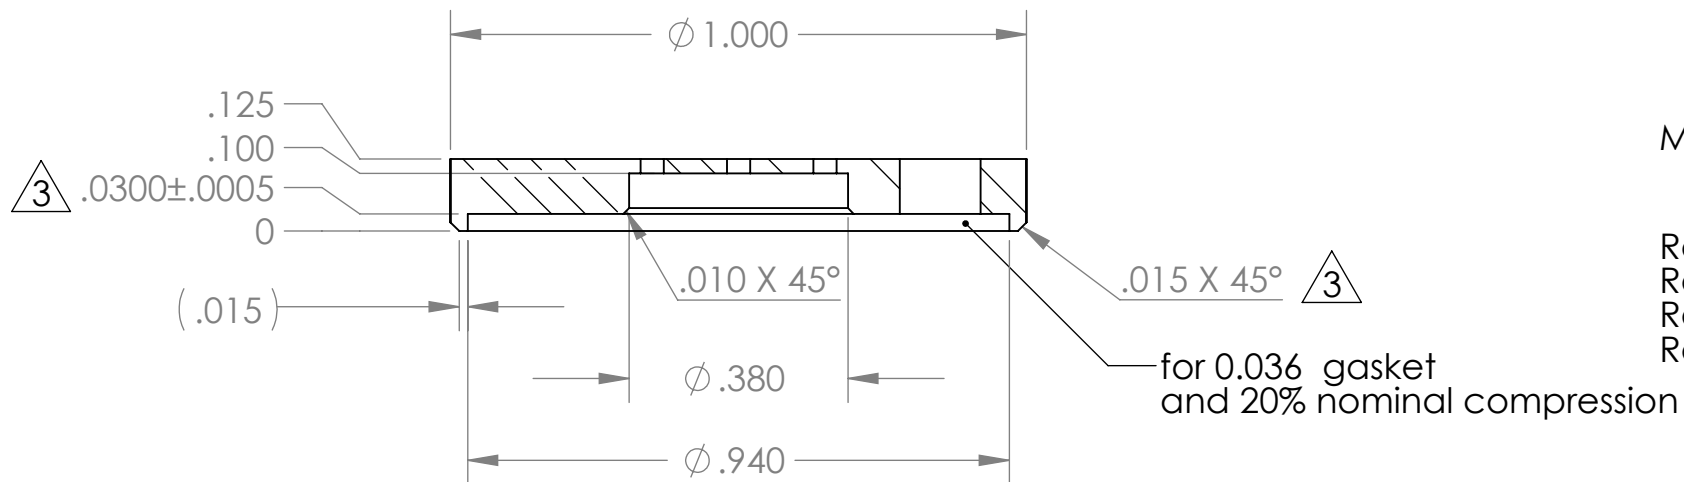
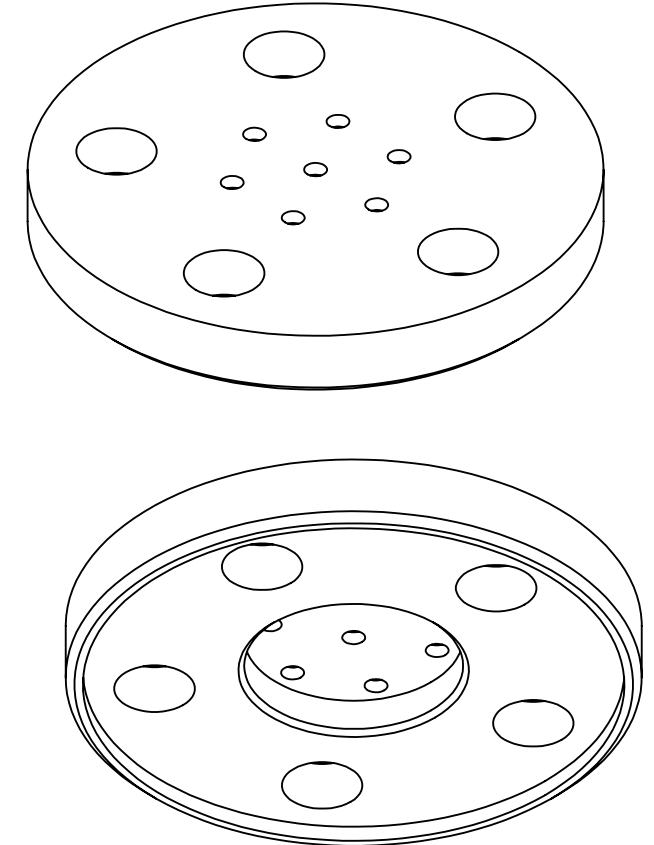


THE INFORMATION CONTAINED IN THIS DRAWING IS THE SOLE PROPERTY OF MBARI. ANY REPRODUCTION IN PART OR WHOLE WITHOUT THE WRITTEN PERMISSION OF MBARI IS PROHIBITED.

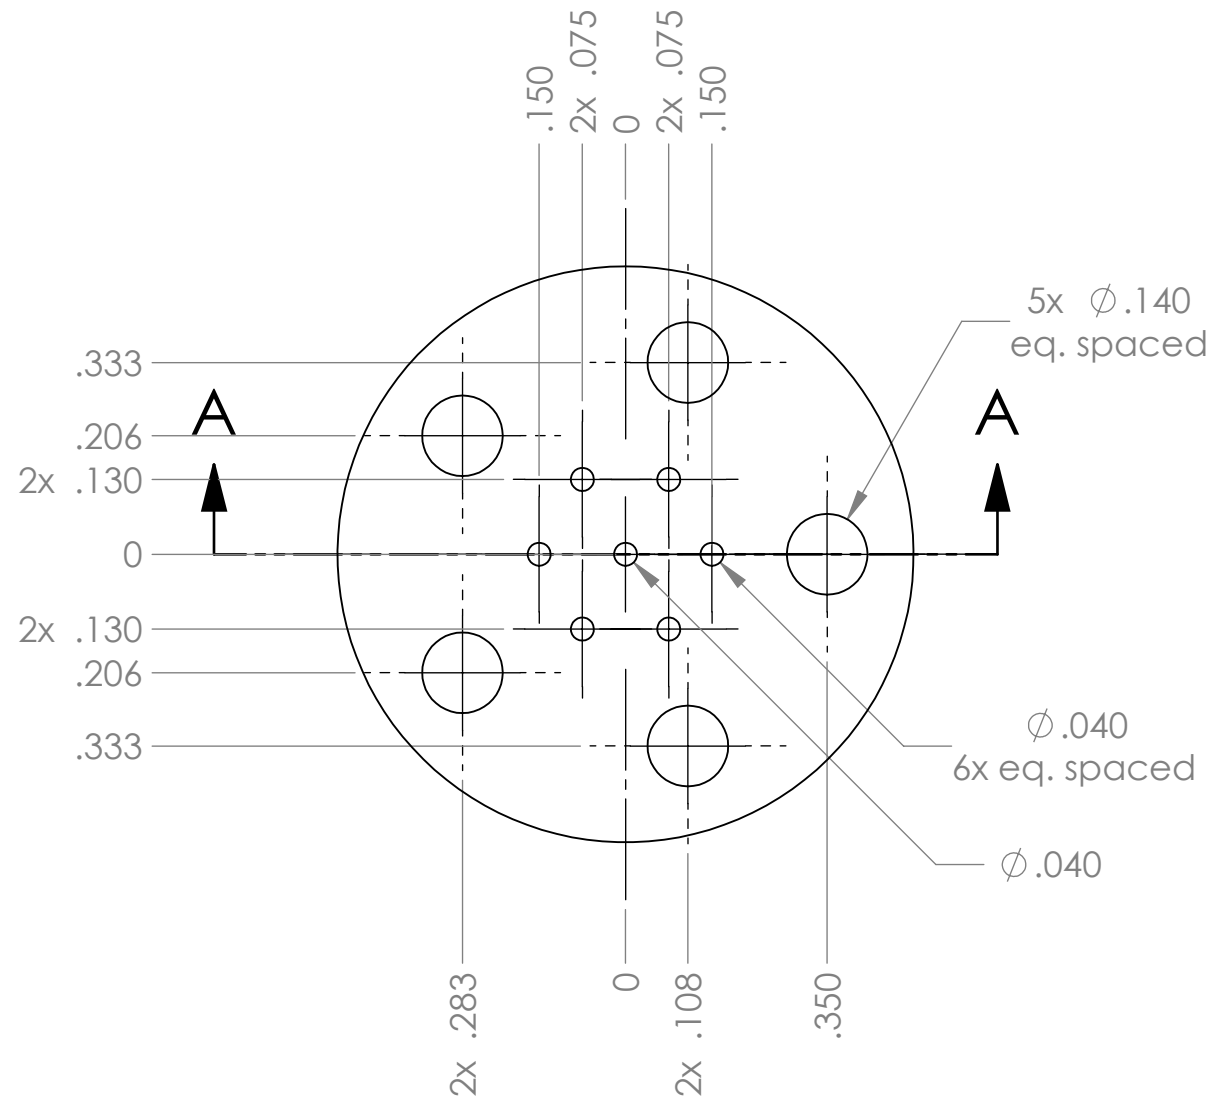

Material: Ti-6Al-4V

Rev0(03/25/2013): Initial release, 1 made in Aluminum
Rev1(03/27/2013): Modified with 7 holes screen in the middle and 0.032" gasket
Rev2(04/09/2013): Modified for actual 0.036" gasket
Rev3(11/20/2013): Chamfer 0.010" to 0.015"; depth 0.028" to 0.030"

Shop / Q.C.	UNLESS OTHERWISE SPECIFIED TOLERANCES ARE:				CONCEPT DESIGN	DATE	Monterey Bay Aquarium Research Institute MBARI 7700 Sandholdt RD. Moss Landing, CA 95039 PH: (831) 775-1700		
Inspector	1 PLACE DIM $\pm 1/16$	2 PLACE DIM $\pm .02$	3 PLACE DIM $\pm .005$	ANGLES $\pm 1^\circ$	L. Bird	06/2012			
Shop Foreman	1. DIMENSIONS ARE IN INCHES 2. DIMENSION LIMITS HELD AFTER PLATING. 3. REMOVE BURRS AND SHARP EDGES .015 MAX. 4. MACHINED FILLET RADII .015-.030. 5. MACHINED DIAMETERS ON A COMMON CENTERLINE CONCENTRIC WITHIN .005. 6. PERPENDICULARITY & PARALLELISM OF MACHINED SURFACES .002 PER INCH, MAX .012 INCHES FOR SINGLE SURFACE.				INITIAL RELEASE	DATE	DRAWING NAME and FILE NAME 10020895-016_DiaphragmCover		
Engineer					Klimov	03/25/2013			
NEXT ASSY Description	DO NOT SCALE DRAWING				LAST REVISION	DATE	SIZE DWG. NO. B 10020895-016		
Application					Klimov	11/20/2013			
					CHECKED	DATE	SCALE 3:1		
					xx	xx/xx/xxxx			
					PROJECT NO.	901006	SHEET 1 OF 1		
					PROJECT NAME	BEDS			
							REV. 3		