
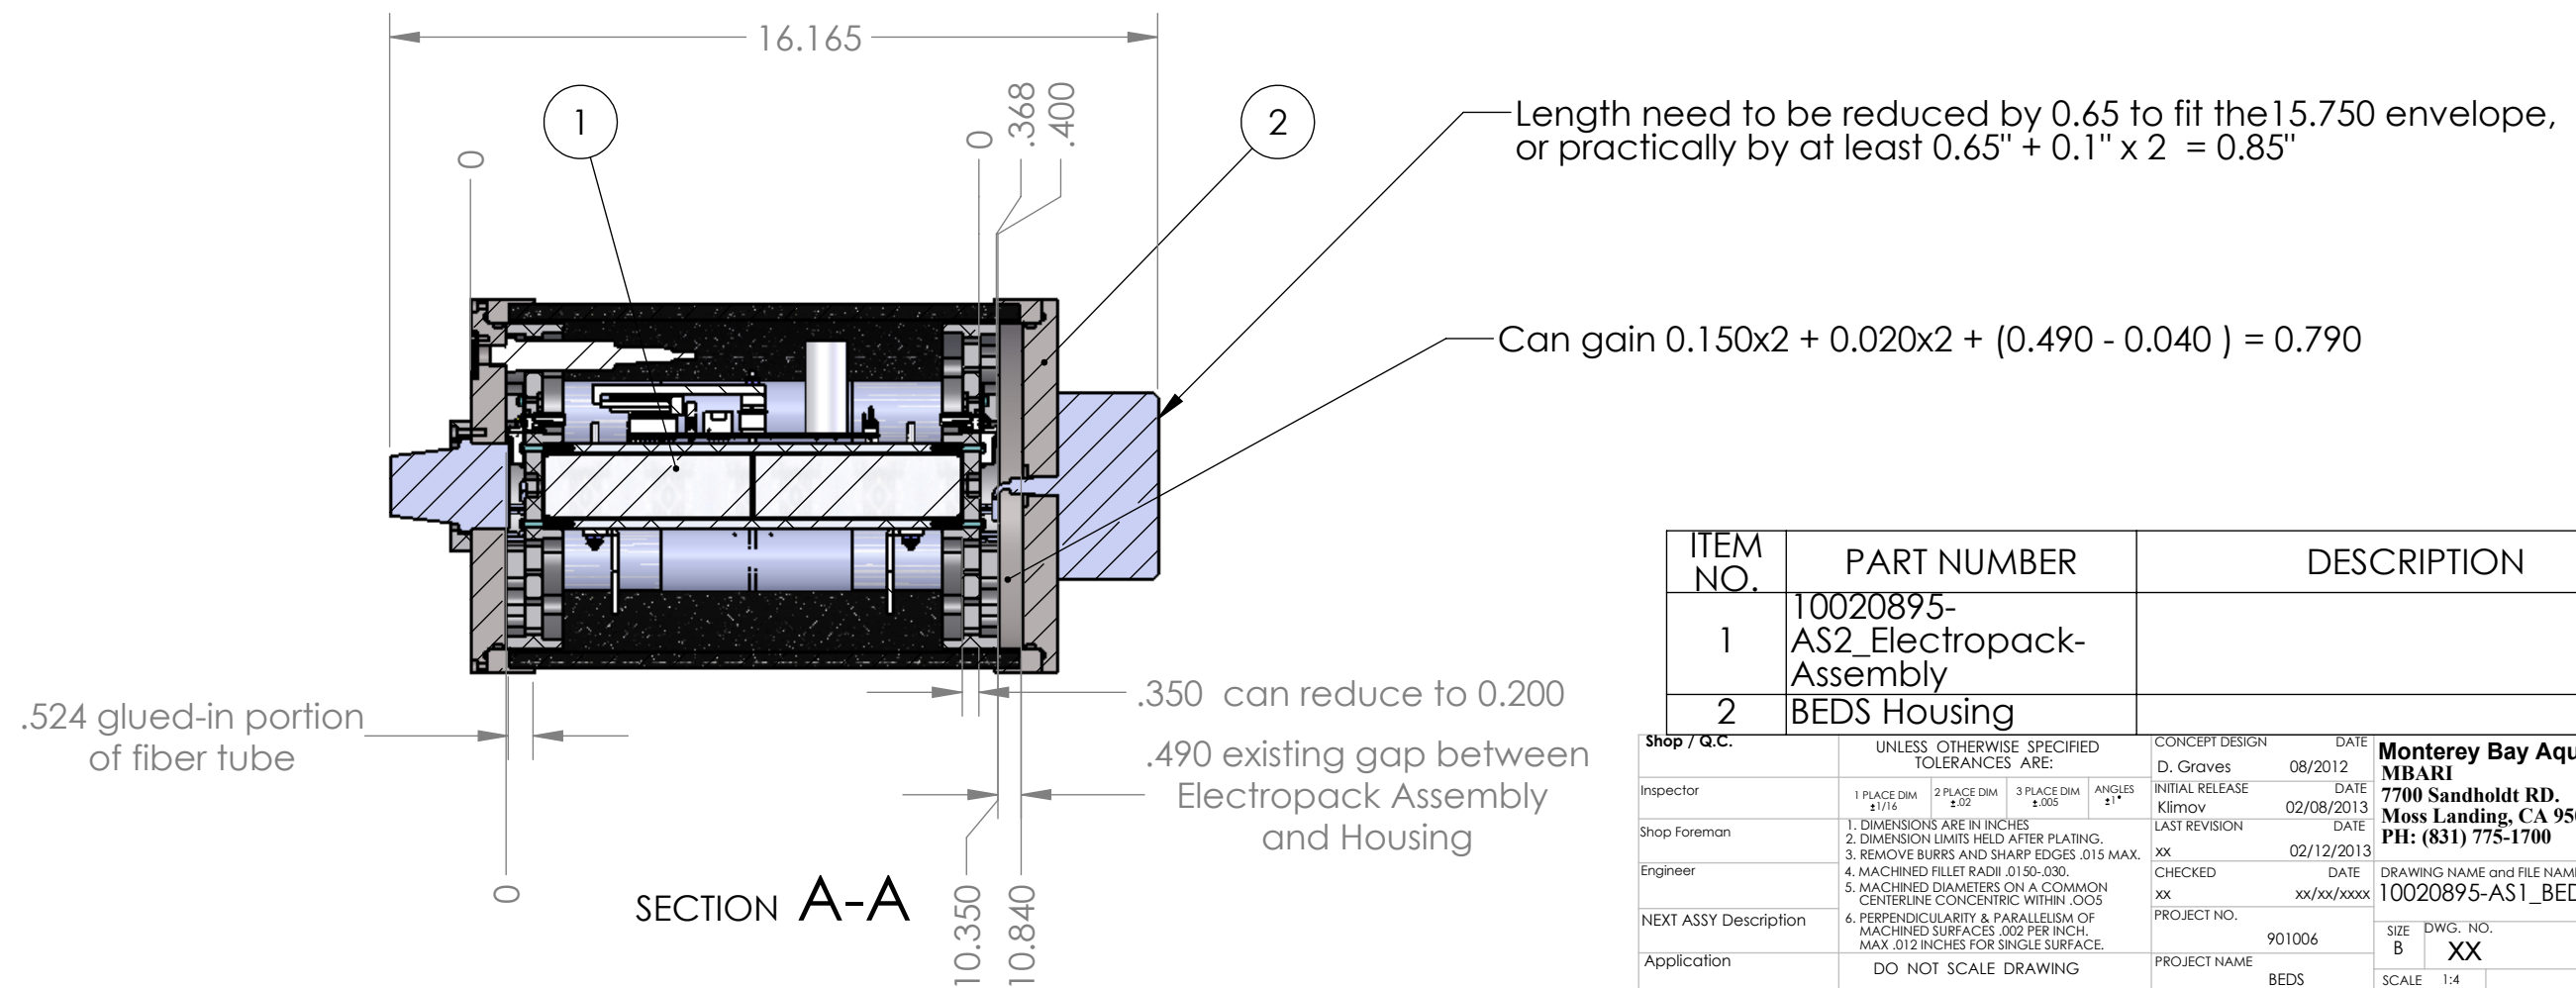


THE INFORMATION CONTAINED IN THIS DRAWING IS THE SOLE PROPERTY OF MBARI ANY REPRODUCTION IN PART OR WHOLE WITHOUT THE WRITTEN PERMISSION OF MBARI IS PROHIBITED.

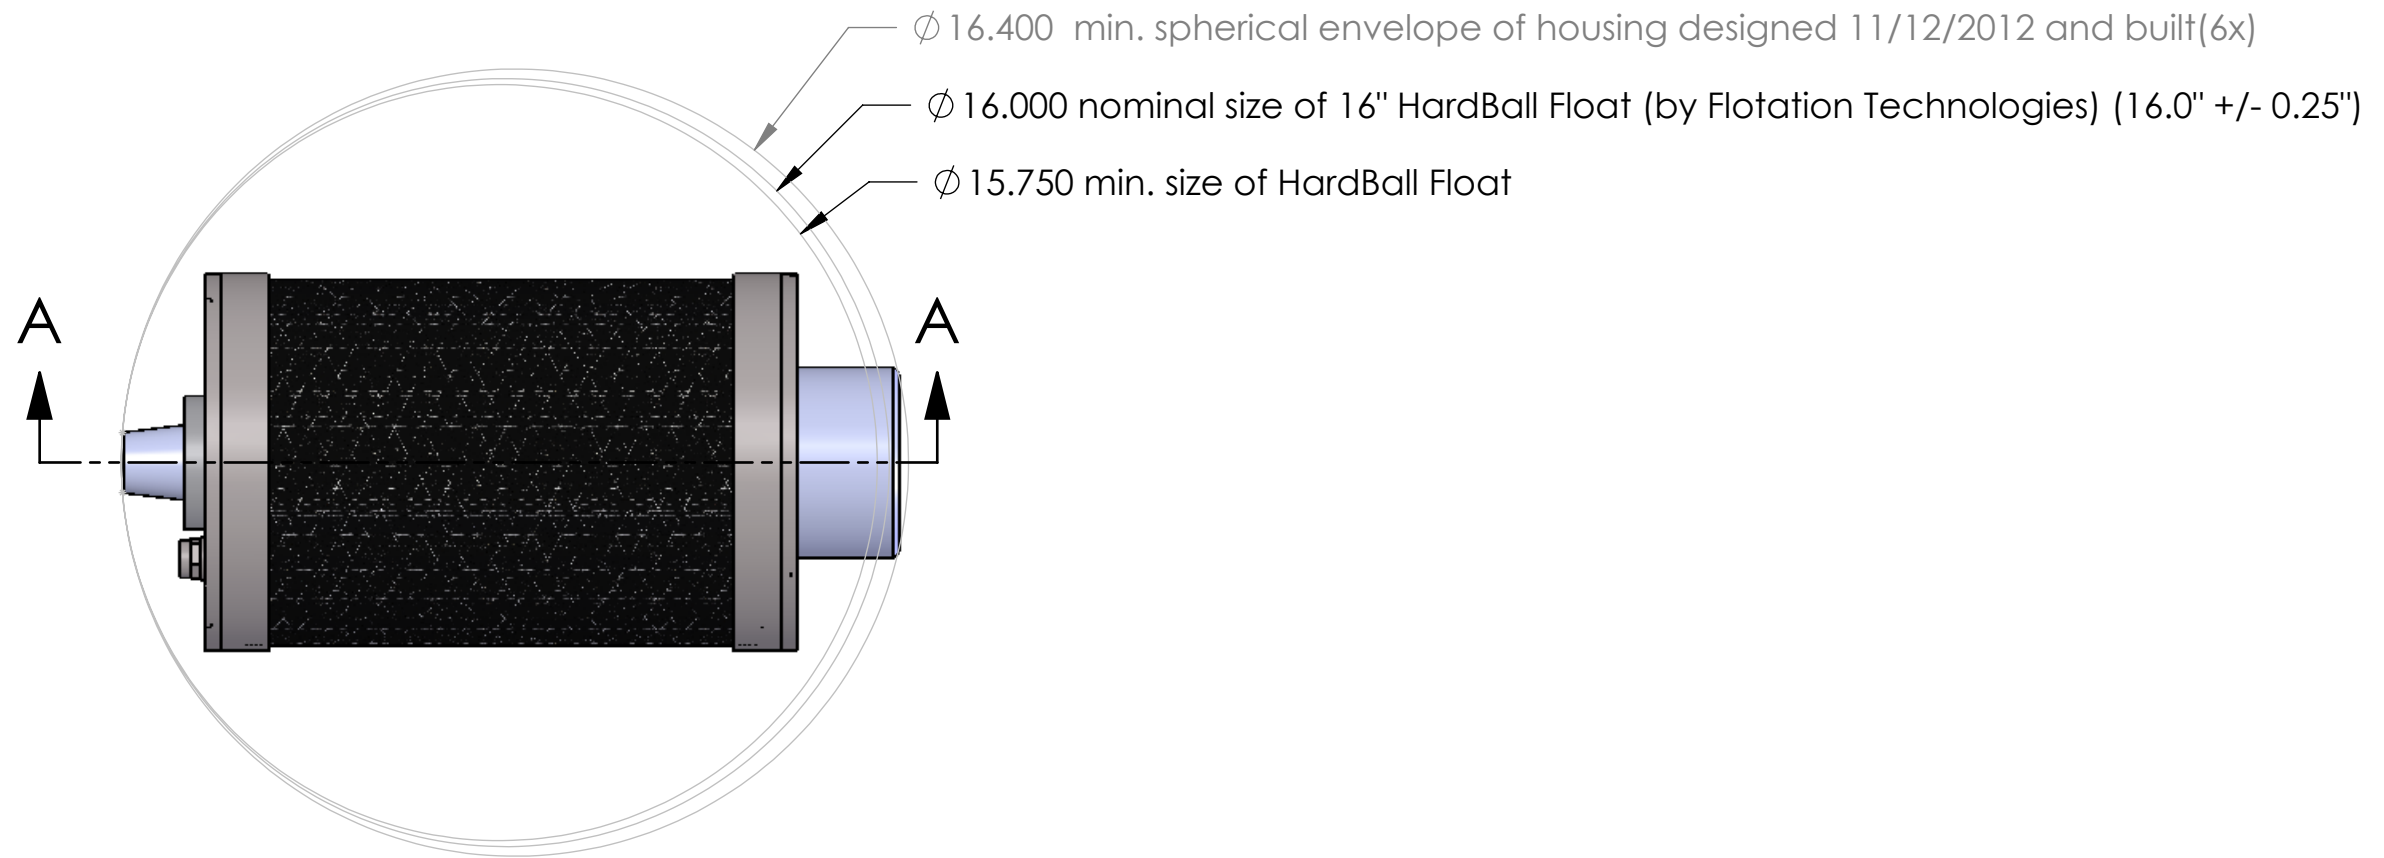

ITEM NO.	PART NUMBER	DESCRIPTION	QTY.
1	10020895-AS2_Electropack-Assembly		1
2	BEDS Housing		1

Shop / Q.C.		UNLESS OTHERWISE SPECIFIED TOLERANCES ARE:		CONCEPT DESIGN	DATE	Monterey Bay Aquarium Research Institute MBARI 7700 Sandholdt RD. Moss Landing, CA 95039 PH: (831) 775-1700 	
Inspector	1 PLACE DIM ±1/16	2 PLACE DIM ±.02	3 PLACE DIM ±.005	ANGLES ±1°	D. Graves		
Shop Foreman	1. DIMENSIONS ARE IN INCHES 2. DIMENSION LIMITS HELD AFTER PLATING. 3. REMOVE BURRS AND SHARP EDGES .015 MAX. 4. MACHINED FILLET RADII .0150-.030. 5. MACHINED DIAMETERS ON A COMMON CENTERLINE CONCENTRIC WITHIN .005 6. PERPENDICULARITY & PARALLELISM OF MACHINED SURFACES .002 PER INCH. MAX .012 INCHES FOR SINGLE SURFACE.				INITIAL RELEASE	DATE	DRAWING NAME and FILE NAME 10020895-AS1_BEDs-Cylinder-Assembly SIZE B DWG. NO. XX REV. 0
Engineer					xx	02/10/2013	
NEXT ASSY Description					CHECKED	DATE	SCALE 1:4 SHEET 1 OF 1
Application	DO NOT SCALE DRAWING				xx	xx/xx/xxxx	
					PROJECT NO.	901006	
					PROJECT NAME	BEDS	