


NOTE: WHEN MOTOR ASSY
WAS REPLACED WITH NEWER
MODEL IN DEC 2021, MOTOR
PHASE B HAD TO HAVE
POLARITY FLIPPED WHEN A1P4
WAS MOLDED ON. WIRE BLK
TO WHT AND WHT TO BLK.

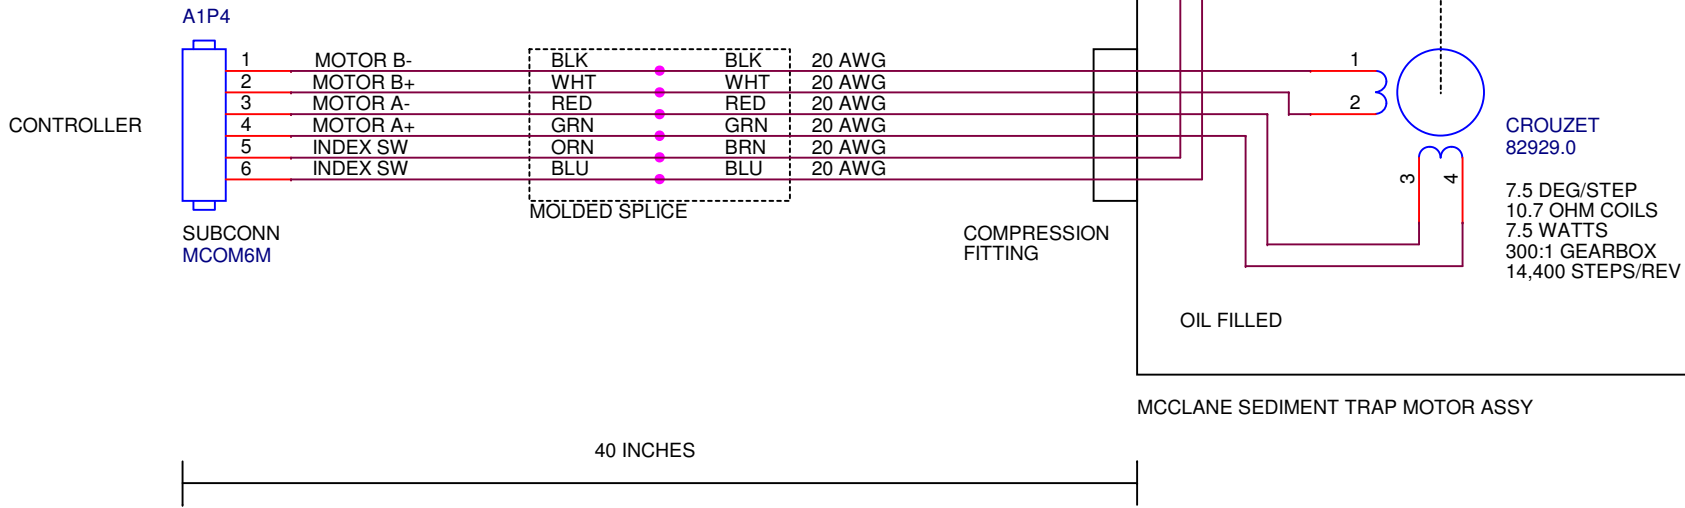

Engineer: P. McGill		
Title Sedimentation Event Sensor: Stepper Motor		
Size A	Document Number 10020743	Rev 1.1.0
Date:	Thursday, October 15, 2015	Sheet 1 of 1