


LOWER ROD/
UPPER TETHER
TERMINATION

UPPER ROD
ASSEMBLY

TOP HAT
PENETRATOR

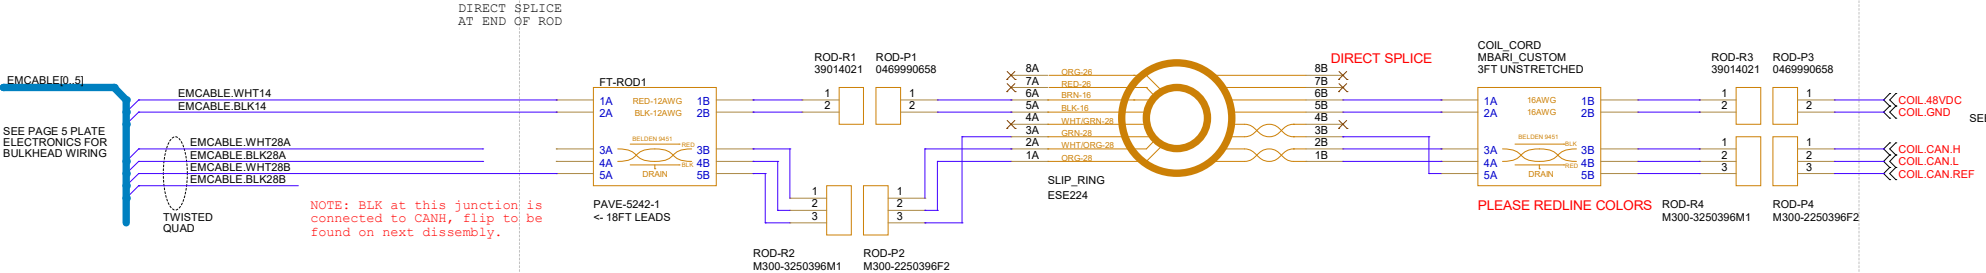

- Revisions:
- 2.6 2019.12.XX EJM - Detail for new rod and pavetech.
 - 2.7 2020.08.09 EJM - Adding connectors sets 566 for end of rod connection. Fix of tether color conventions
 - 2.8 2024.04.16 EJM - Removed connections at end of rod due to space constraints.

		Monterey Bay Aquarium Research Institute 7700 Sandholdt Road, Moss Landing, CA 95039	
Title		Project	
Spring Assembly: Rod Wiring		901405	
Engineer	Size	Document Number	Part Number
E. MARTIN	C	14020633	PTO
Designer	Date	Project File	Rev
M/A	Tuesday, April 16, 2024	monterey.mj	2.8
Sheet		3 of 5	