
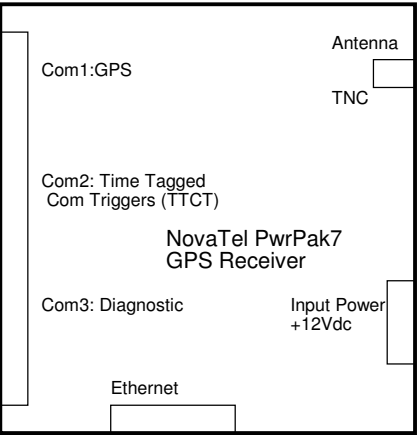


Topside

Subsea

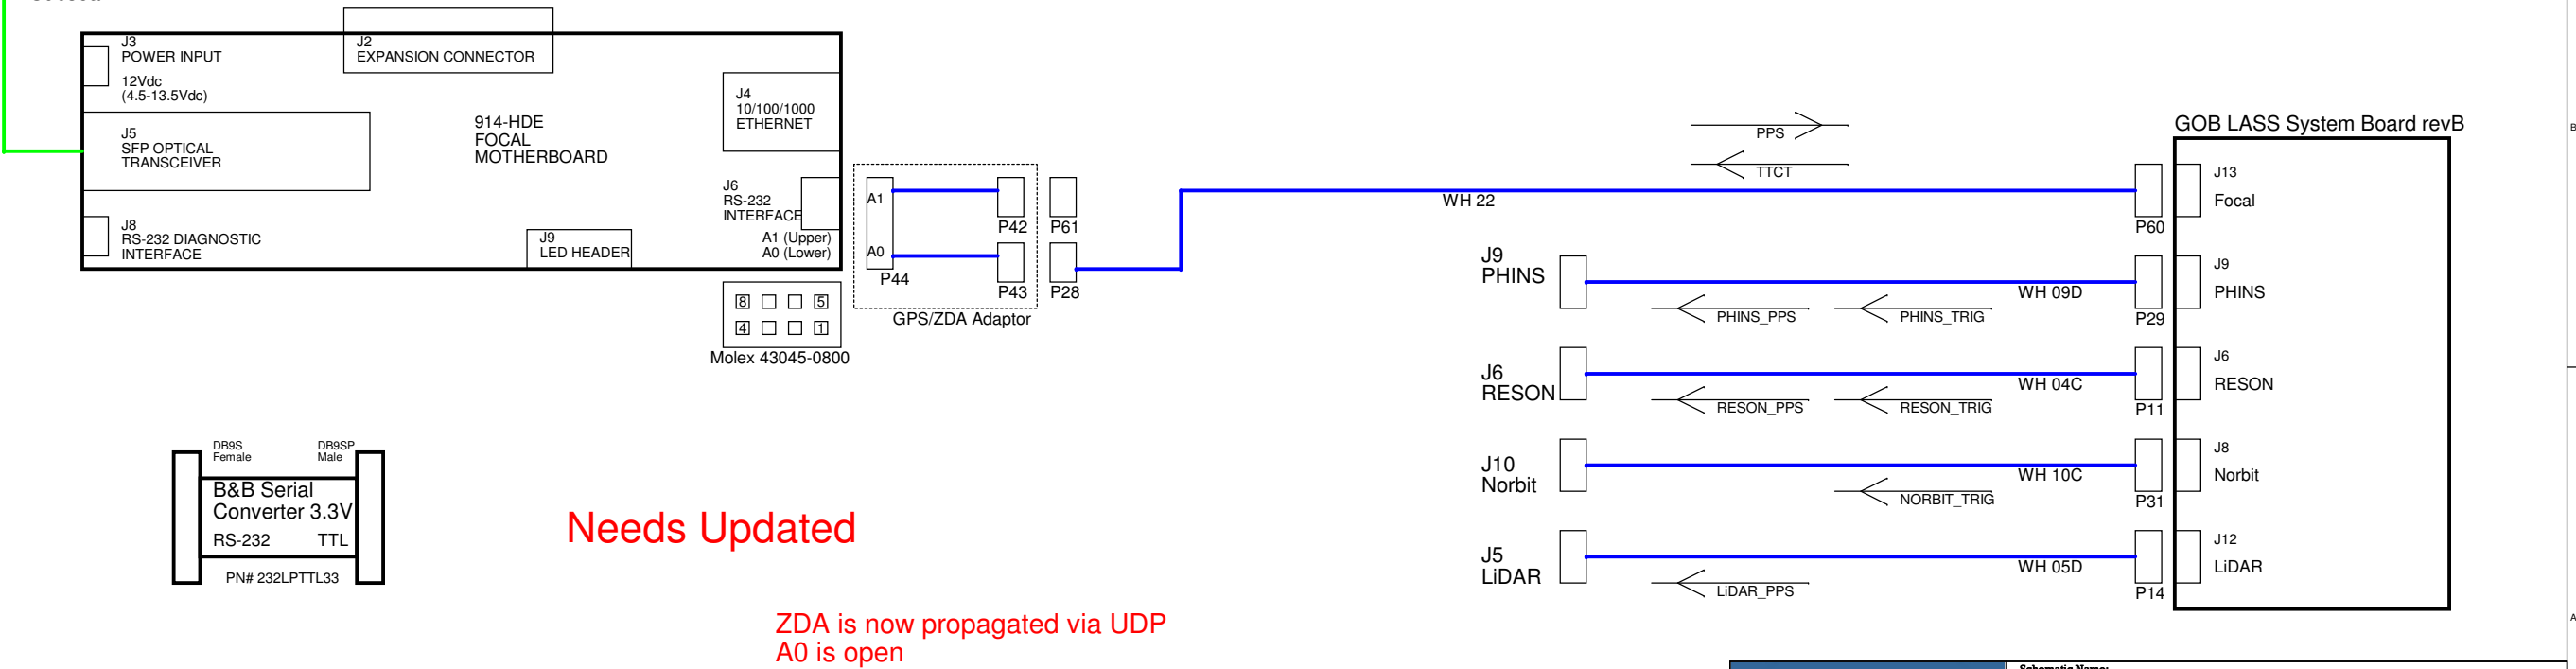

COM1_TX (TTCT) COM1_RX (PPS)

To Diagnostics
DB9 Connector

To Startech
(Time Tagged Camera Triggers)

To Front Panel
PPS Activity LED

 Monterey Bay Aquarium Research Institute 7700 Sandholdt Road, Moss Landing, CA 95039		Schematic Name: TCU - 2026	
		Page Title: Trig+PPS Ref Drawing 2026	Engineer: <Engineer>
Project Name: <Project Name>		Designer: <Designer>	
Group Name: <Group>	System: <System>	Subsystem: <Subsystem>	Last Updated By: <Updated By>
Drawing Number: <MBARI DN>	Release: <Rev>	Version: <Version>	Status: <Status>
Page Modify Date: Tuesday, May 18, 2026	Check In Date: <LCID>	Sheet <Page Number> <Page Count>	
Size: C			