




Articulated Frame

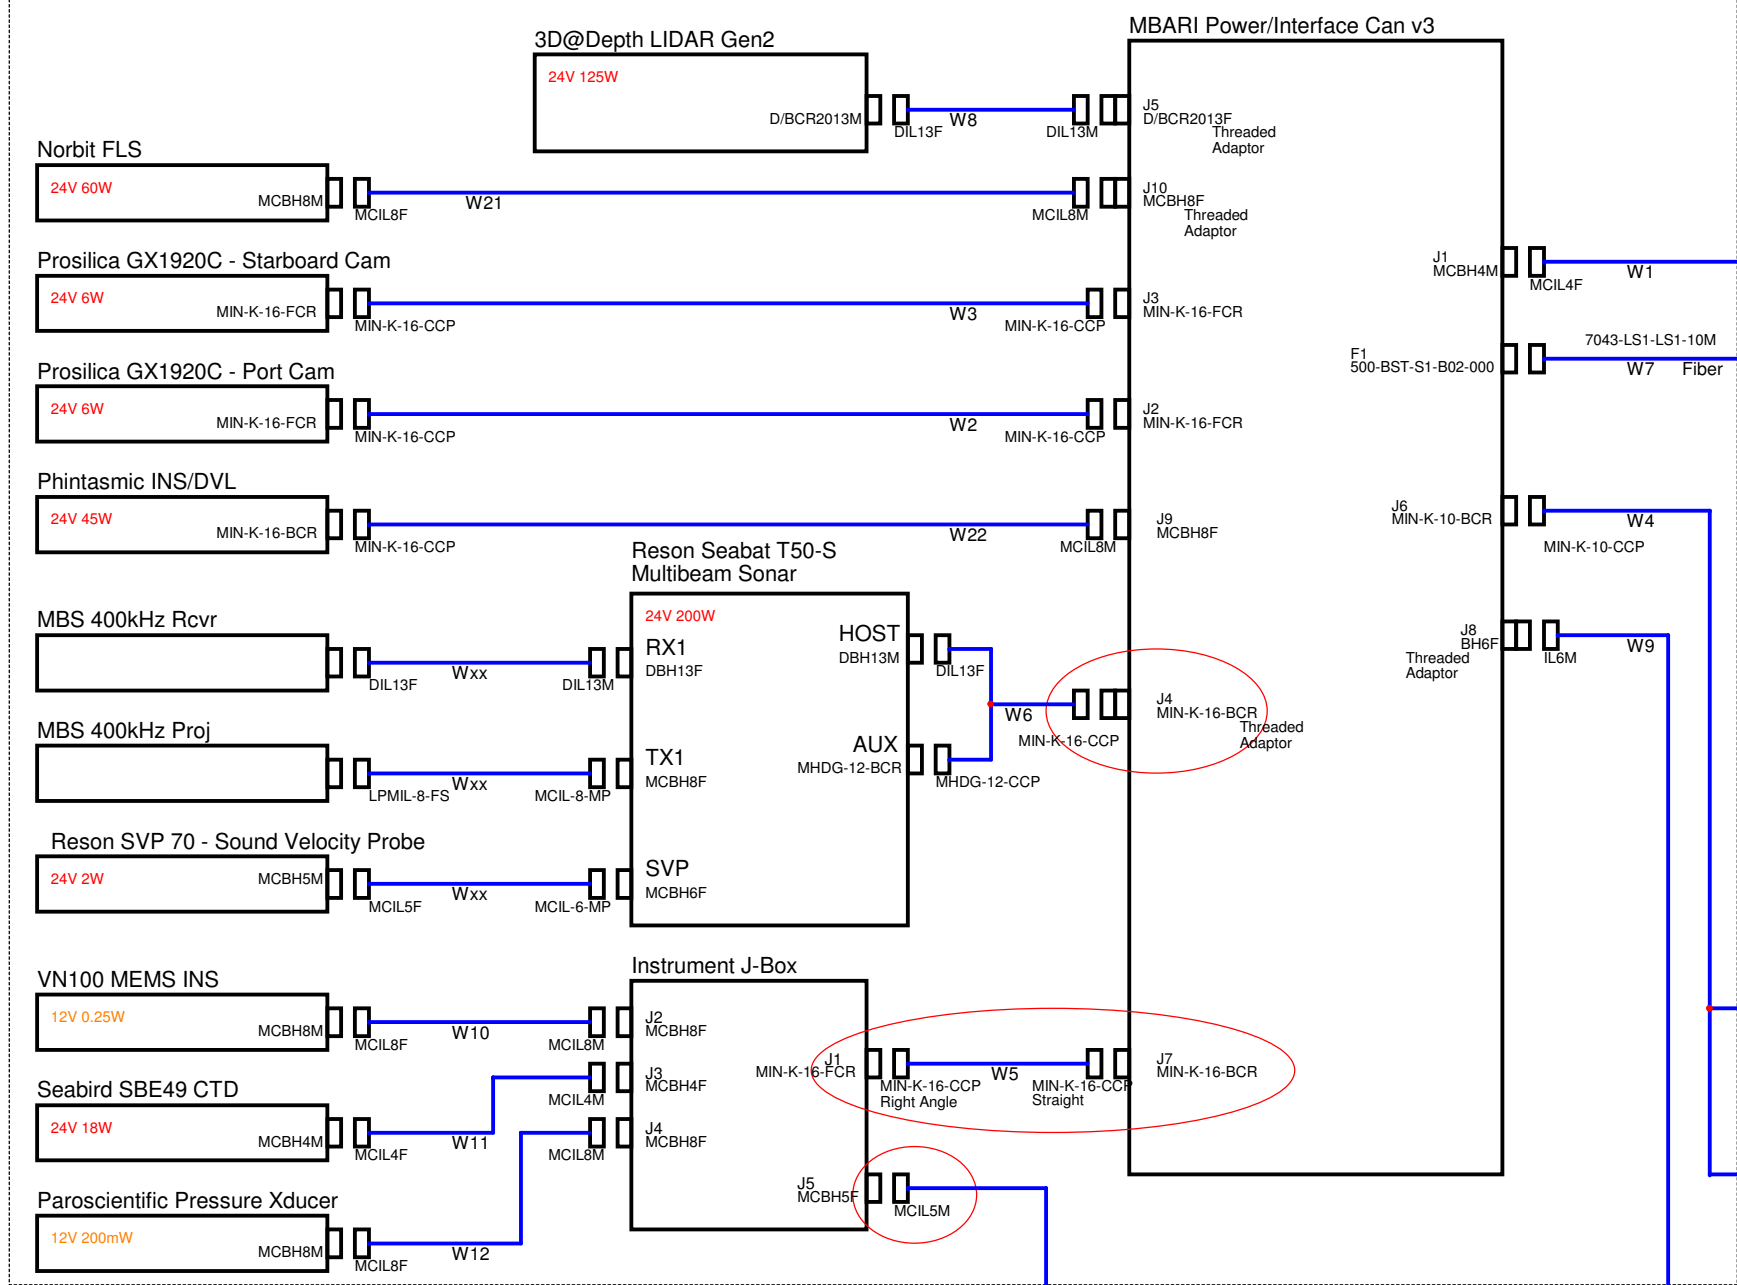

ROV Ventana
(During Deployment)

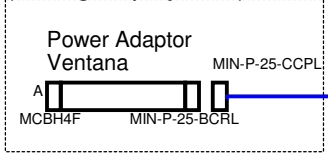


ROV Ventana

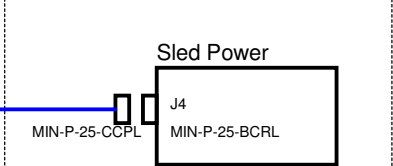


ROV Ventana
110VAC 1800 W

LASS Tool Sled (Aft)

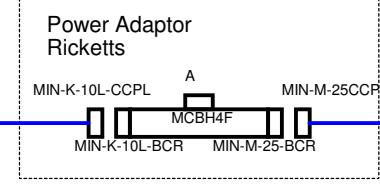


ROV Doc Ricketts

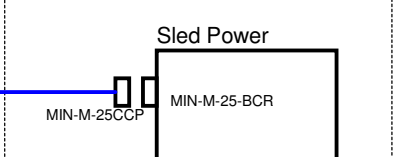


ROV Doc Ricketts
110VAC 10 Amps
240VDC 10 Amps


LASS Tool Sled (Fore)

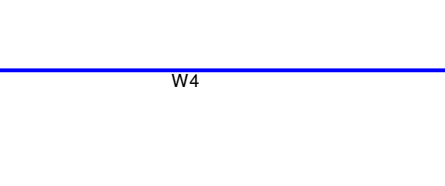


Port Swing Arm

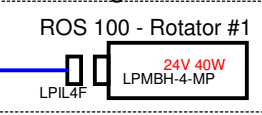


Starboard Swing Arm

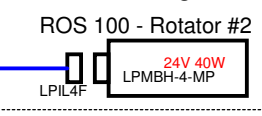


LASS Tool Sled (Aft)

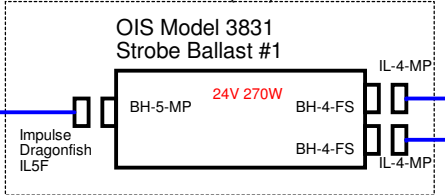


Port Swing Arm

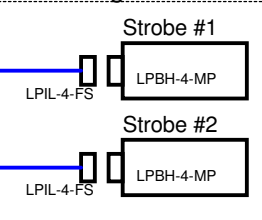

LASS Tool Sled (Aft)

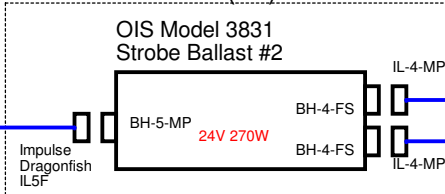

Starboard Swing Arm

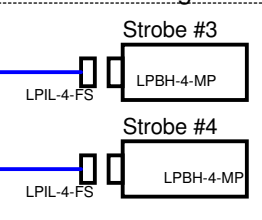

Schematic Name: OI - LASS			
Page Title: LASS Tool Sled Cable Wiring 26		Engineer: Chad Key	
Project Name: Ocean Imaging	Group Name: OceanImaging/LASSROV	Designer: Chad Key	
System: <System>	Subsystem: <Subsystem>	Last Updated By: ckey	
Drawing Number: 100222112	Release: A	Version: 3	Status: Active
Page Modify Date: Monday, March 04, 2025	Check In Date: 3/4/2024 4:04:51 PM	Sheet 1 of 1	
		Size: C	