



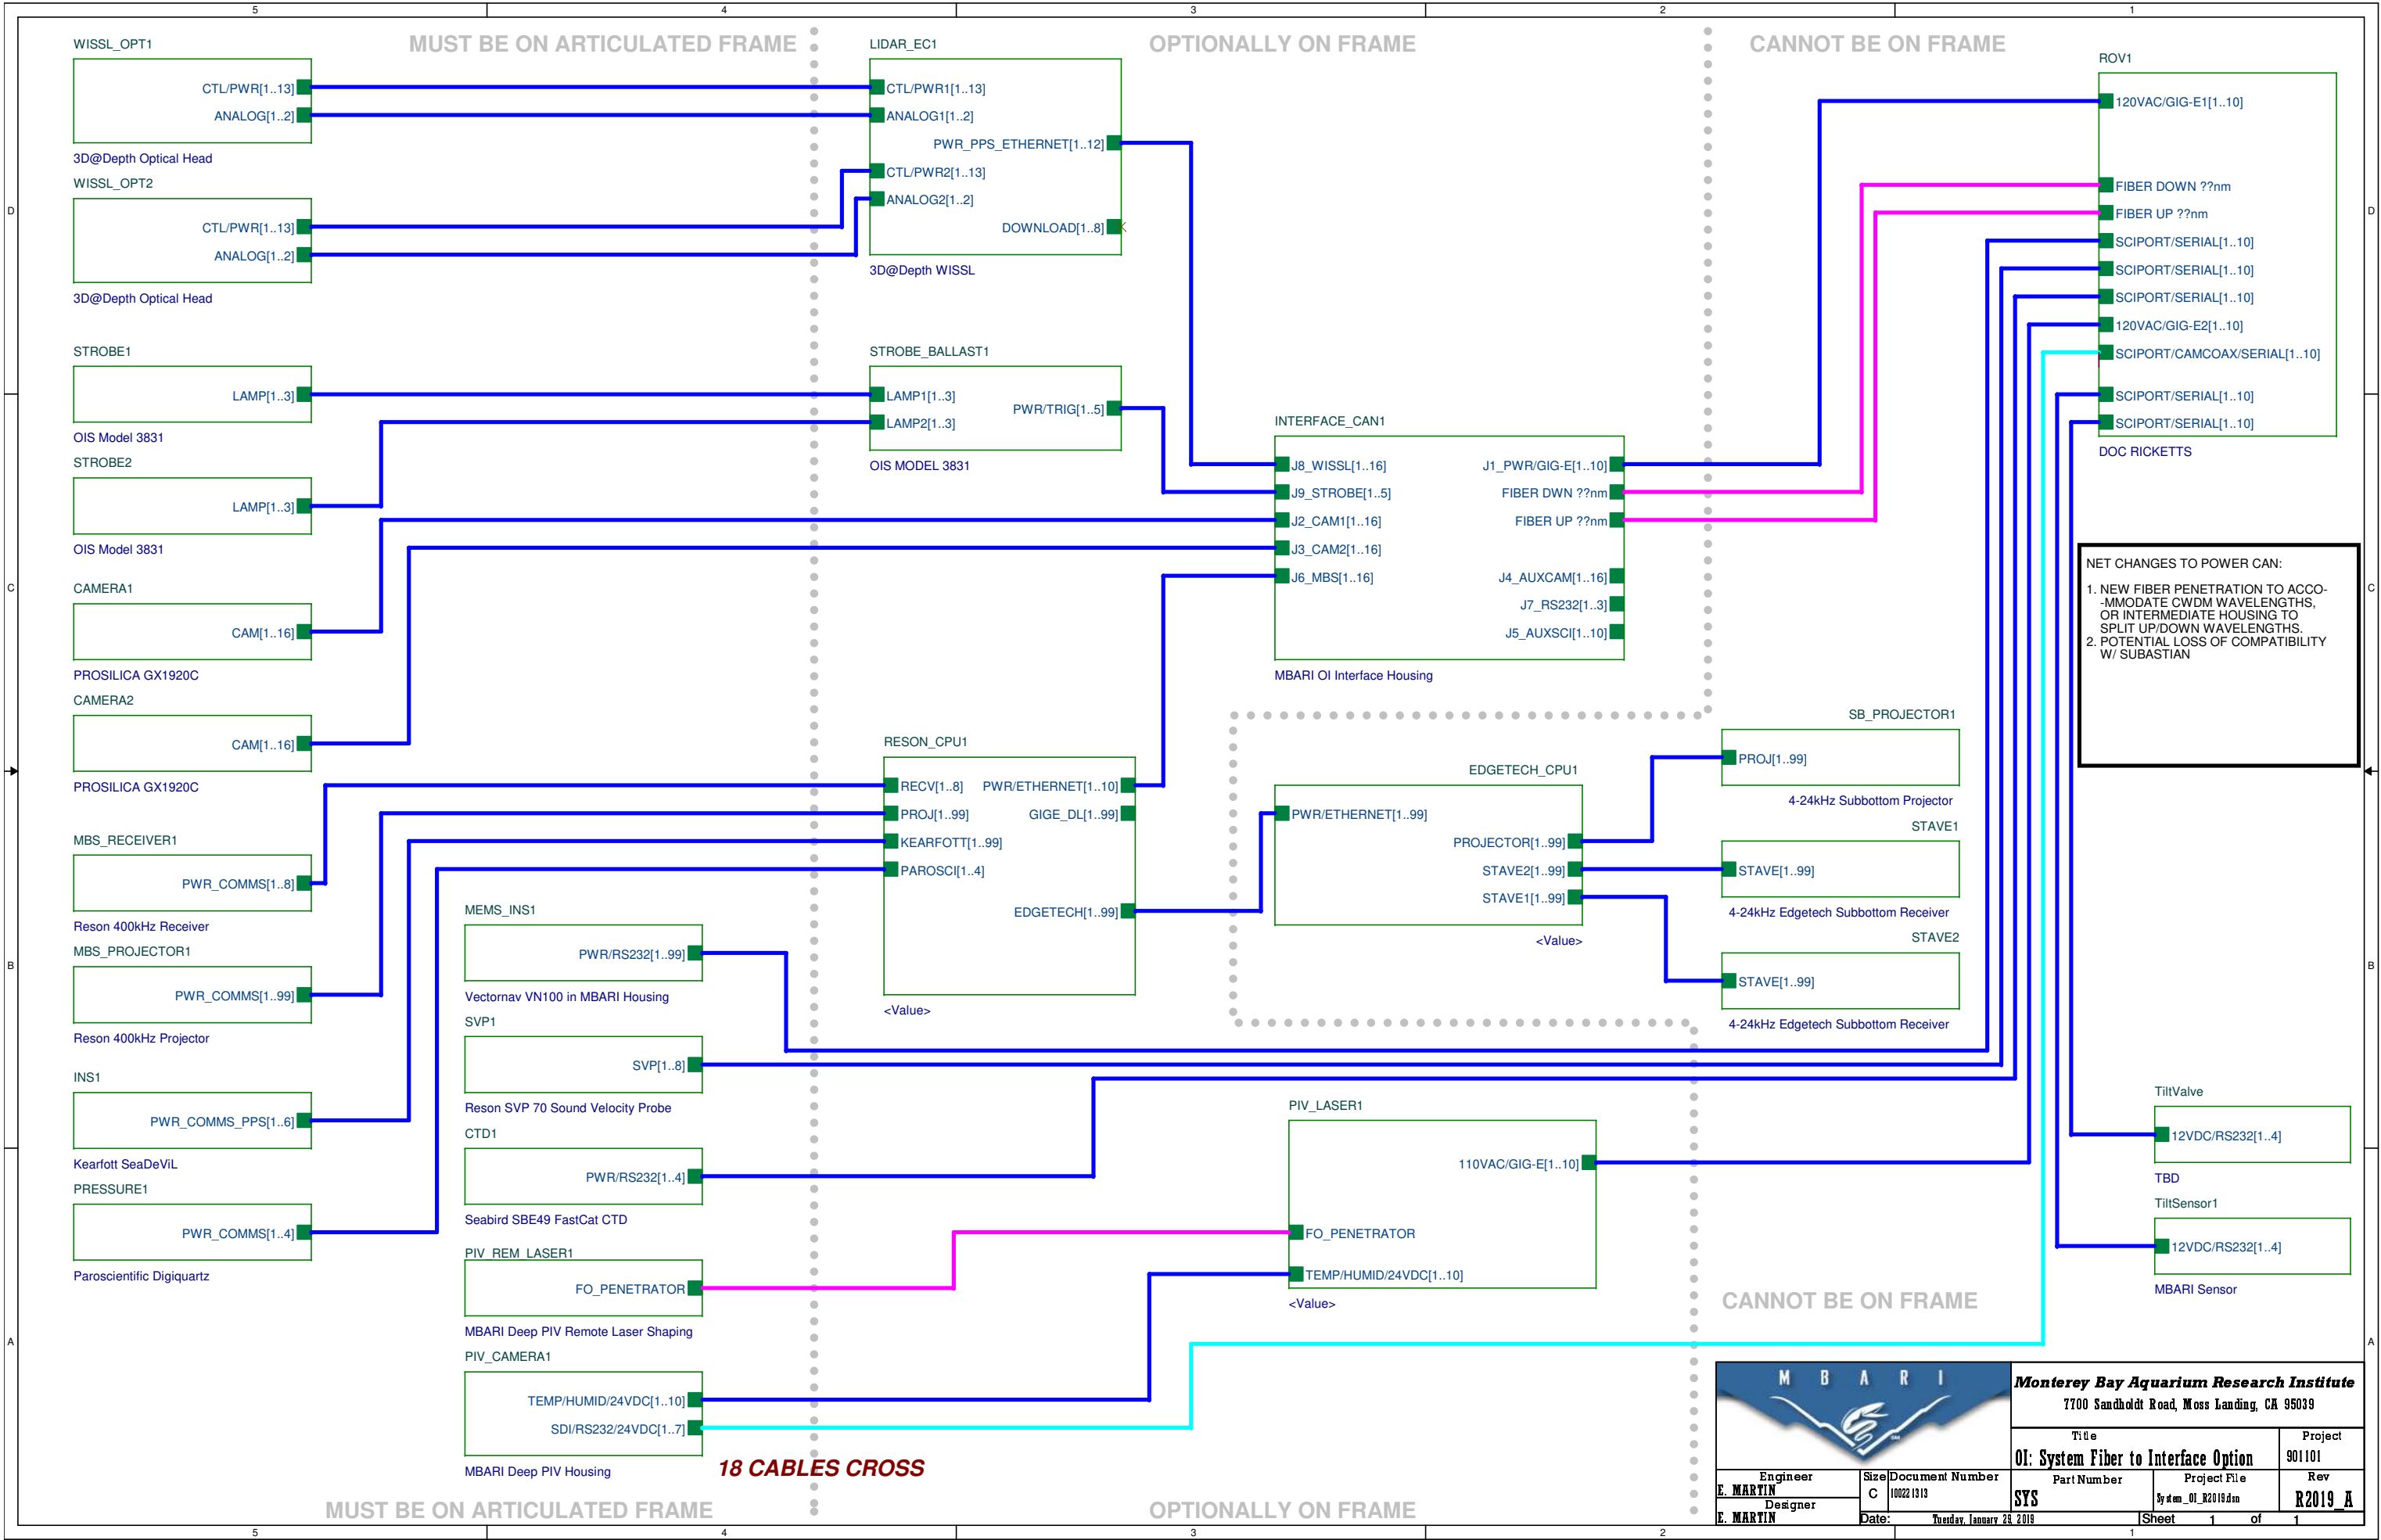

Monterey Bay Aquarium Research Institute
7700 Sandholdt Road, Moss Landing, CA 95039

Engineer E. MARTIN		Size C		Document Number 100221313		Date Tuesday, January 23, 2019		Title OI: System Fiber to Interface Option		Project 901101	
Designer E. MARTIN		Part Number SYS		Project File System_OI_R2019.dwg		Sheet 1		Rev R2019_A		of 1	

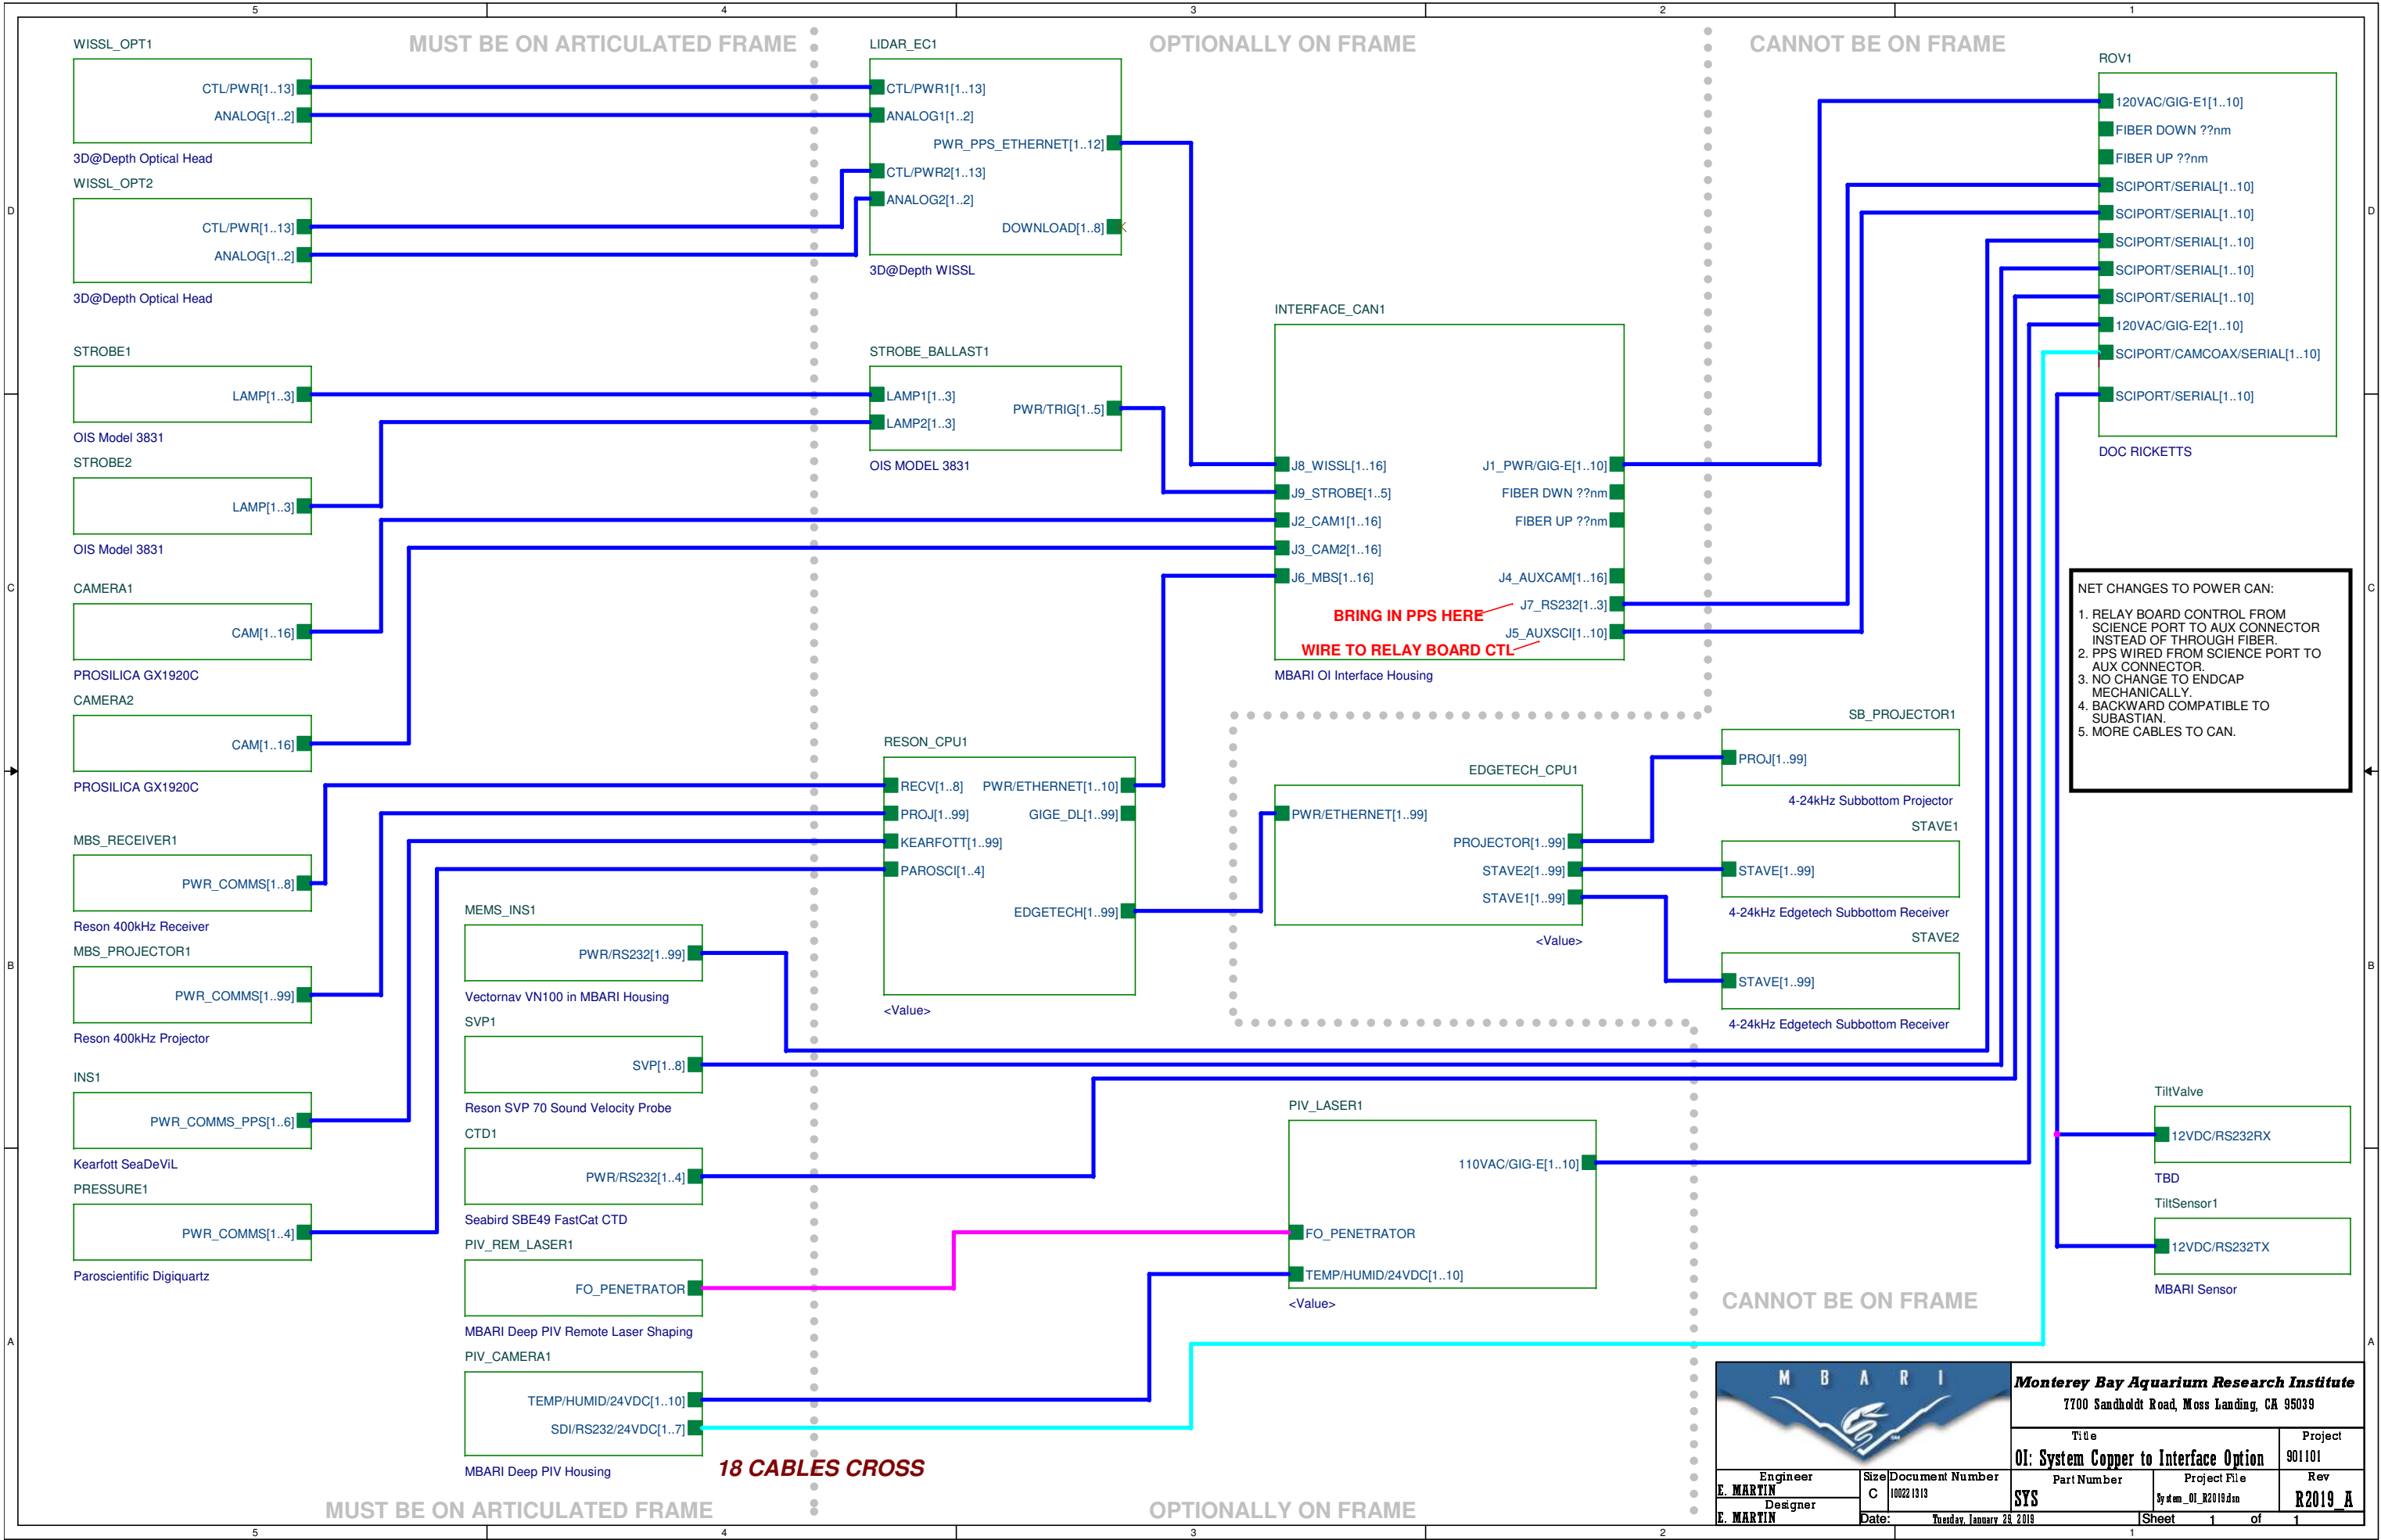

Monterey Bay Aquarium Research Institute 7700 Sandholdt Road, Moss Landing, CA 95039			
Title		Project	
OI: System Copper to Interface Option		901101	
Part Number	Project File	Rev	
SYS	System_OI_R2019.dwg	R2019_A	
Engineer	Size	Document Number	
E. MARTIN	C	100221313	
Designer	Date:	Tuesday, January 23, 2019	
E. MARTIN		Sheet 1 of 1	