


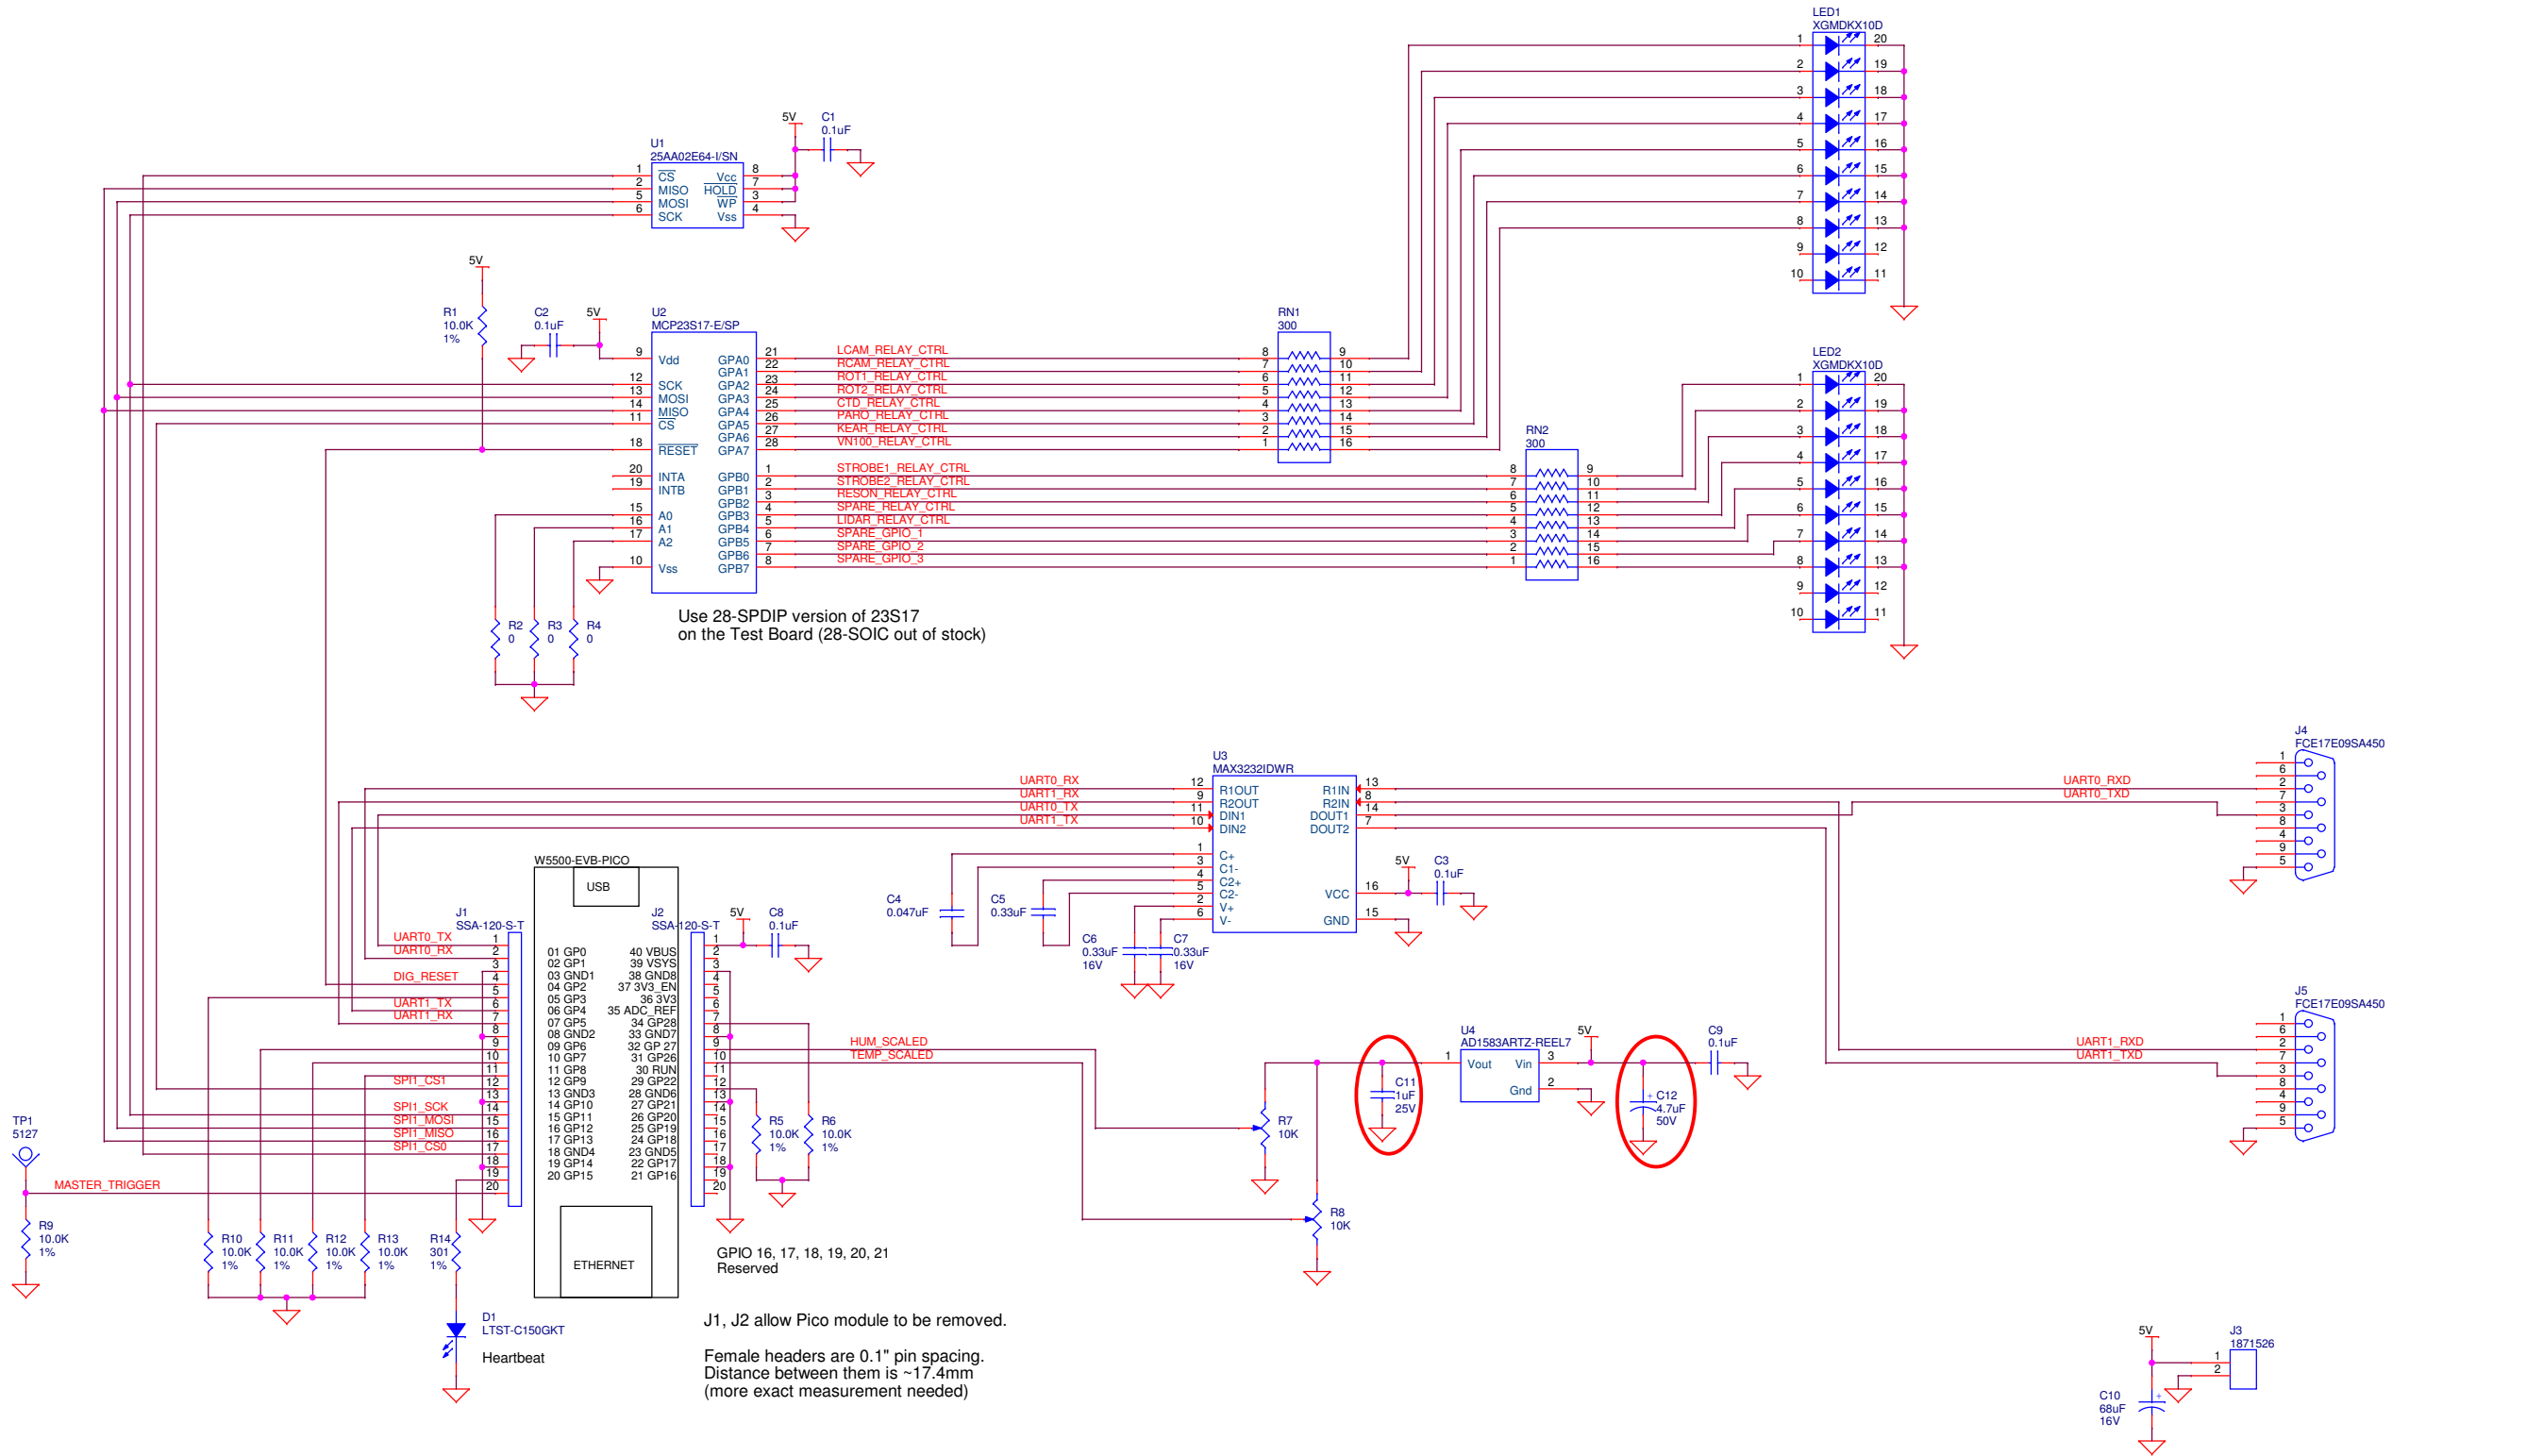

Use 28-SPDIP version of 23S17 on the Test Board (28-SOIC out of stock)

J1, J2 allow Pico module to be removed.
Female headers are 0.1" pin spacing.
Distance between them is ~17.4mm
(more exact measurement needed)

Added C11 and C12 to U4 input and outputs.



Schematic Name: SCHEMATIC1				
Page Title: PAGE1			Engineer: Chad Key	
Project Name: LASS		Group Name: OceanImaging		Designer: Chad Key
System: <System>		Subsystem: <Subsystem>		Last Updated By: ckey
Drawing Number: 100221811	Release: A	Version: 11	Status: Active	Size: C
Page Modify Date: Monday, March 27, 2023	Check In Date: 3/27/2023 9:40:59 AM		Sheet 1 of 1	