


→ Reason (teledyne)


weight 25.5 lbs
dimensions height 5.02"

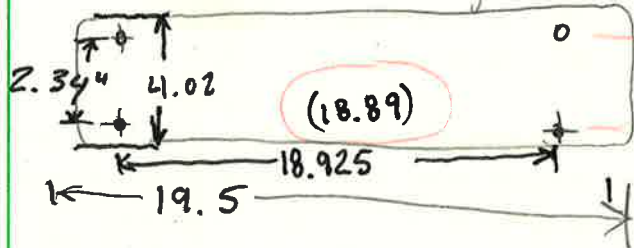

Actual hole locations
match models on
solidworks

→ Fugro (Bluefin)

Weight 7.4 lbs height 2.46

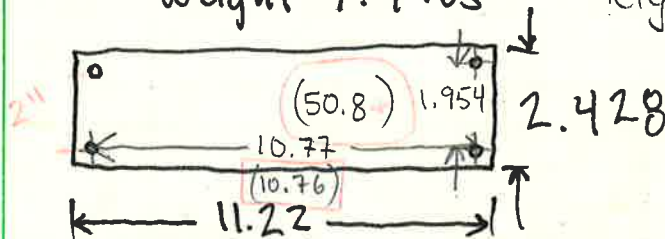

→ Camera A Weight 12.25 lbs 11in long 3.48 ϕ

→ Camera B Weight "

→ Light Can Weight 23.6 lbs
Length 14.01 inches 4.97 ϕ

→ Power Can Weight 47.8 lbs
Length 19.031 6.854 ϕ

→ 6" Bottle Weight 54.8 lbs
Length ~~54~~ 19.031" 6.854" ϕ

→ Kearsfott weight 100.5 lbs