


ECO F

** FOR ALL BOARDS**
Add inline resistor R25.

ECO E

** FOR ALL BOARDS **
Connect Jumper 1.

THIS IS A LOCAL COPY DO NOT
USE FOR BOARD LAYOUT

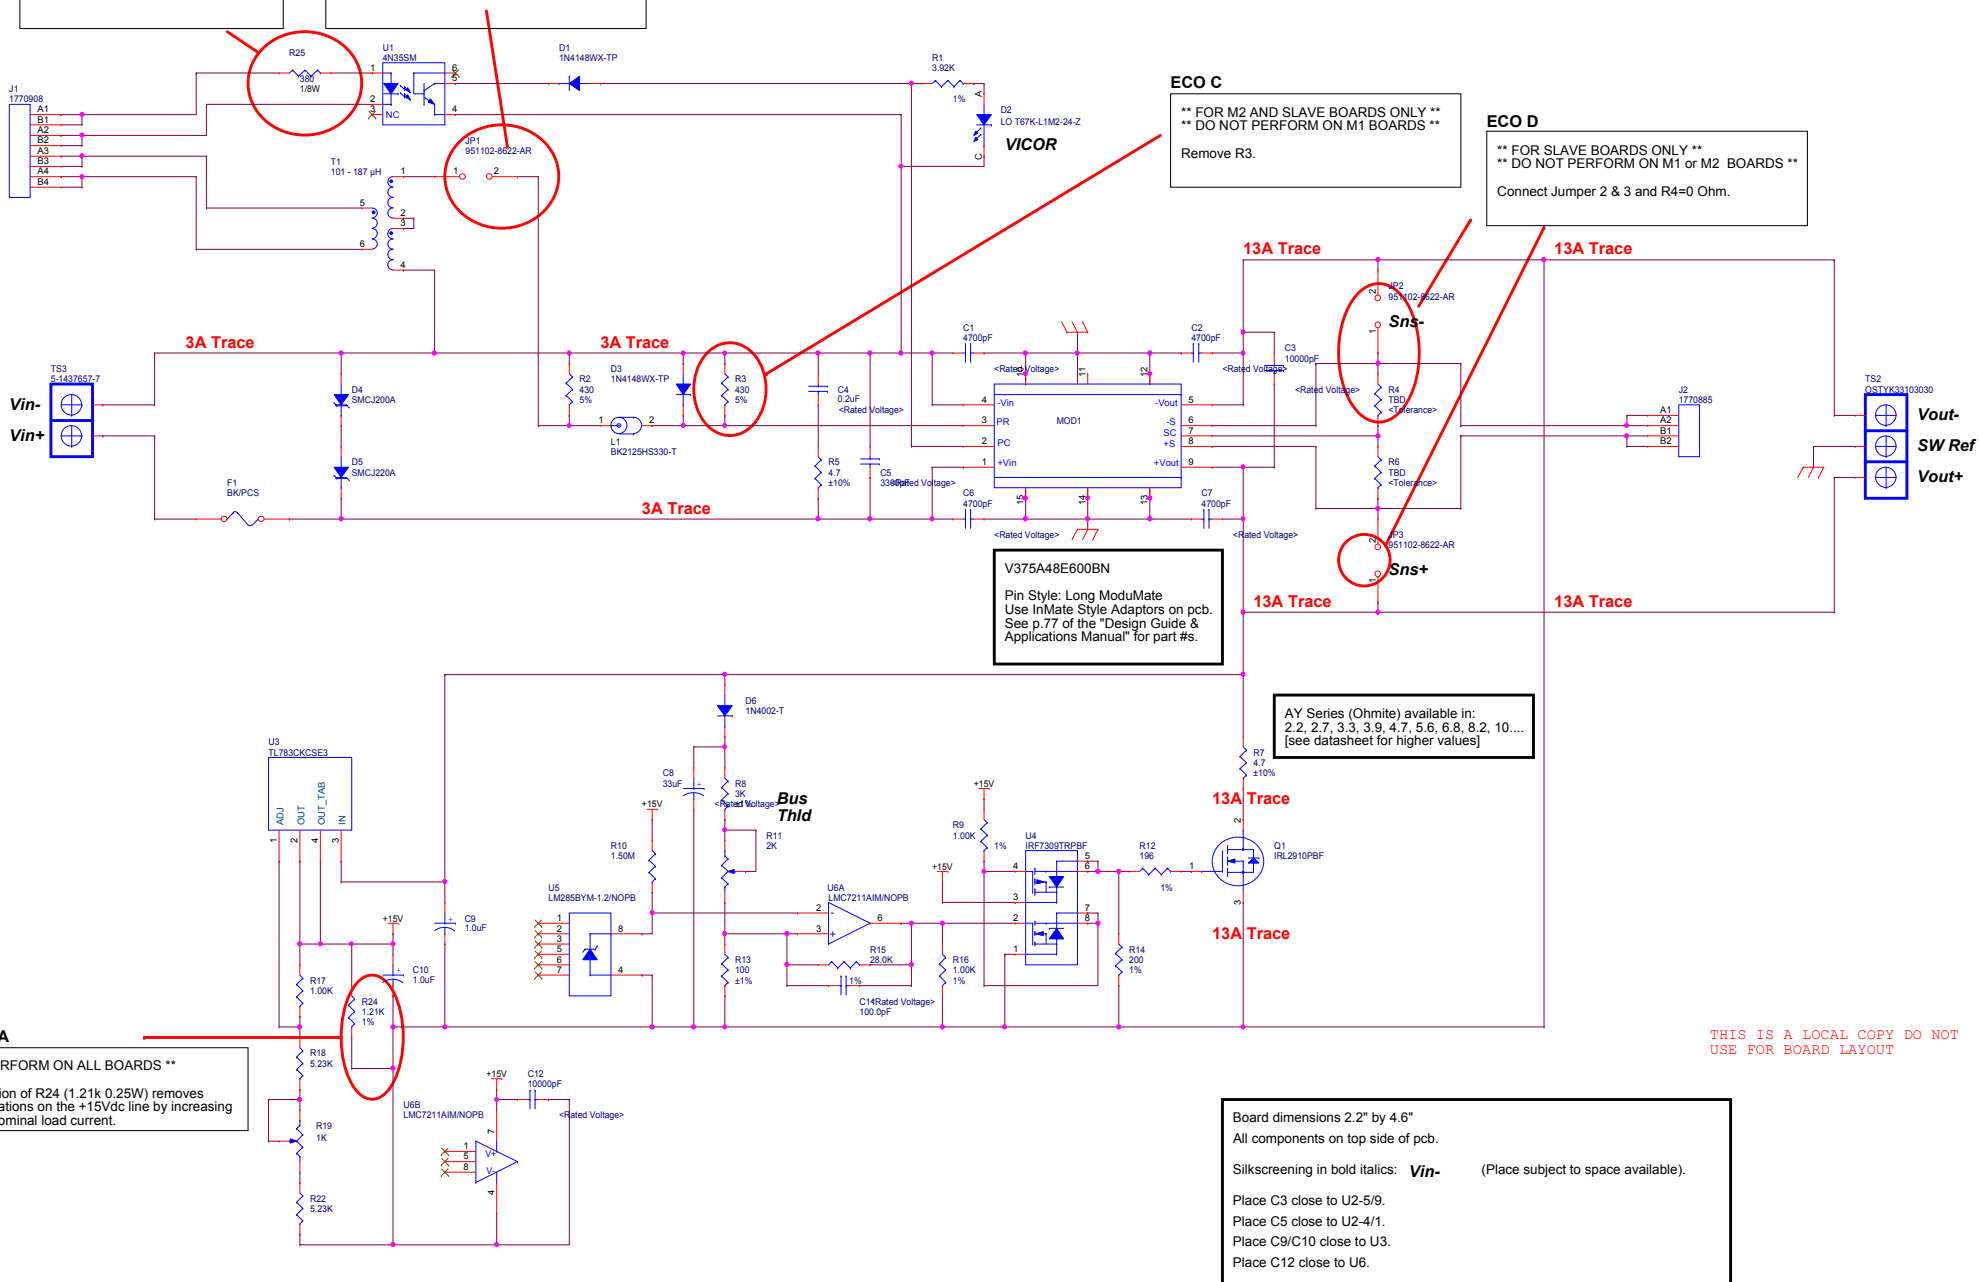

THIS IS A LOCAL COPY DO NOT
USE FOR BOARD LAYOUT

MONTEREY BAY AQUARIUM RESEARCH INSTITUTE
7700 SANDHOLDT ROAD
MOSS LANDING, CA 95039
(831) 775-1700 www.mbari.org
Copyright MBARI 2000

Title	Mini-ROV Vicor Maxi Carrier Board (Thrusters)			Number	<Doc>
Size	Engineer	Layout	Filename	Rev	B
C	Kacy/Sherman	<Layout Eng.>	<Filename>		
Date	Wednesday, May 16, 2018	Sheet	1 of 1		