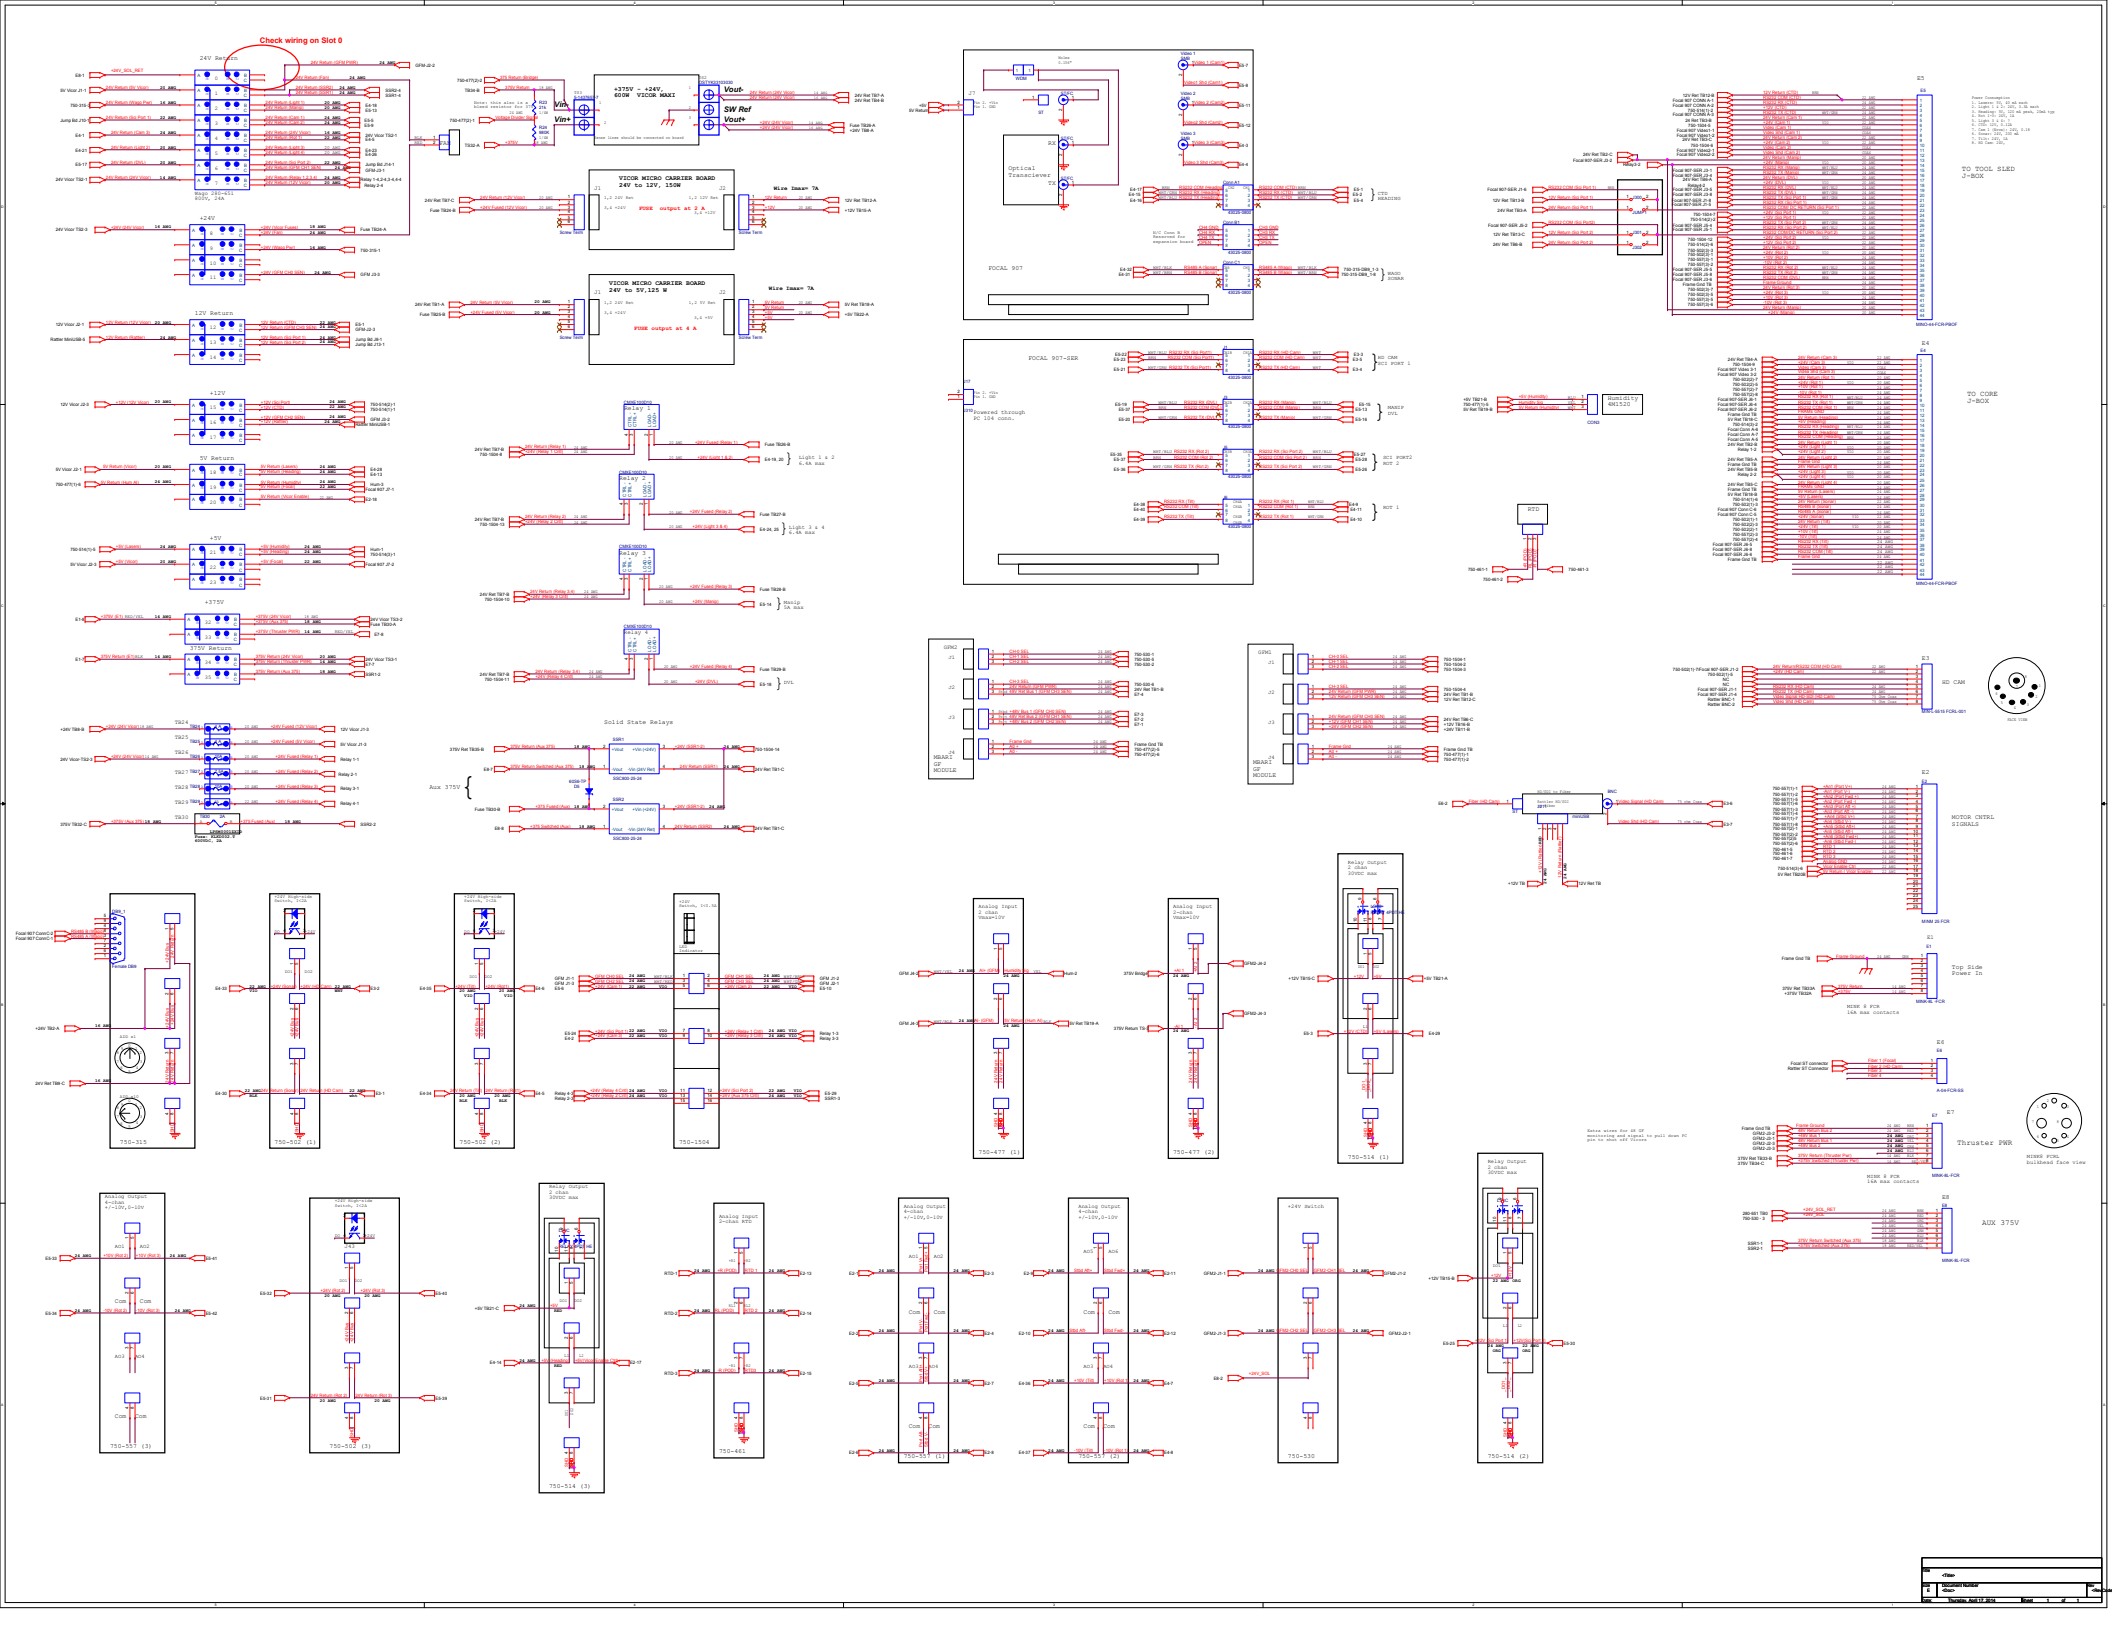
Check wiring on Slot 0
24V Return
+24V
12V Return
+12V
5V Return
+5V
+375V
375V Return
+375V ~ +24V, 60W VICOR MAXI
VICOR MICRO CARRIER BOARD 24V to 12V, 150W
VICOR MICRO CARRIER BOARD 24V to 5V,125 W
FOCAL 907
FOCAL 907-SER
Optical Transceiver
TO TOOL SLED J-BOX
TO CORE J-BOX
Solid State Relays
Aux 375V
MOTOR CNTRL SIGNALS
Top Side Power In
Thruster PWR
AUX 375V
750-315
750-502 (1)
750-502 (2)
750-1504
750-477 (1)
750-477 (2)
750-514 (1)
750-557 (3)
750-502 (3)
750-514 (3)
750-461
750-557 (1)
750-557 (2)
750-530
750-514 (2)