

THIS IS A LOCAL COPY DO NOT
USE FOR BOARD LAYOUT

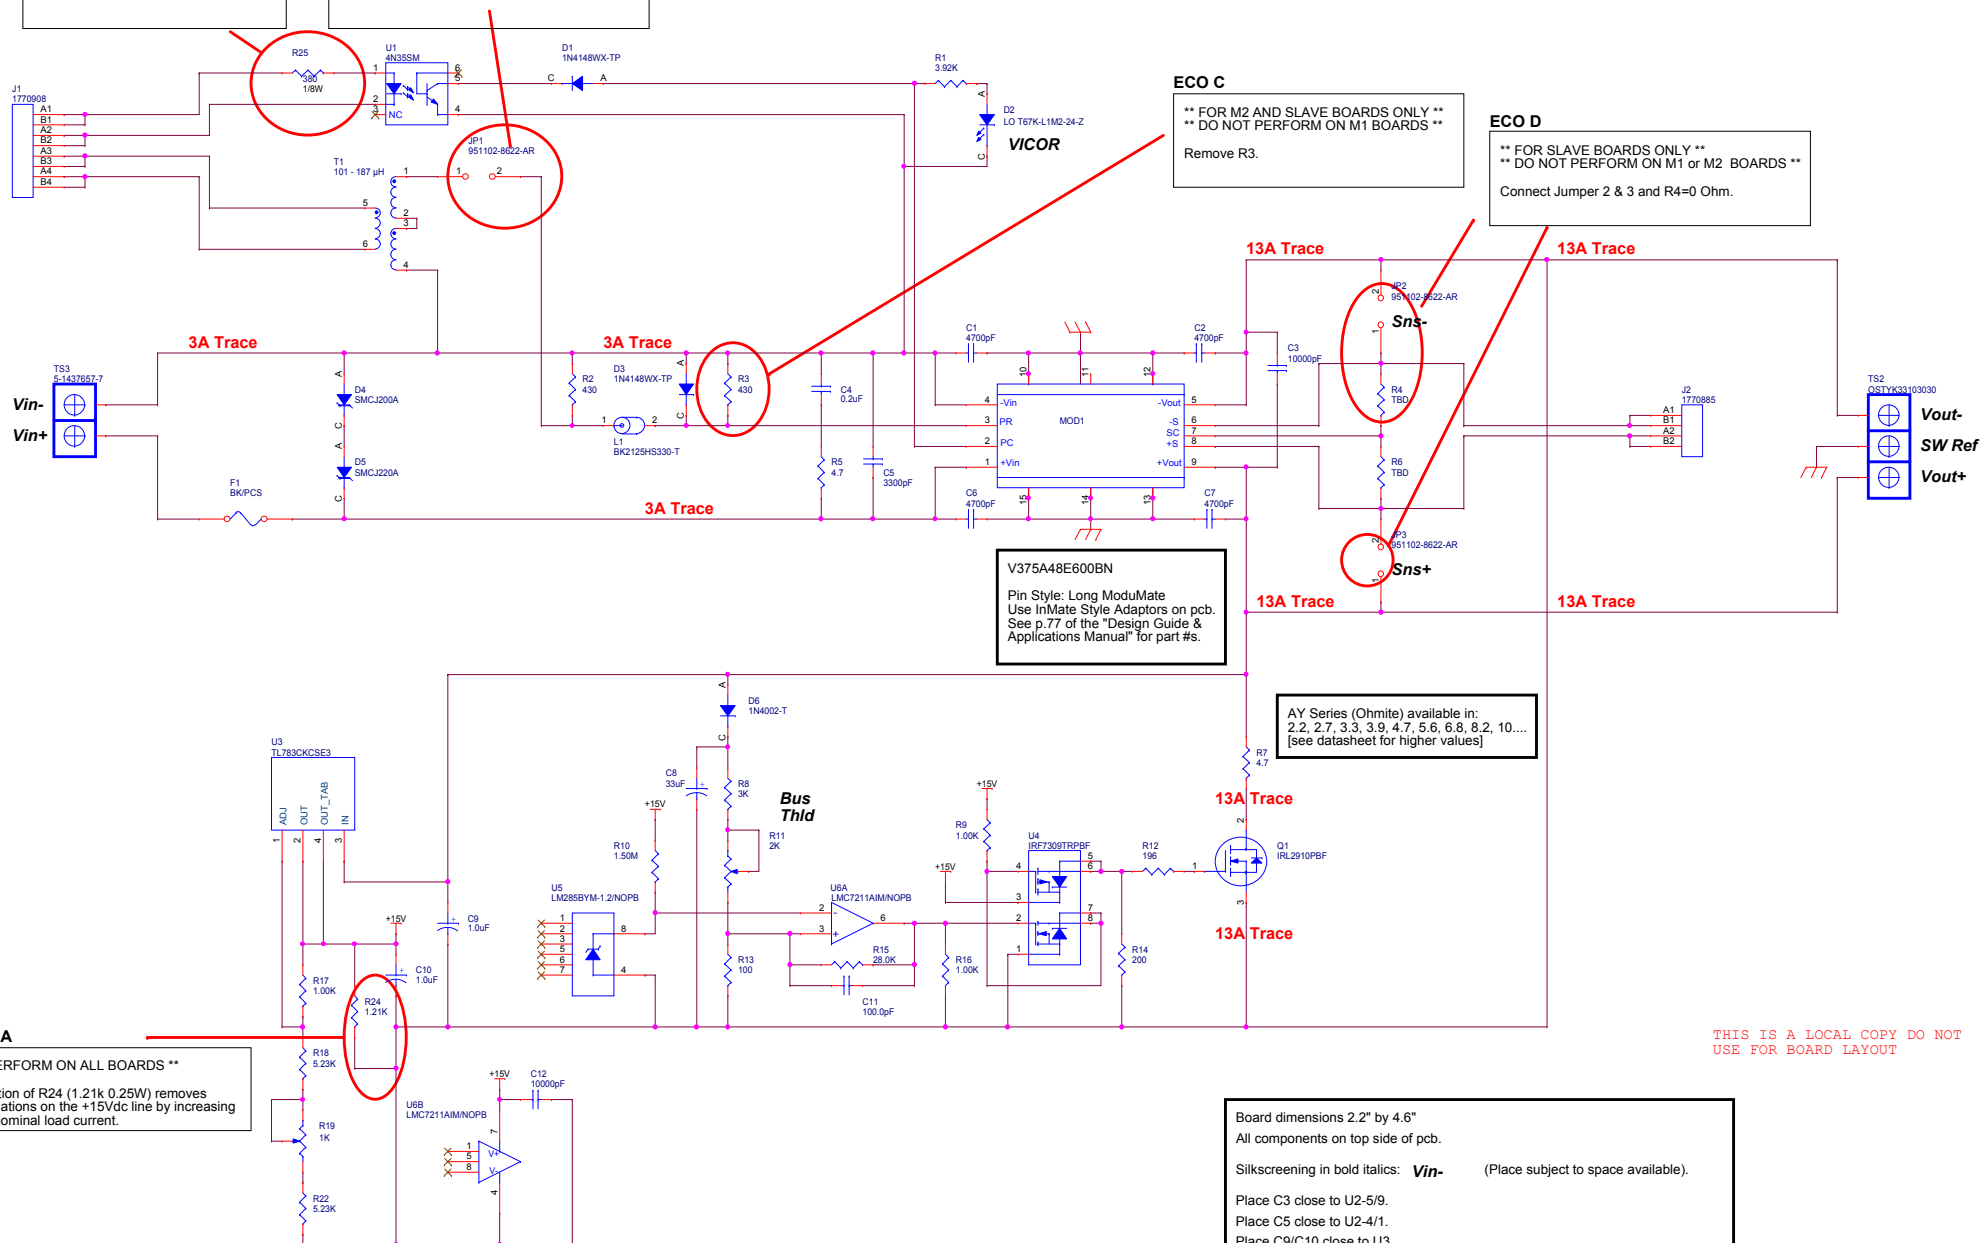
ECO E

**** FOR ALL BOARDS****

Add inline resistor R25.

** FOR ALL BOARDS **

Connect Jumper 1.

**SN#**

Solid white silkscreening for SN#

Board dimensions 2.2" by 4.6"
All components on top side of pcb.

Silkscreening in bold italics: ***Vin-*** (Place subject to space available).

Place C3 close to U2-5/9.

Place C5 close to U2-4/1.

Place C9/C10 close to U3

Place C12 close to U6.

MONTEREY BAY AQUARIUM RESEARCH INSTITUTE
7700 SANDHOLDT ROAD
MOSS LANDING, CA 95039
(831) 775-1700 www.mbari.org



Copyright MBARI 2000									
Title Mini-ROV Vicor Maxi Carrier Board								Number <Doc>	
Size C	Engineer	Layout			Filename			R	
	Key/Sherman	<Layout Eng.>			<Filename>				
	Date:	Monday, May 10, 2014			Sheet	1 of 1			