
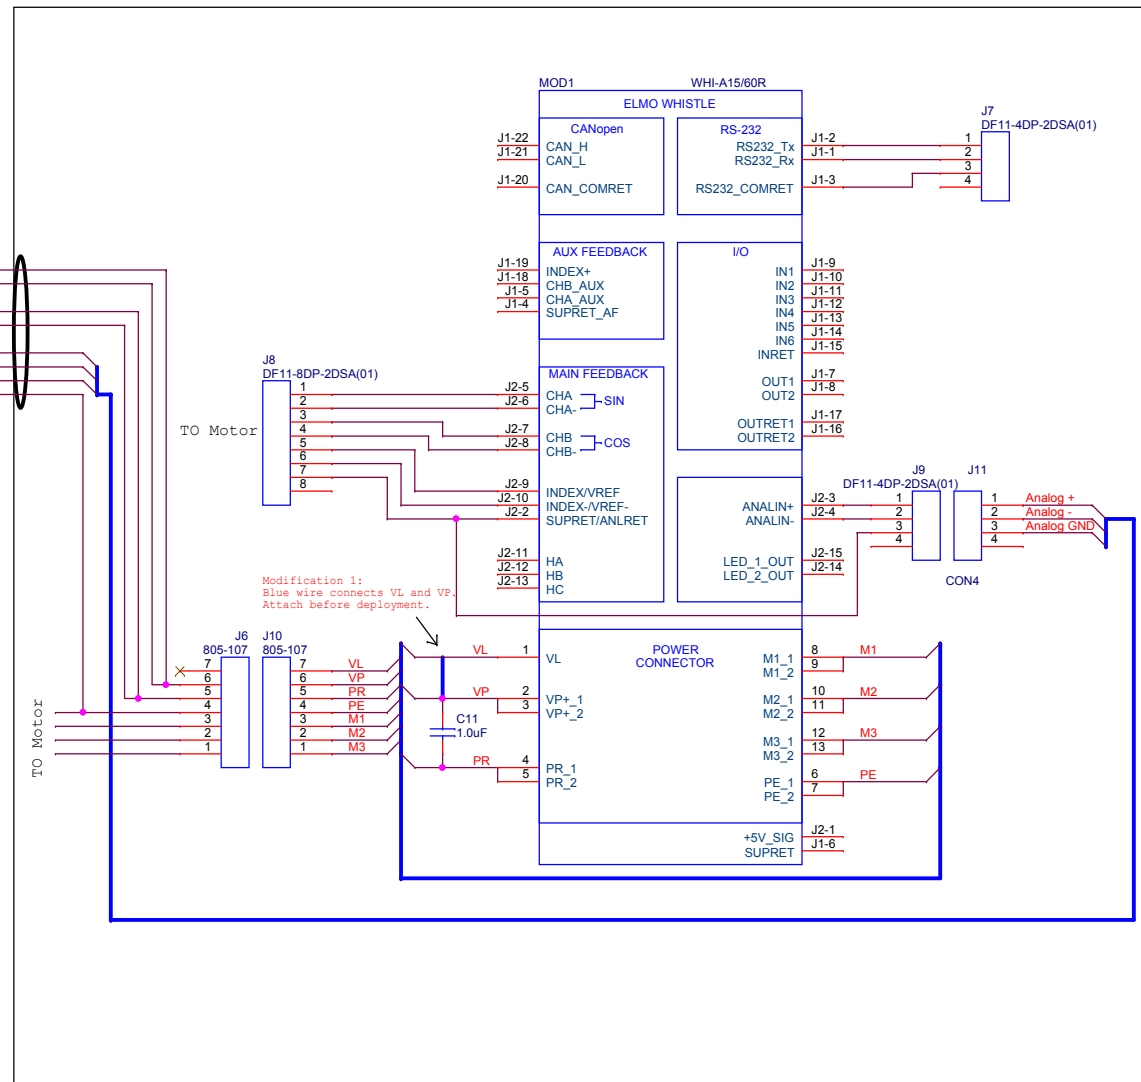


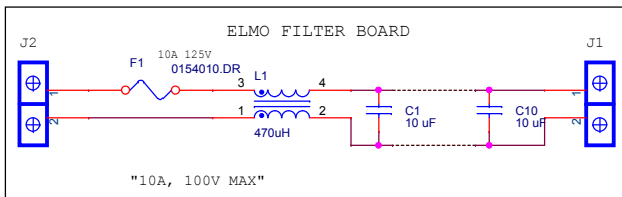

Monterey Bay Aquarium Research Institute
7700 Sandhold Road, Moss Landing, CA 95039

Title
MiniROV: Thruster Motor Assm.

Engineer A. Sherman	Size B	Document Number <Doc>	Layout File <Layout File>	Rev <Rev>
Layout <Layout>	Date:	Tuesday, March 25, 2014	Sheet 1 of 1	