


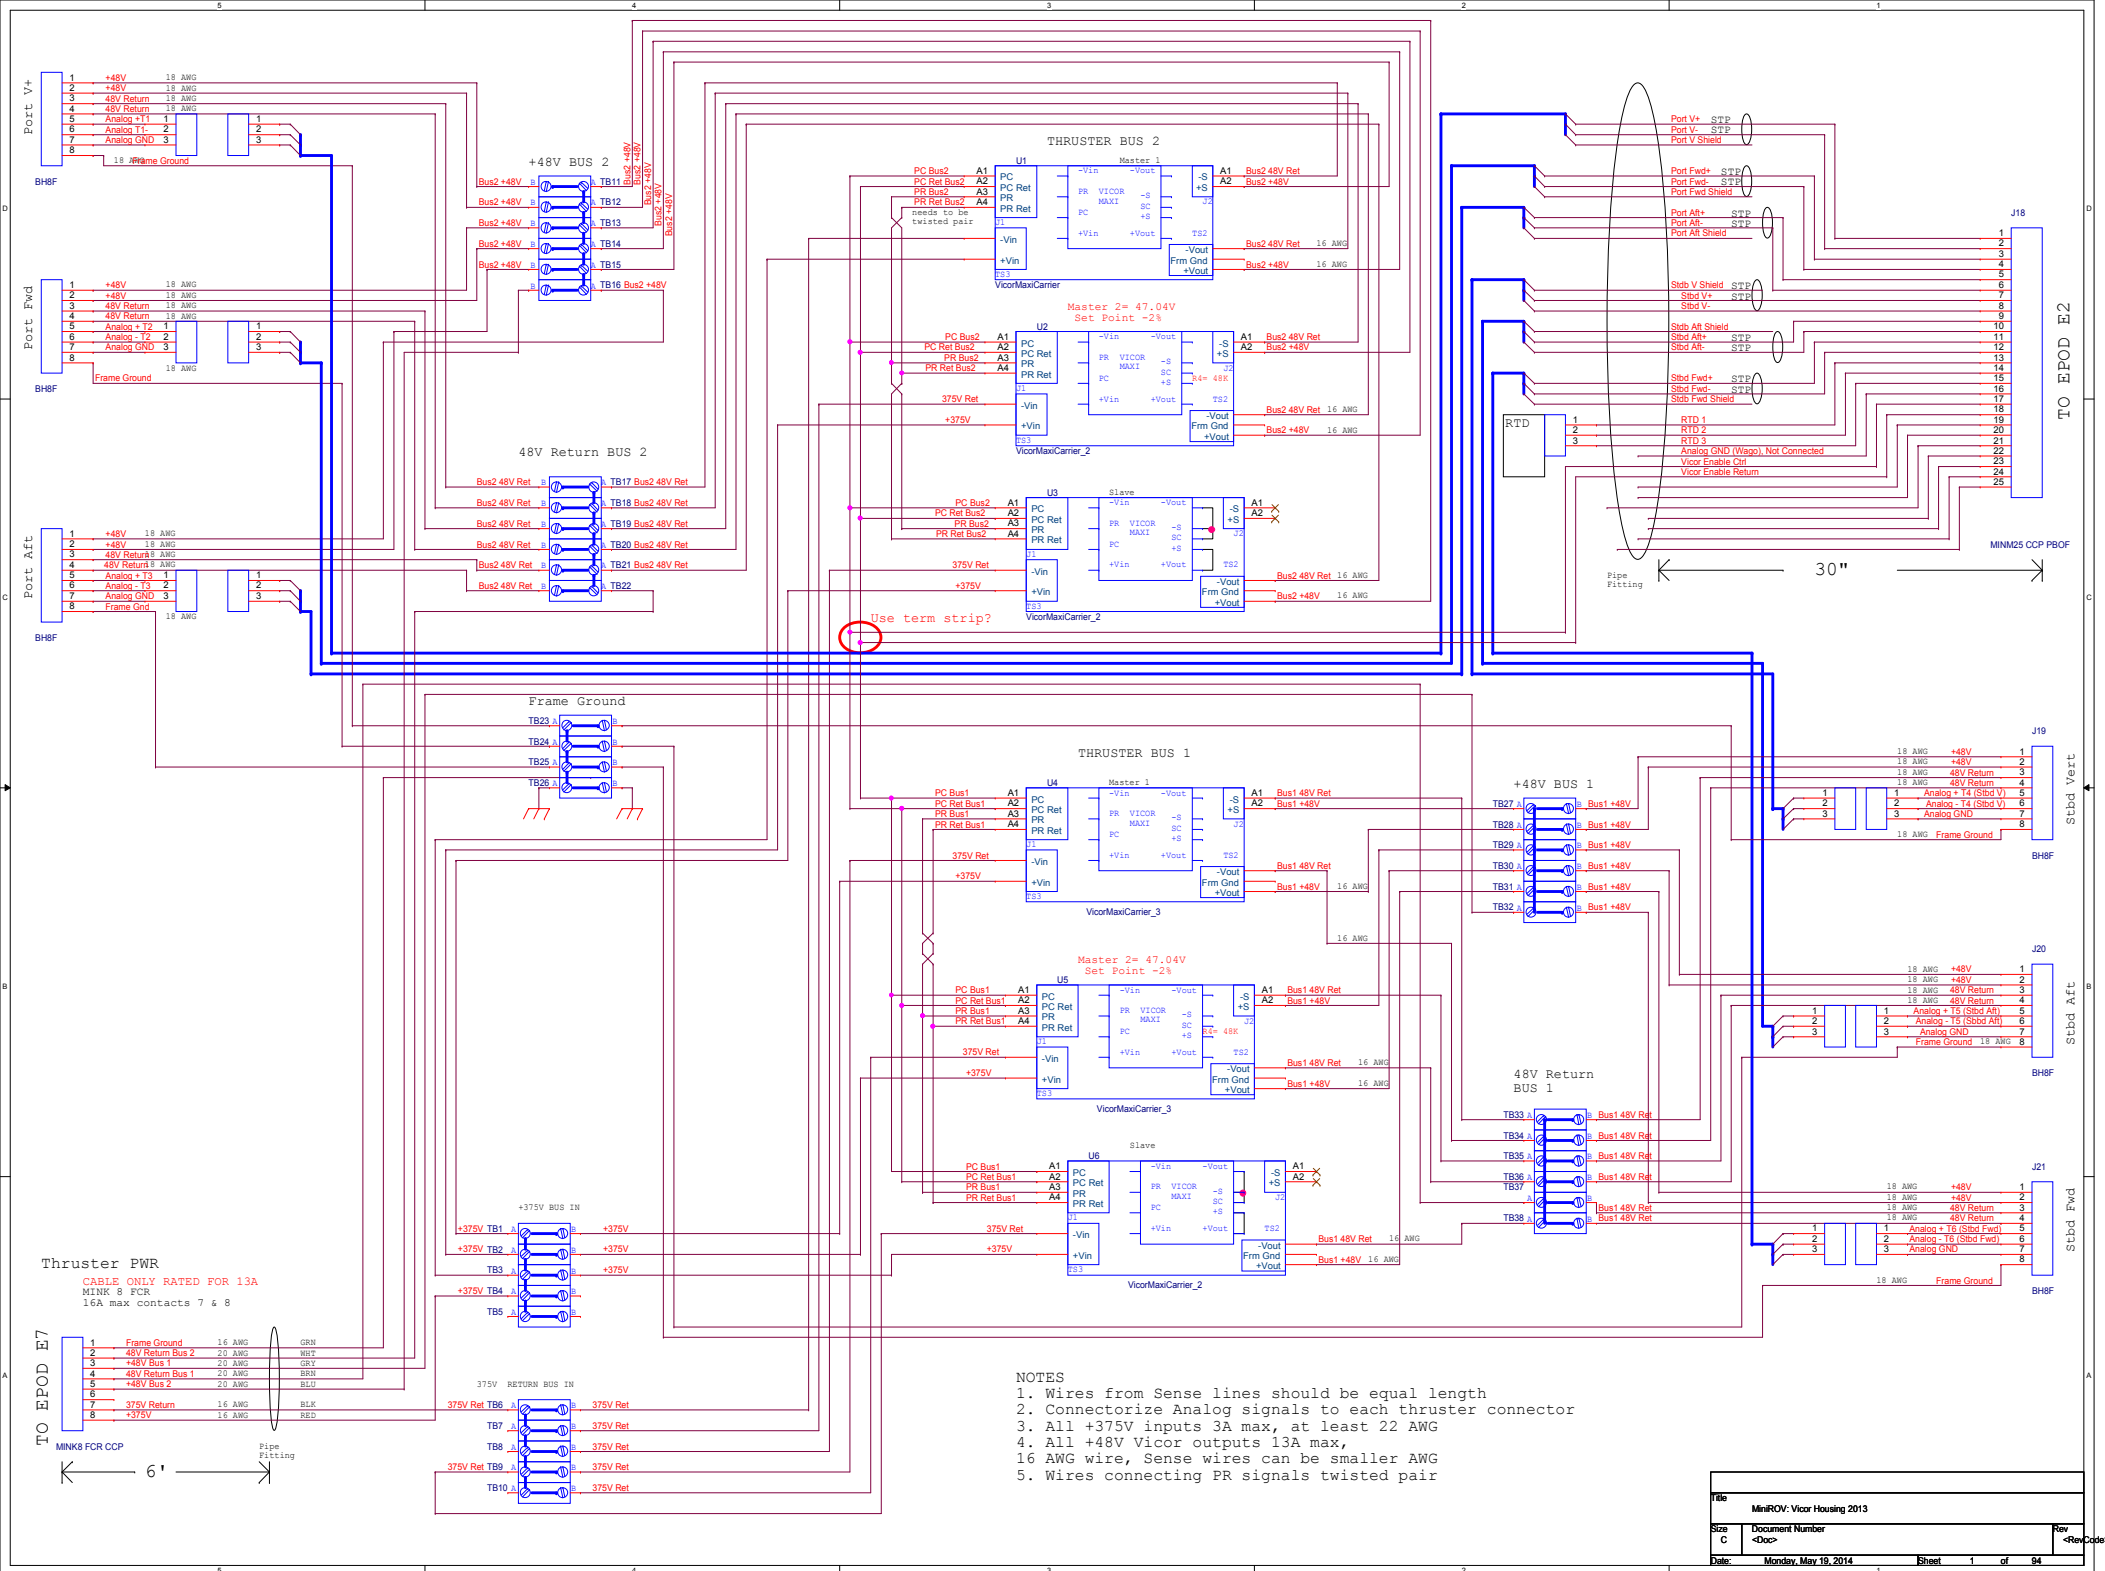

File MiniROV: Vicor Housing 2013			
Size C	Document Number <Doc>	Rev <Rev Code>	
Date: Monday, May 19, 2014	Sheet 1	of 94	