


ECO E

**** FOR ALL BOARDS ****

Connect Jumper 1.

THIS IS A LOCAL COPY DO NOT
USE FOR BOARD LAYOUT

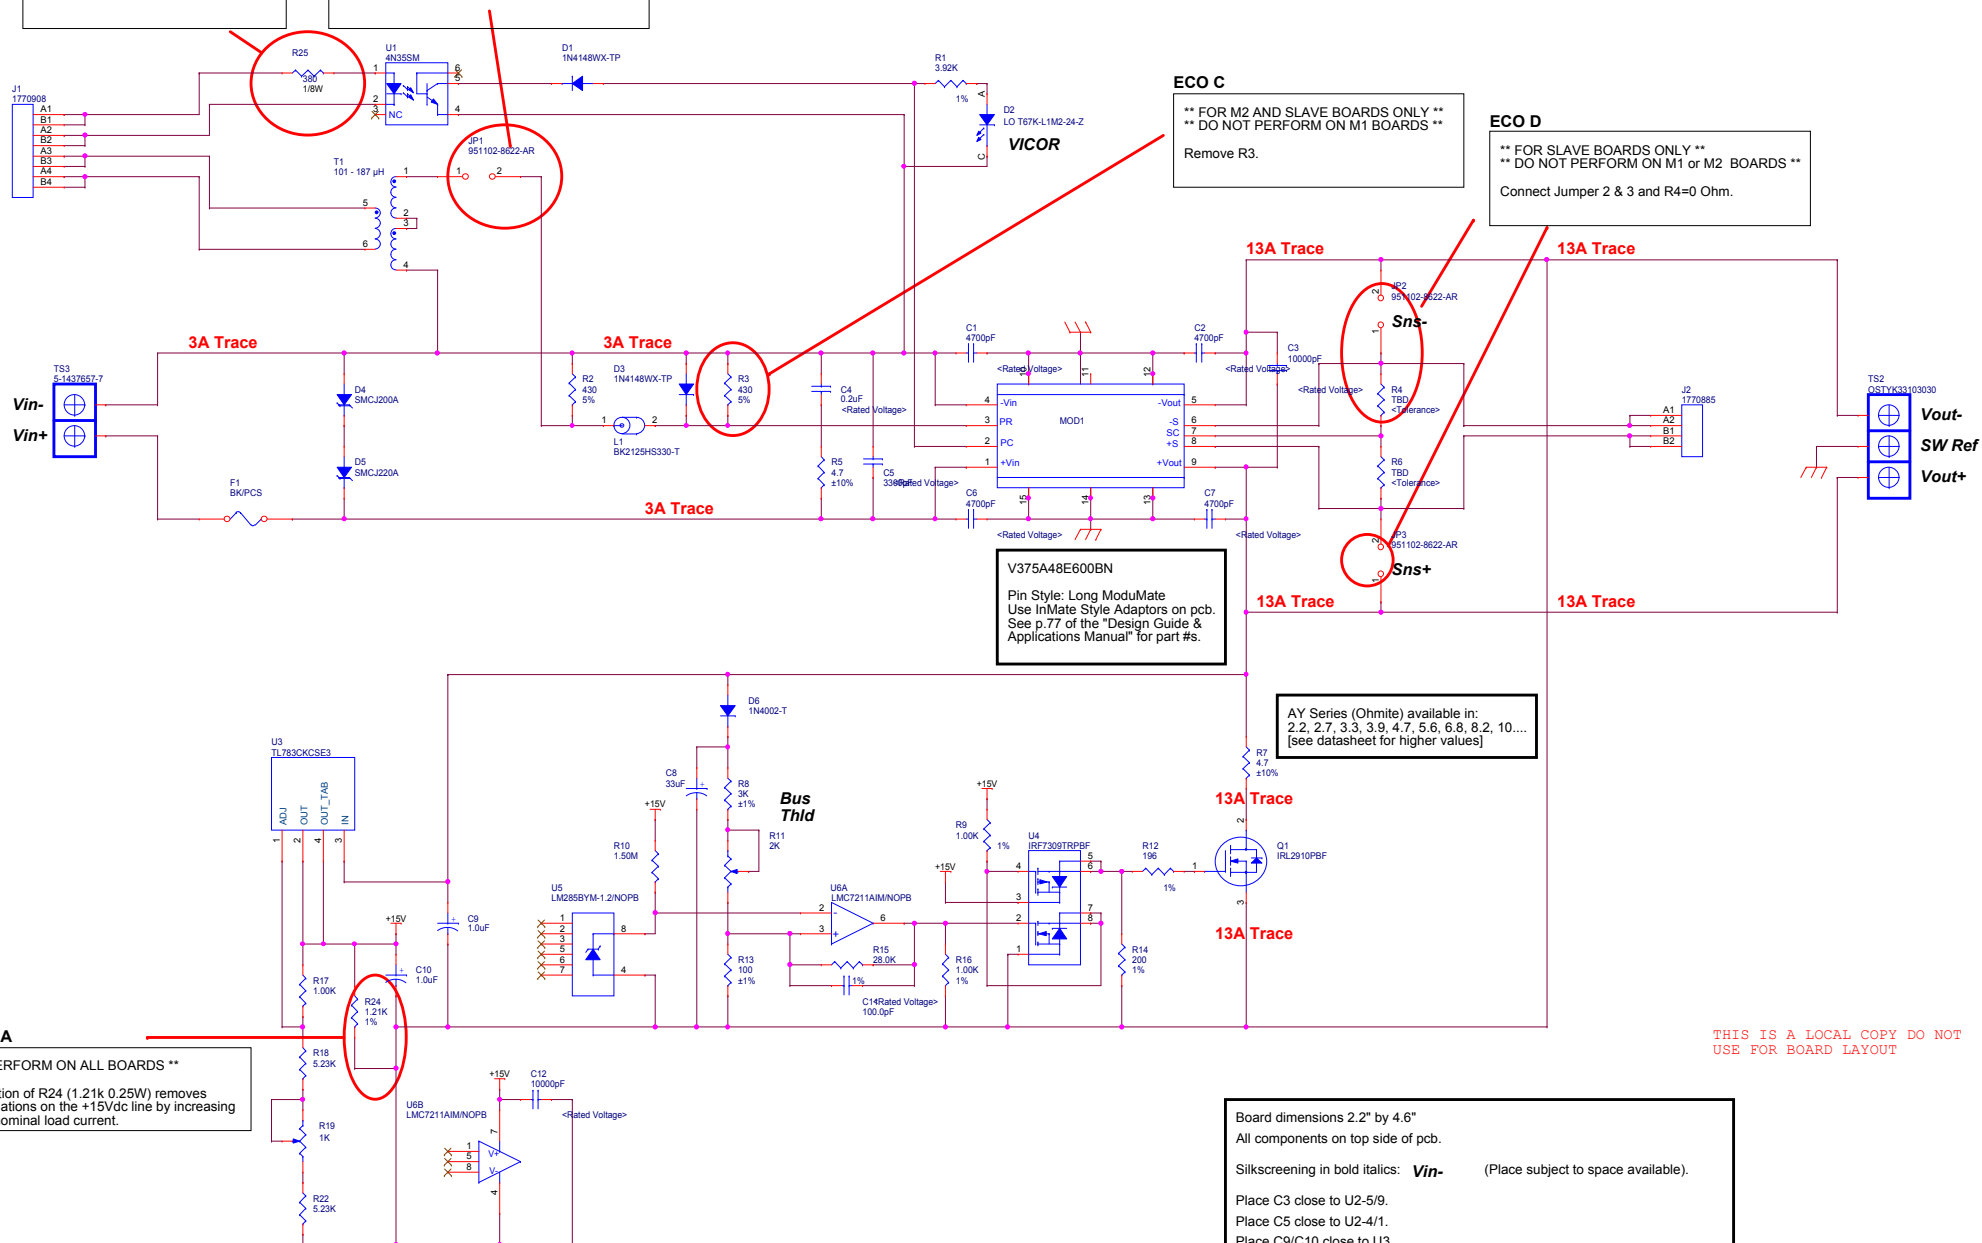

THIS IS A LOCAL COPY DO NOT
USE FOR BOARD LAYOUT

SN#

Solid white silkscreening for SN#

Board dimensions 2.2" by 4.6"
All components on top side of pcb.

Silkscreening in bold italics: ***Vin-*** (Place subject to space available).

Place C3 close to U2-5/9.

Place C5 close to U2-4/1.

Place C9/C10 close to U3

Place C12 close to U6.

MONTEREY BAY AQUARIUM RESEARCH INSTITUTE
7700 SANDHOLDT ROAD
MOSS LANDING, CA 95039
(831) 775-1700 www.mbari.org



Copyright MBARI 2000				
Title Mini-ROV Vicor Maxi Carrier Board (Thrusters)				Number <Doc>
Size	Engineer	Layout	Filename	Revisions
C	Key/Sherman	<Layout Eng>	<Filename>	
Date: Thursday, March 31, 2016		Sheet	1 of 1	