


ECO F

**** FOR ALL BOARDS****
Add inline resistor R25.

ECO E

**** FOR ALL BOARDS ****
Connect Jumper 1.

THIS IS A LOCAL COPY DO NOT
USE FOR BOARD LAYOUT

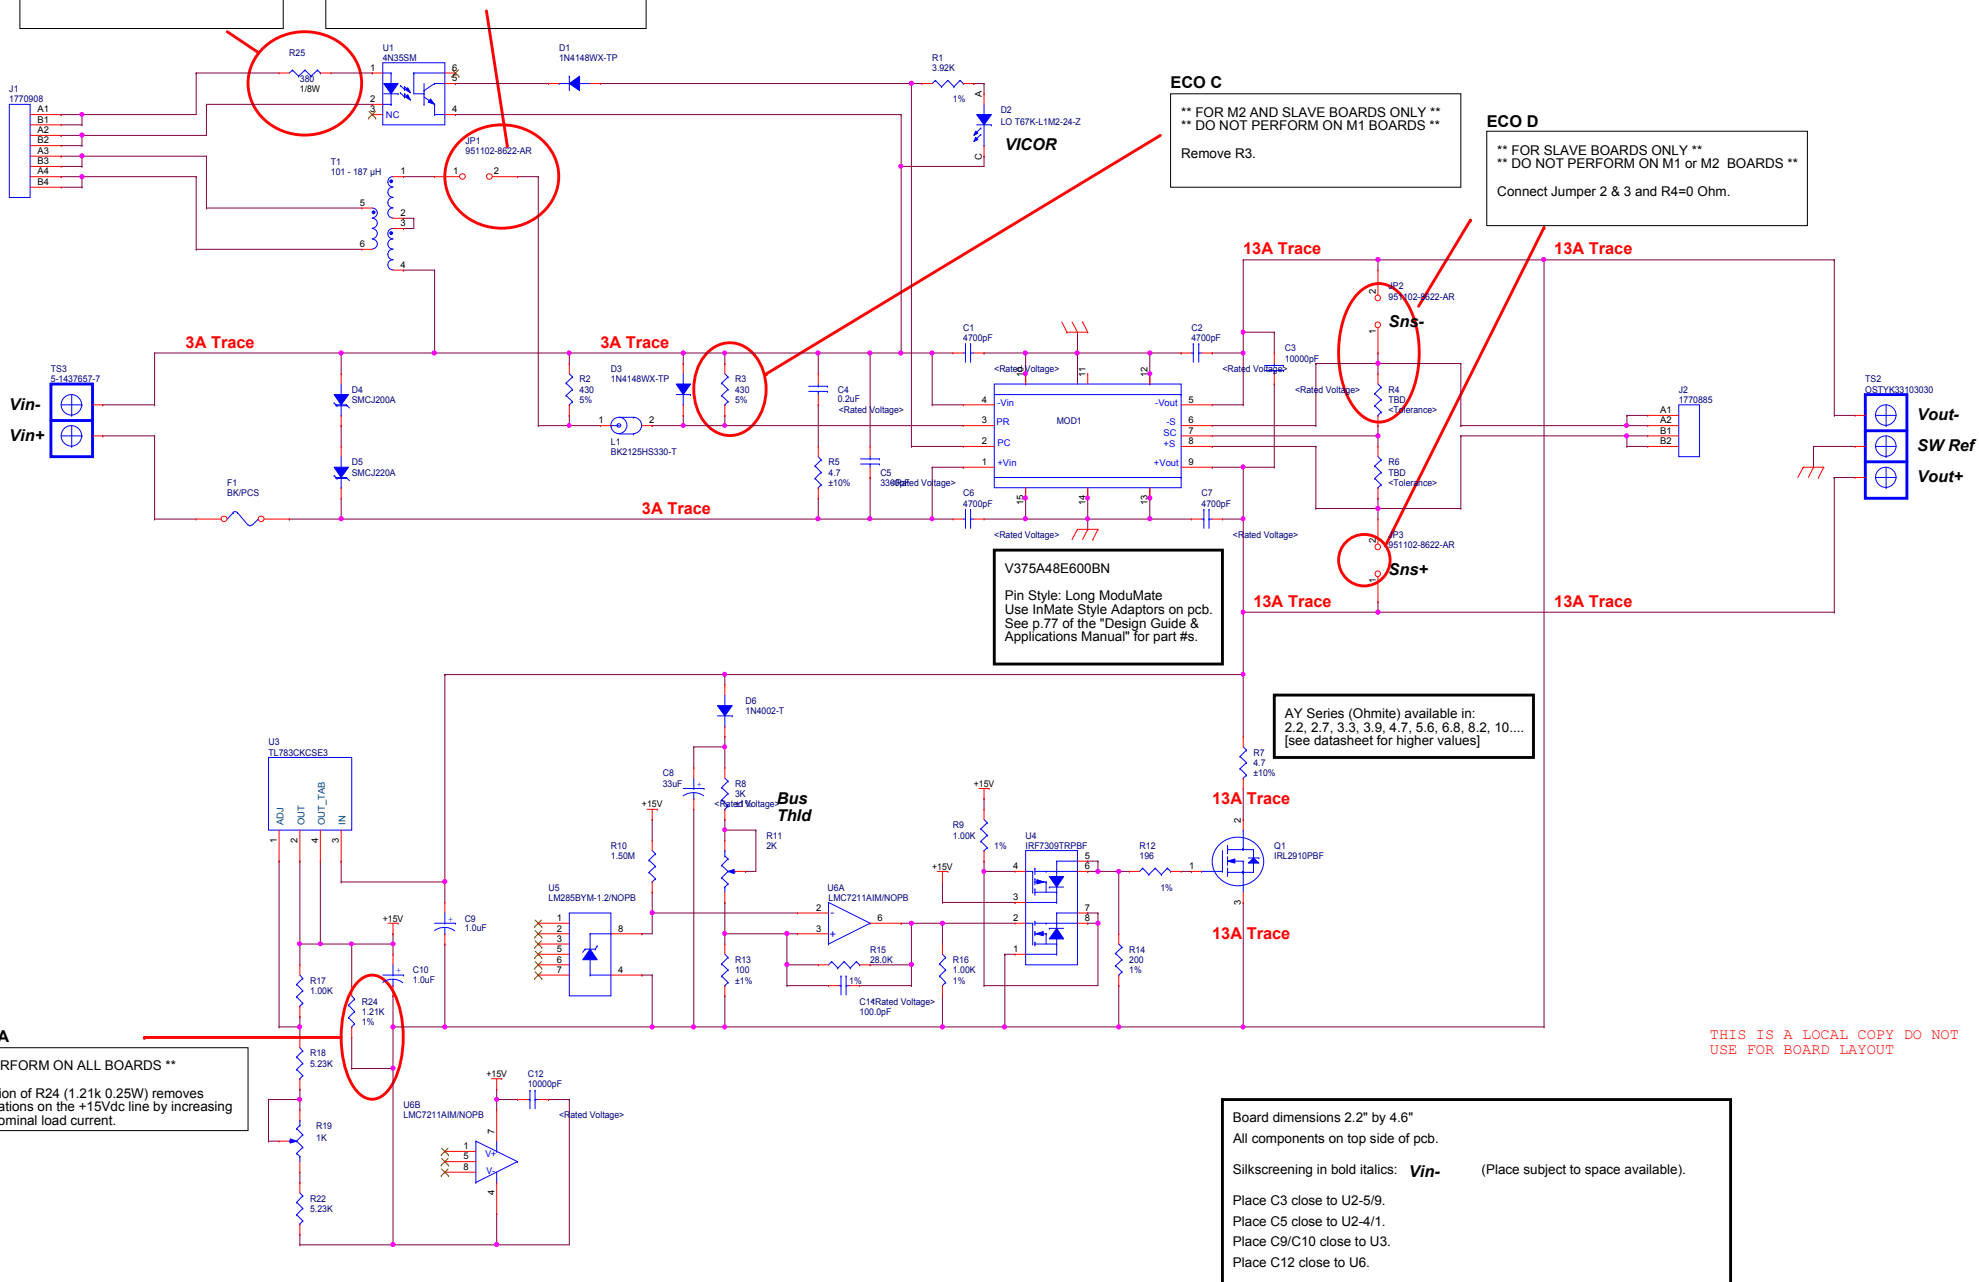

THIS IS A LOCAL COPY DO NOT
USE FOR BOARD LAYOUT

SN#

Solid white silkscreening for SN#

MONTEREY BAY AQUARIUM RESEARCH INSTITUTE
7700 SANDHOLDT ROAD
MOSS LANDING, CA 95039
(831) 775-1700 www.mbari.org
Copyright MBARI 2000

Title	Mini-ROV Vicor Maxi Carrier Board (Thrusters)	Number	<Doc>
Size	Engineer Kacy/Sherman	Layout	<Layout Eng.>
Date	Wednesday, May 16, 2018	Filename	<Filename>
Sheet	1	of	1
Rev	B		