


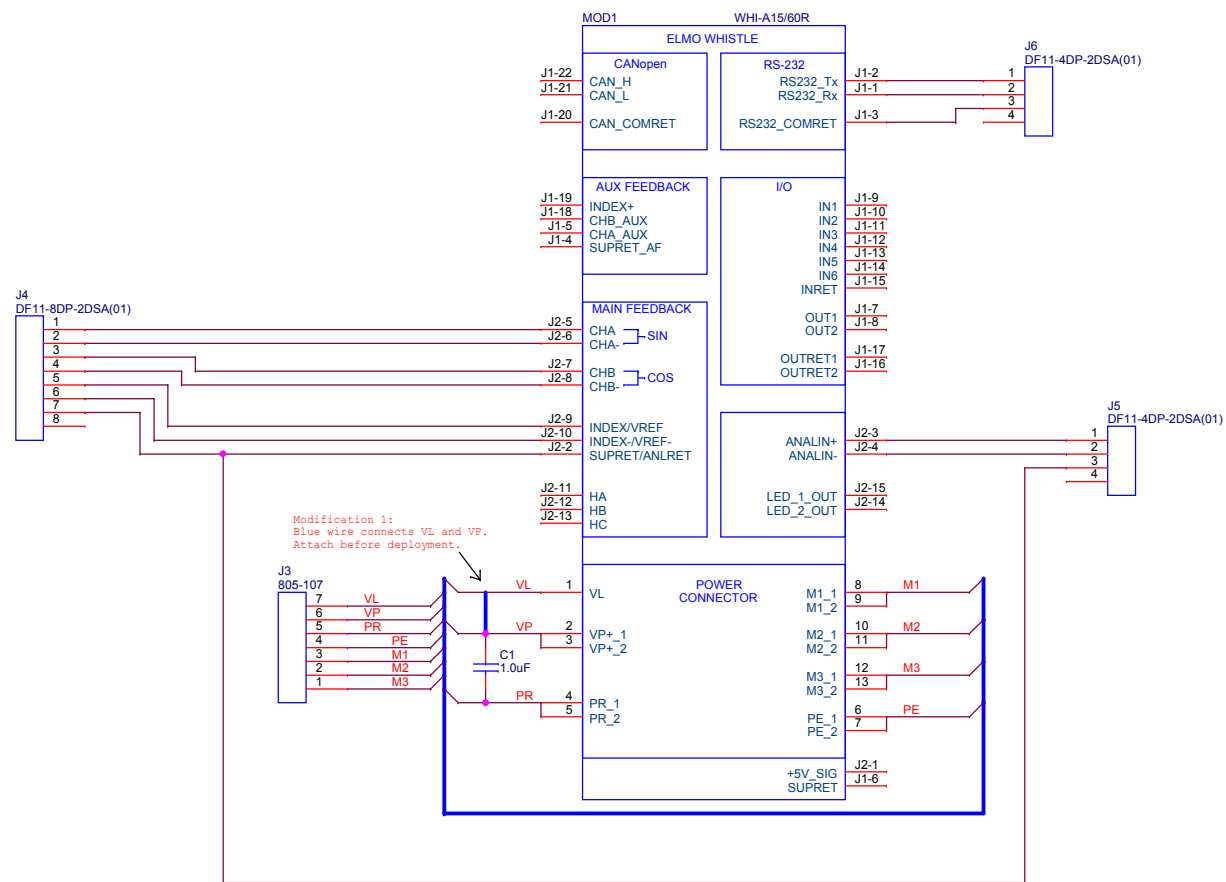

		Monterey Bay Aquarium Research Institute 7700 Sandhold Road, Moss Landing, CA 95039	
		Title ROV1k WHISTLE ADAPTER	
Engineer DALE GRAVES	Size B	Document Number 10020690	Layout File <Layout File>
Layout JOSE ROSAL	Date Tuesday, March 25, 2014	Sheet 1 of 1	Rev A-1