


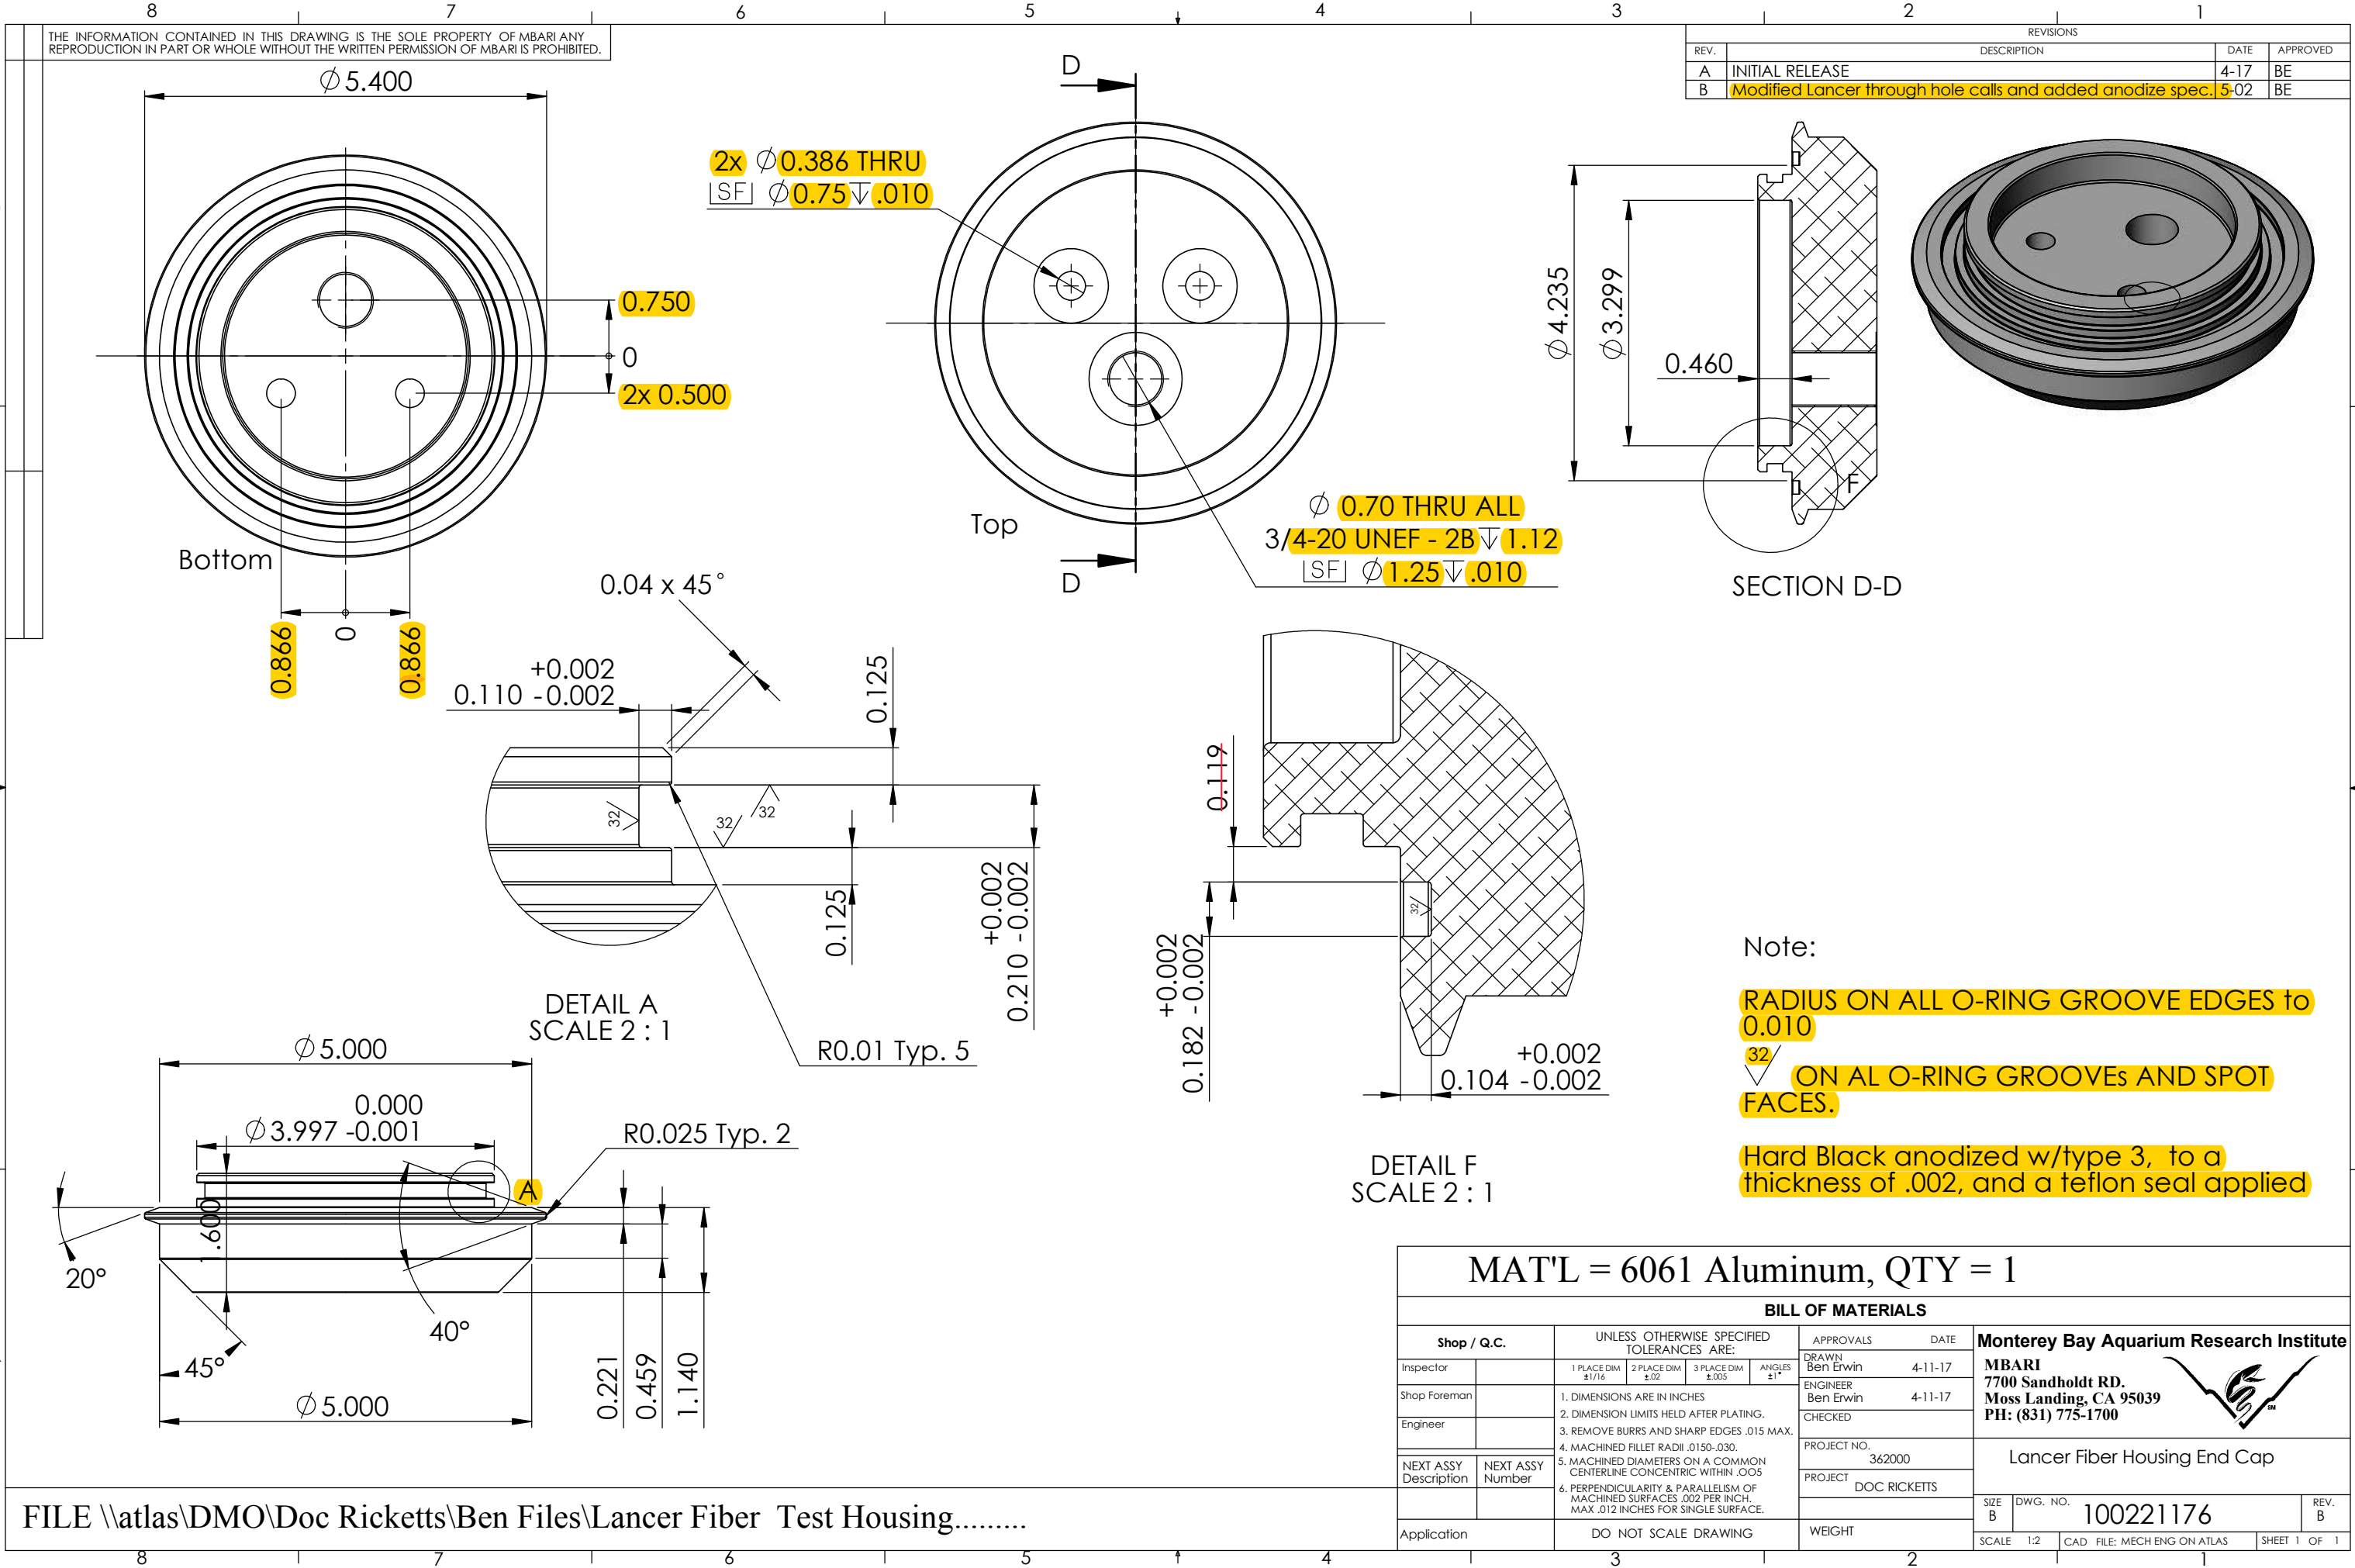

FILE \\atlas\DMO\Doc Ricketts\Ben Files\Lancer Fiber Test Housing.....