


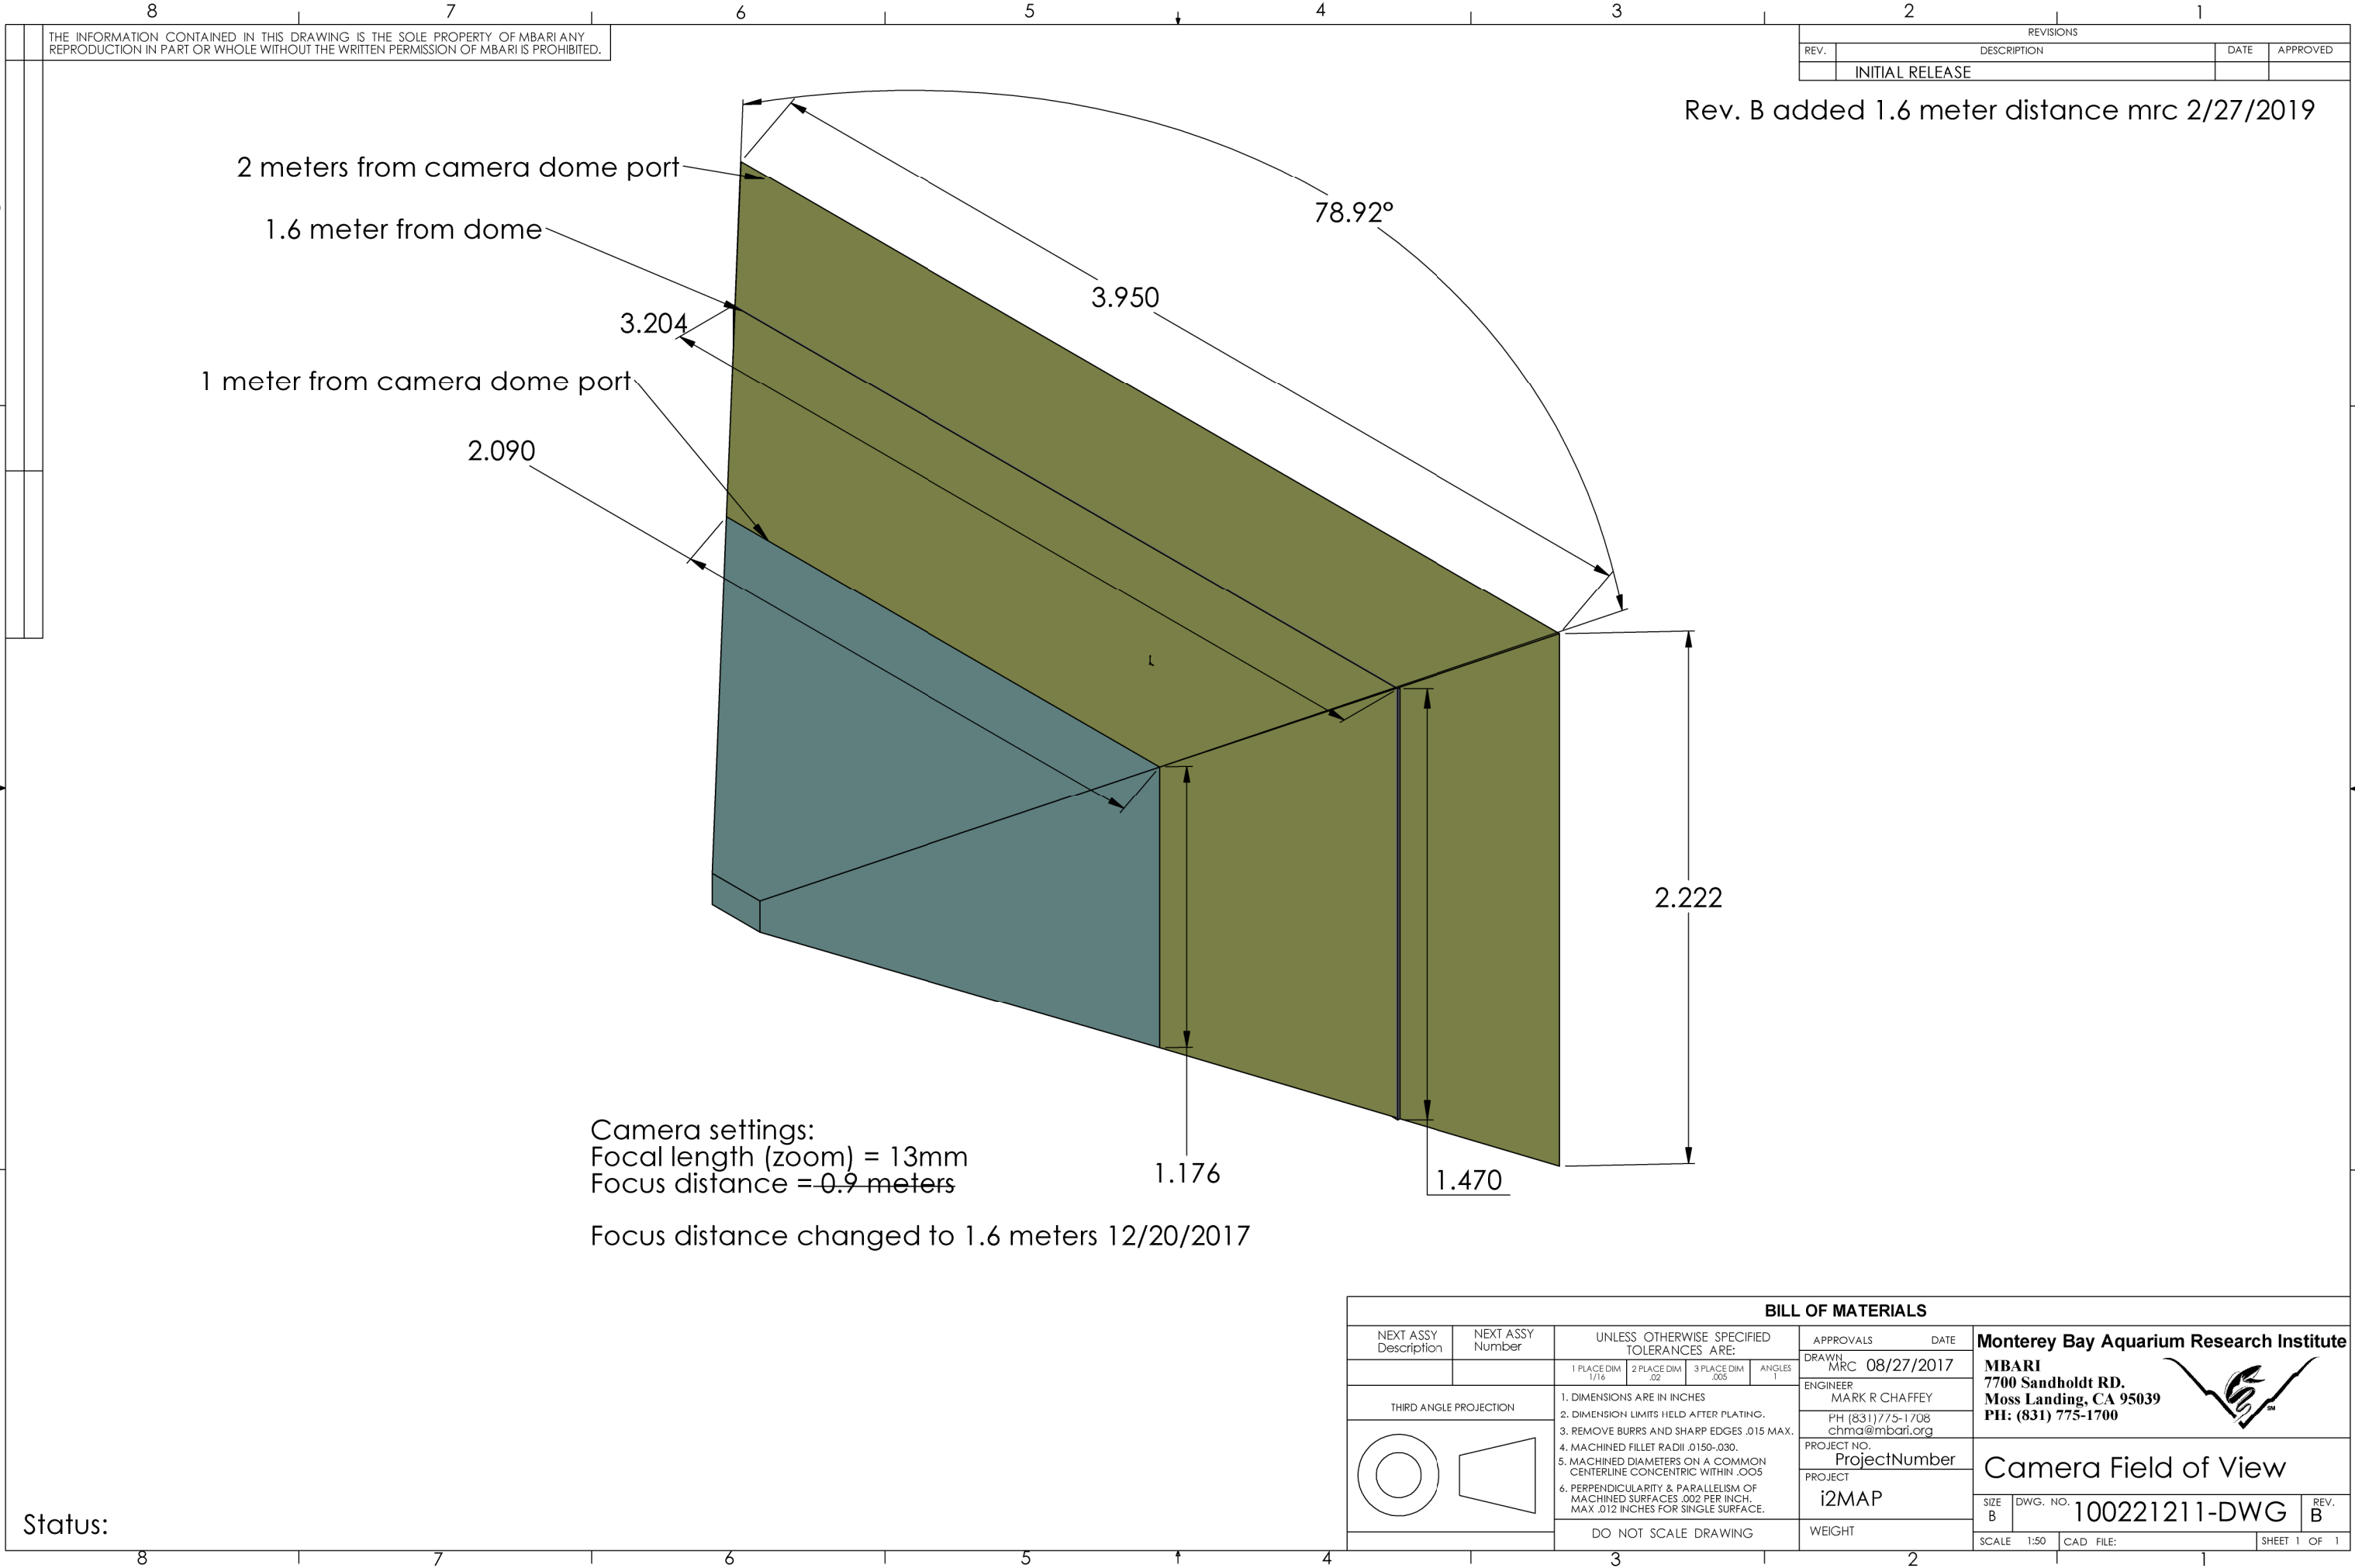

Status:

BILL OF MATERIALS									
NEXT ASSY Description		NEXT ASSY Number		UNLESS OTHERWISE SPECIFIED TOLERANCES ARE:			APPROVALS		DATE
				1 PLACE DIM 1/16	2 PLACE DIM .02	3 PLACE DIM .005	ANGLES 1	DRAWN	08/27/2017
							ENGINEER		
							MARK R CHAFFEY		
							PH (831) 775-1708		
							chma@mbari.org		
							PROJECT NO.		
							ProjectNumber		
							PROJECT		
							i2MAP		
							WEIGHT		
							SCALE		1:50
							CAD FILE:		
							SHEET 1 OF 1		