


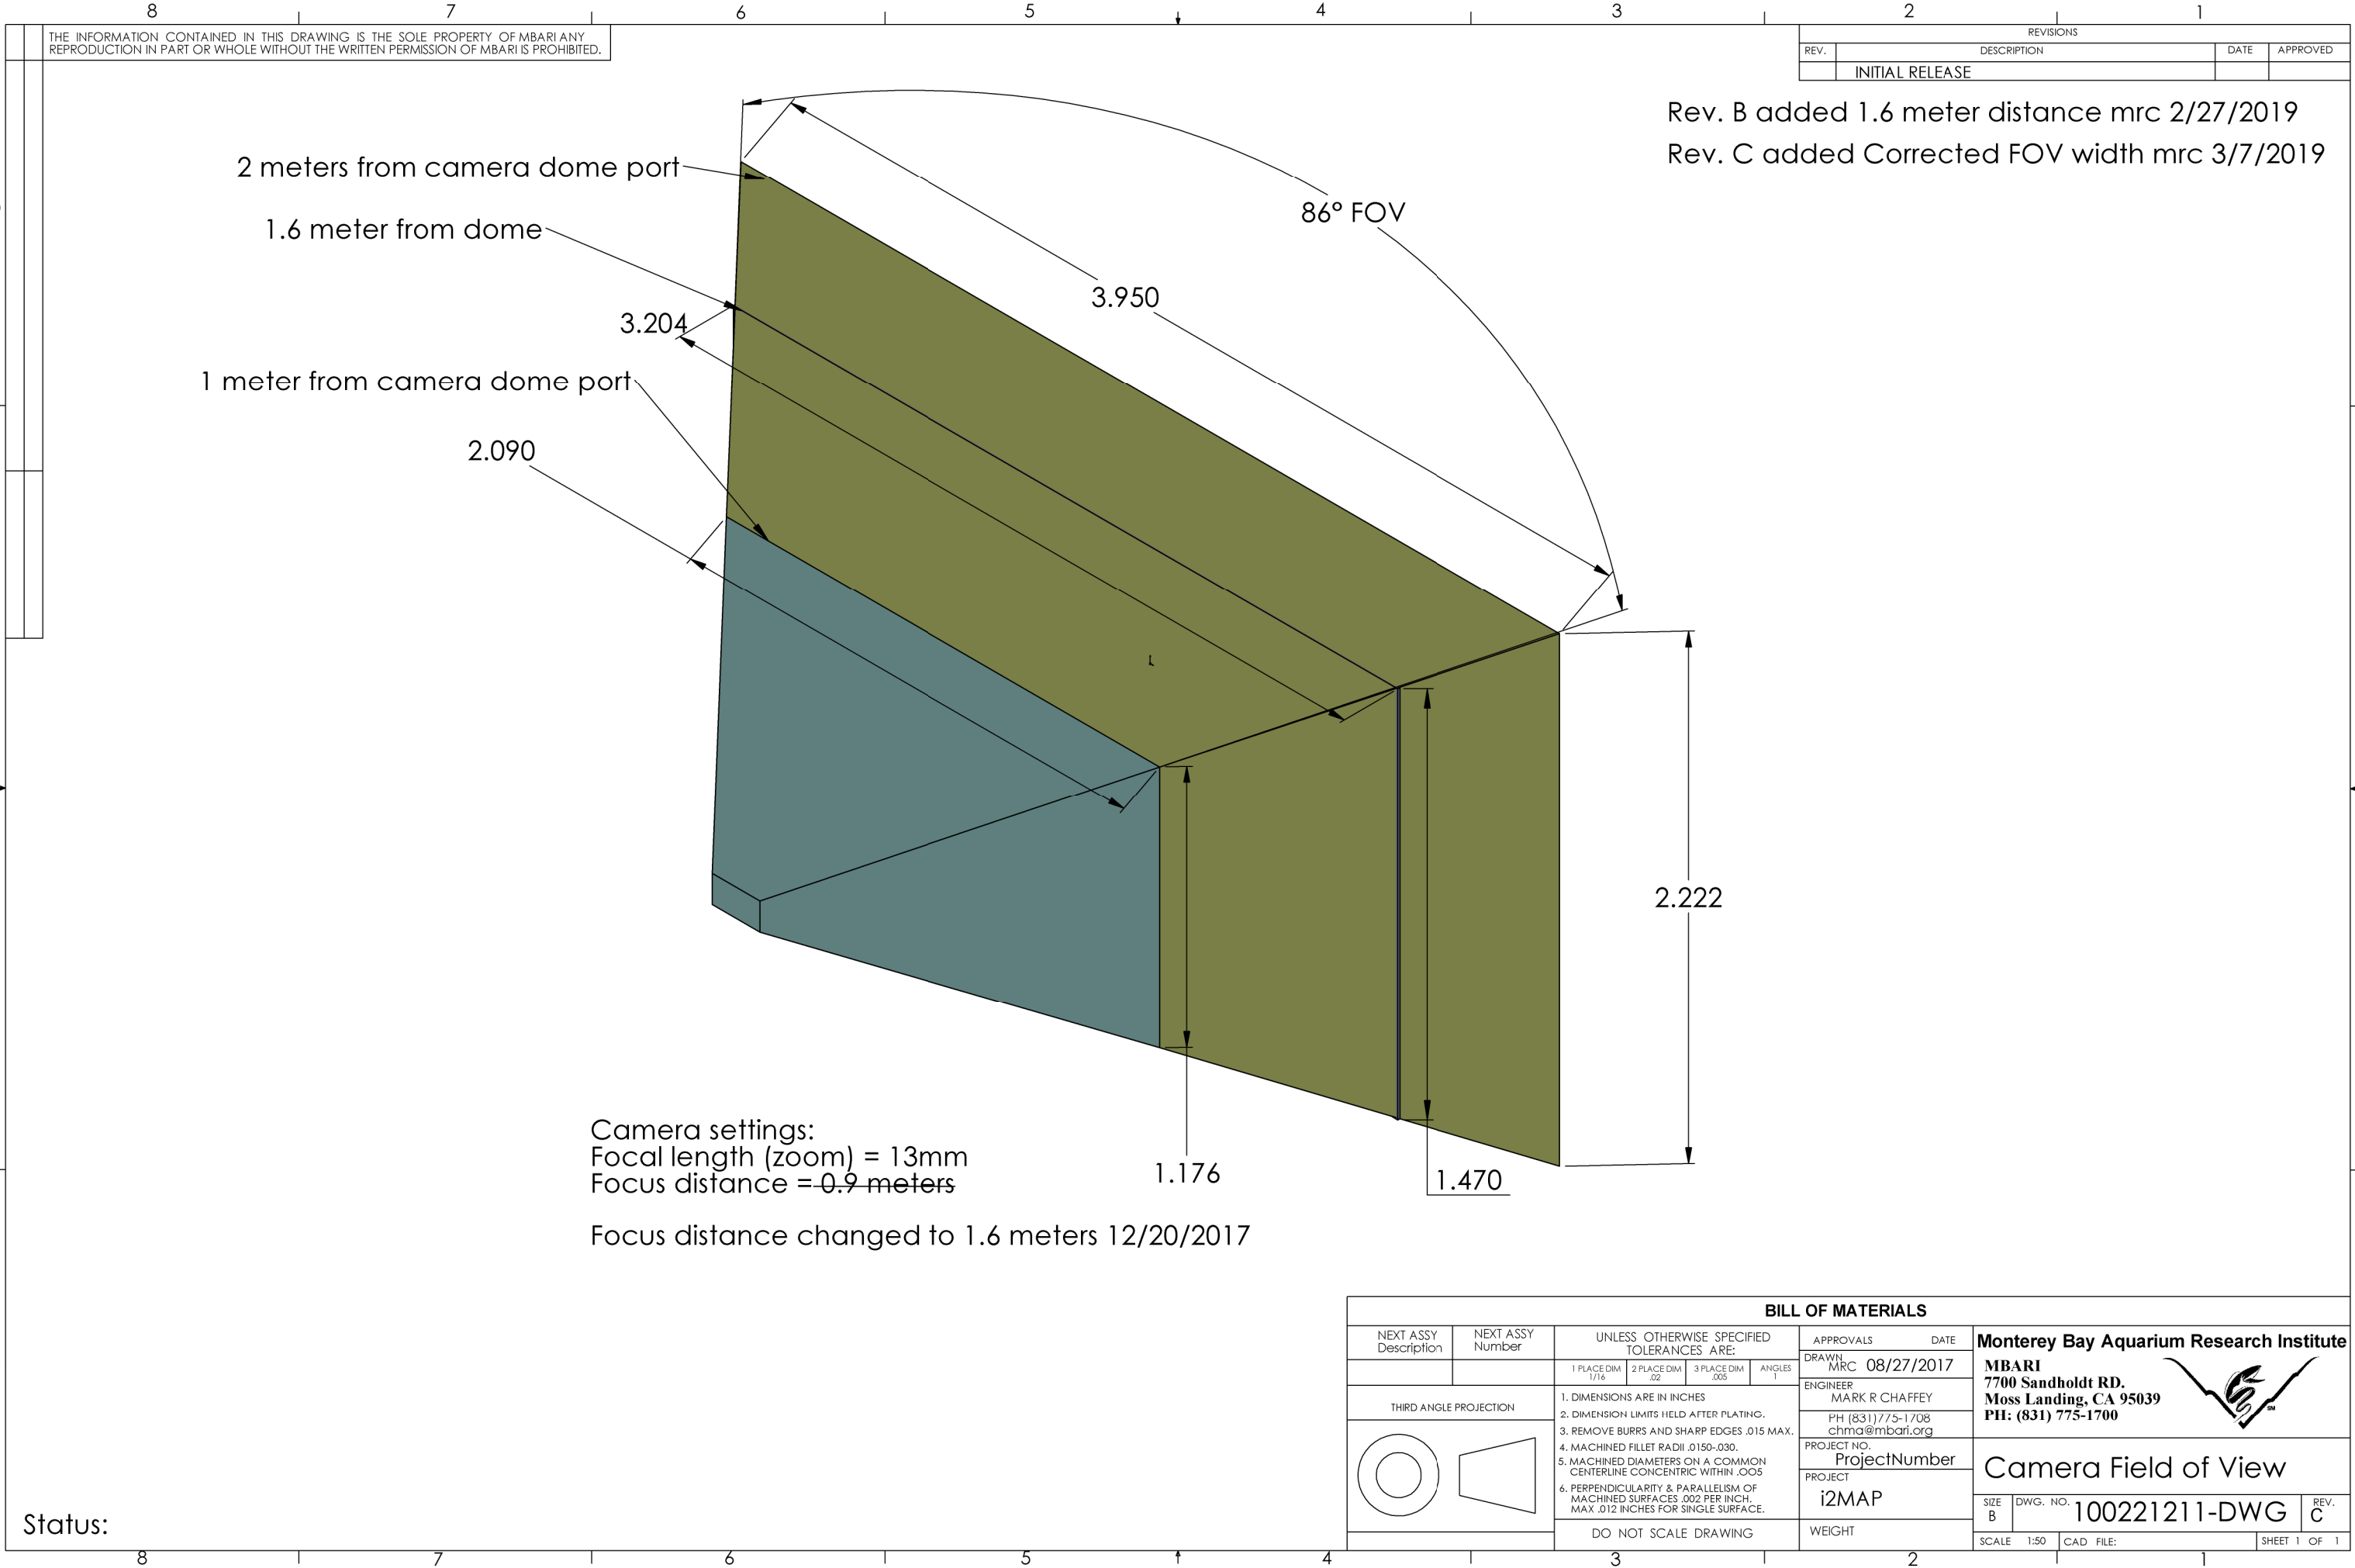

Status:

BILL OF MATERIALS									
NEXT ASSY Description		NEXT ASSY Number		UNLESS OTHERWISE SPECIFIED TOLERANCES ARE:			APPROVALS		DATE
				1 PLACE DIM 1/16	2 PLACE DIM .02	3 PLACE DIM .005	ANGLES 1	DRAWN	08/27/2017
								ENGINEER	
								PH (831) 775-1708	
								chma@mbari.org	
								PROJECT NO.	
								ProjectNumber	
								PROJECT	
								i2MAP	
								WEIGHT	
								SCALE	1:50
								CAD FILE:	
								SHEET	1 OF 1

THIRD ANGLE PROJECTION

1. DIMENSIONS ARE IN INCHES

2. DIMENSION LIMITS HELD AFTER PLATING.

3. REMOVE BURRS AND SHARP EDGES .015 MAX.

4. MACHINED FILLET RADII .0150-.030.

5. MACHINED DIAMETERS ON A COMMON CENTERLINE CONCENTRIC WITHIN .005

6. PERPENDICULARITY & PARALLELISM OF MACHINED SURFACES .002 PER INCH. MAX .012 INCHES FOR SINGLE SURFACE.

DO NOT SCALE DRAWING

Monterey Bay Aquarium Research Institute

MBARI

7700 Sandholdt RD.

Moss Landing, CA 95039

PH: (831) 775-1700

Camera Field of View

SIZE B	DWG. NO. 100221211-DWG	REV. C
--------	------------------------	--------