


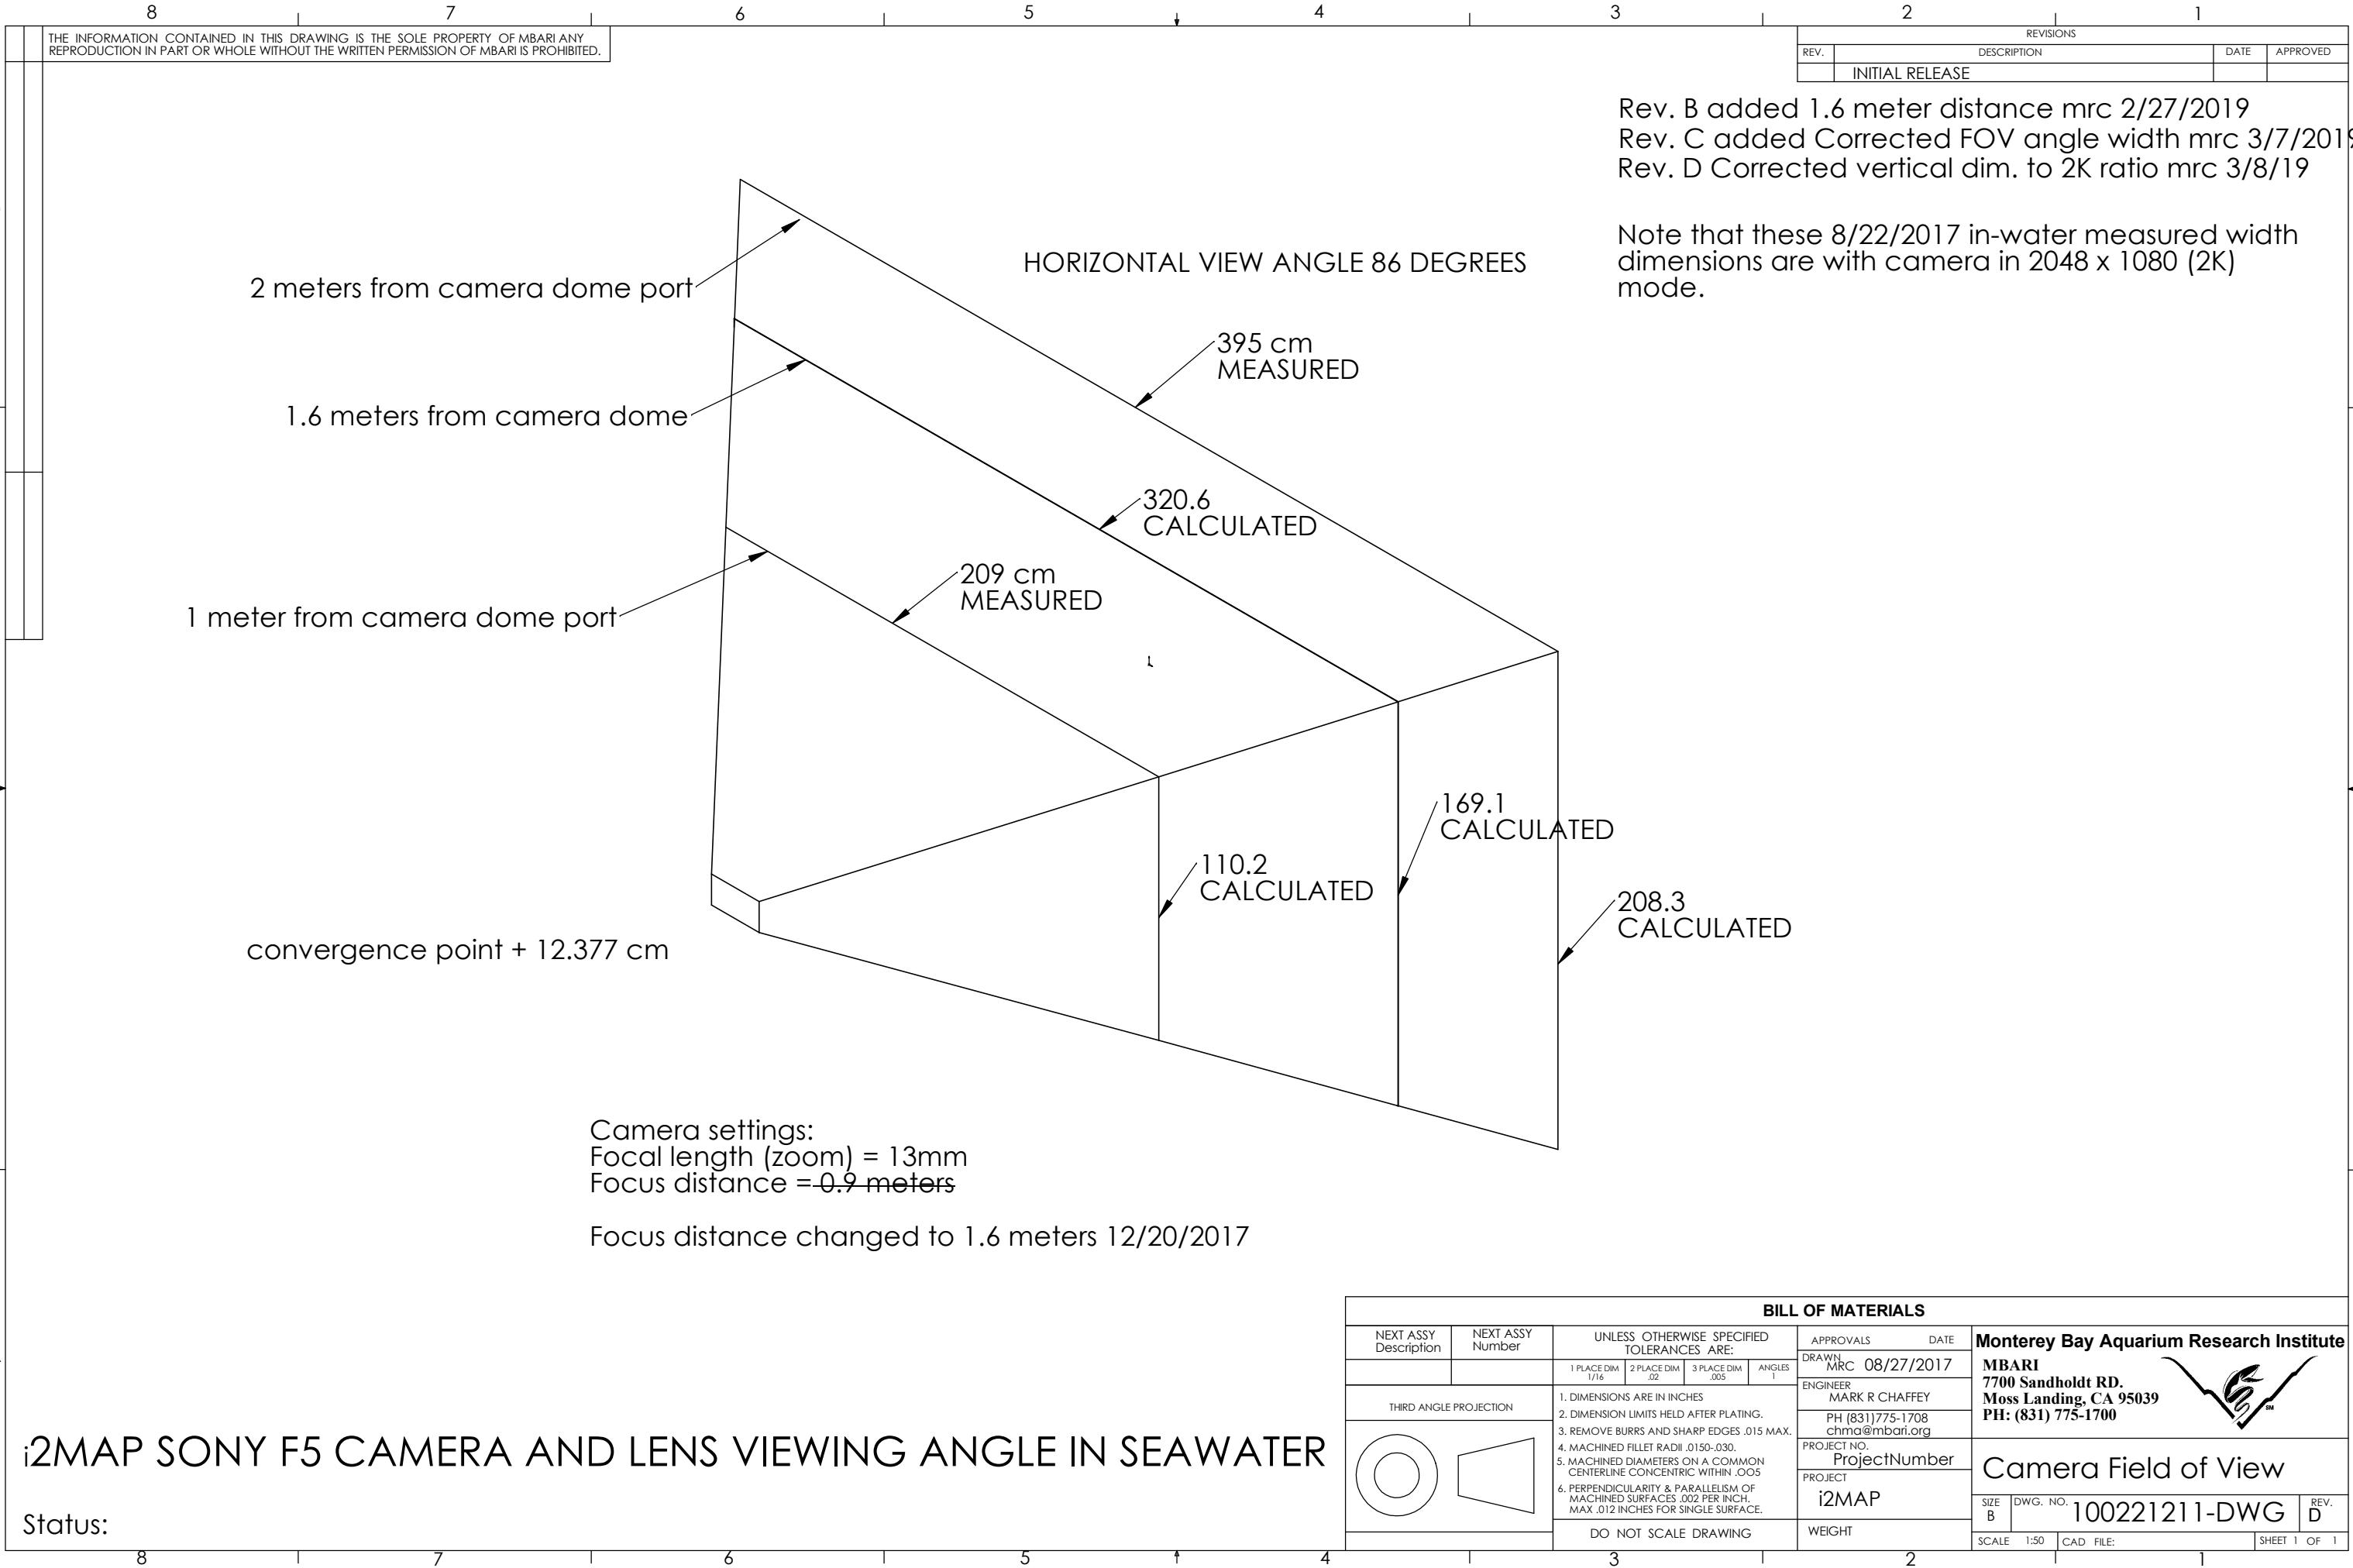

THE INFORMATION CONTAINED IN THIS DRAWING IS THE SOLE PROPERTY OF MBARI ANY REPRODUCTION IN PART OR WHOLE WITHOUT THE WRITTEN PERMISSION OF MBARI IS PROHIBITED.

REVISIONS			
REV.	DESCRIPTION	DATE	APPROVED
	INITIAL RELEASE		

Rev. B added 1.6 meter distance mrc 2/27/2019
Rev. C added Corrected FOV angle width mrc 3/7/2019
Rev. D Corrected vertical dim. to 2K ratio mrc 3/8/19

Note that these 8/22/2017 in-water measured width dimensions are with camera in 2048 x 1080 (2K) mode.

Camera settings:
Focal length (zoom) = 13mm
Focus distance = ~~0.9 meters~~
Focus distance changed to 1.6 meters 12/20/2017

i2MAP SONY F5 CAMERA AND LENS VIEWING ANGLE IN SEAWATER

Status:

BILL OF MATERIALS									
NEXT ASSY Description		NEXT ASSY Number		UNLESS OTHERWISE SPECIFIED TOLERANCES ARE:			APPROVALS		DATE
				1 PLACE DIM 1/16	2 PLACE DIM .02	3 PLACE DIM .005	ANGLES 1	DRAWN MRC 08/27/2017	
							ENGINEER MARK R CHAFFEY		
							PH (831)775-1708 chma@mbari.org		
							PROJECT NO. ProjectNumber		
							PROJECT i2MAP		
							WEIGHT		
							SCALE 1:50		
							CAD FILE:		
							SHEET 1 OF 1		

Monterey Bay Aquarium Research Institute		
MBARI		
7700 Sandholdt RD.		
Moss Landing, CA 95039		
PH: (831) 775-1700		
		

Camera Field of View			
SIZE B	DWG. NO.	100221211-DWG	REV. D





