



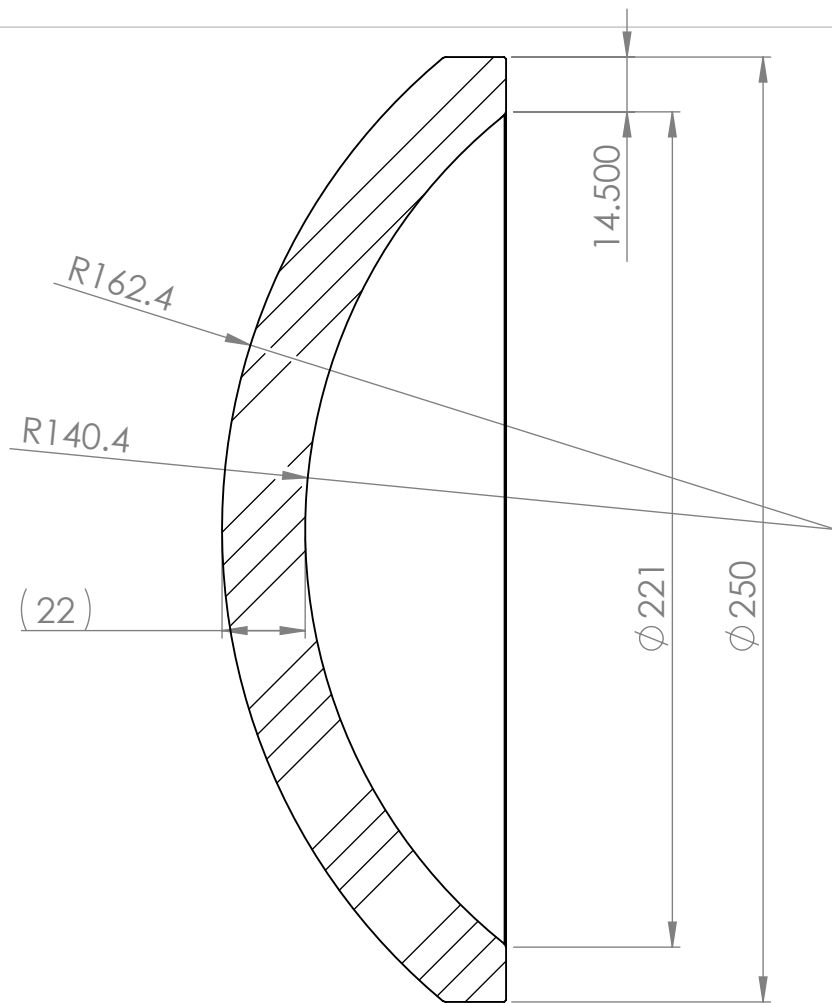

Current design

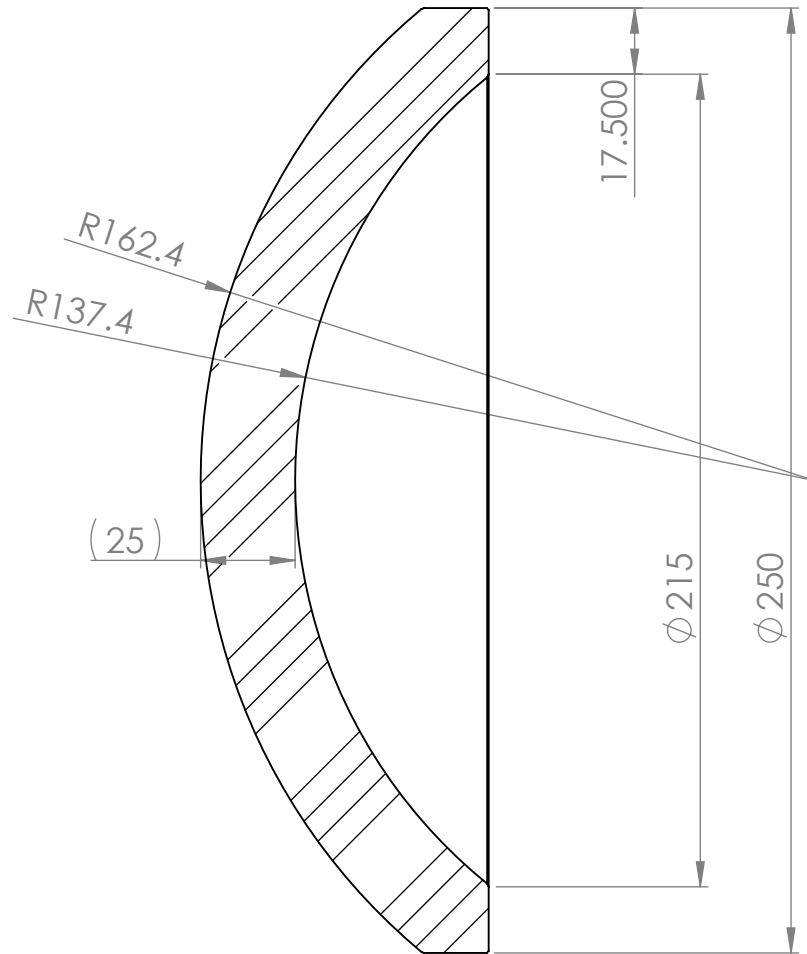

Increased thickness

UNLESS OTHERWISE SPECIFIED TOLERANCES ARE:				APPROVALS		DATE		Monterey Bay Aquarium Research Institute			
1 PLACE DIM ±1/16	2 PLACE DIM ±.02	3 PLACE DIM ±.005	ANGLES ±1°	DRAWN	11/1/2016			MBARI 7700 Sandholdt RD. Moss Landing, CA 95039 PH: (831) 775-1700 			
1. DIMENSIONS ARE IN INCHES 2. DIMENSION LIMITS HELD AFTER PLATING. 3. REMOVE BURRS AND SHARP EDGES .015 MAX. 4. MACHINED FILLET RADII .0150-.030. 5. MACHINED DIAMETERS ON A COMMON CENTERLINE CONCENTRIC WITHIN .005 6. PERPENDICULARITY & PARALLELISM OF MACHINED SURFACES .002 PER INCH, MAX .012 INCHES FOR SINGLE SURFACE.				CHECKED							
				ENGINEER	Francois Cazenave						
				PROJECT NO.	901209.99						
Vendor: Fathom imaging				PROJECT	901209.99			Thicker_I2Map_Do			
Material: H-K9L glass				WEIGHT	3563.372 lb			SIZE A	DWG. NO. I2map-004	REV.	
								SCALE:1:2		SHEET 1 OF 1	