


WIRE LEADS FROM HOUSING PENETRATOR


WIRE LEADS TO LIGHT CONTROL BOARD

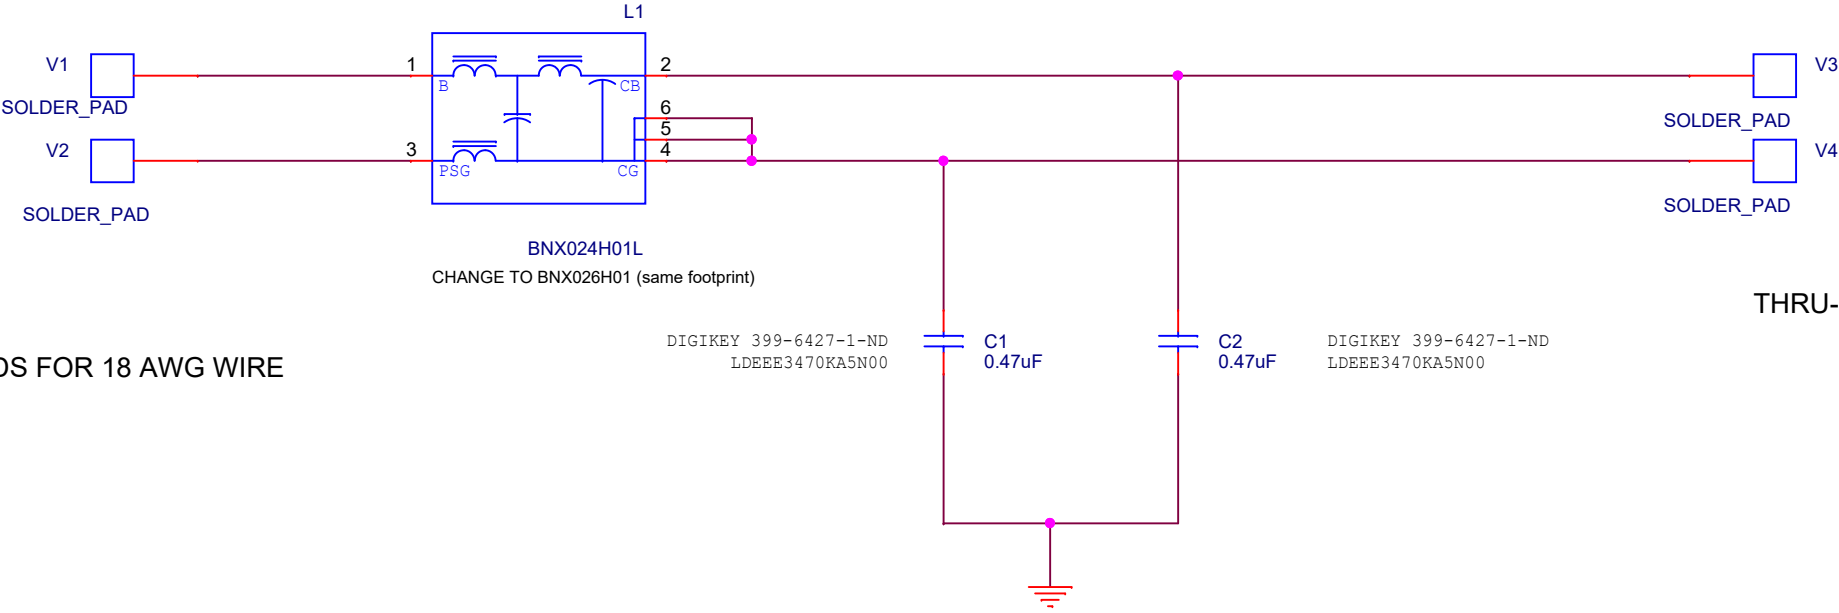

THRU-HOLE SOLDER PADS FOR 18 AWG WIRE

THRU-HOLE SOLDER PADS FOR 18 AWG WIRE

GROUND PLANE AND CONNECTION TO HOUSING
THROUGH MOUNTING SCREW PADS

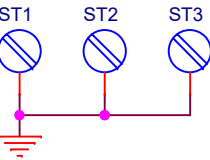

NOTE: SEE 100221314-01-SCH FOR INSTALLATION DRAWING

MONTEREY BAY AQUARIUM RESEARCH INSTITUTE
7700 SANDHOLDT ROAD
MOSS LANDING, CA 95039

PHONE (831) 775-1700 www.mbari.org
COPYRIGHT © 2019 MBARI
MAY NOT BE COPIED WITHOUT PERMISSION



Title DSP&L LSL-2050 LIGHT COMMON MODE NOISE FILTER BOARD				
Size	Engineer: Mark Chaffey EMAIL: chma@mbari.org (831) 775-1708		Number 100221314-01-SCH-A	
	Date: Monday, May 06, 2019		Filename	Rev A
Sheet 1 of 1				