


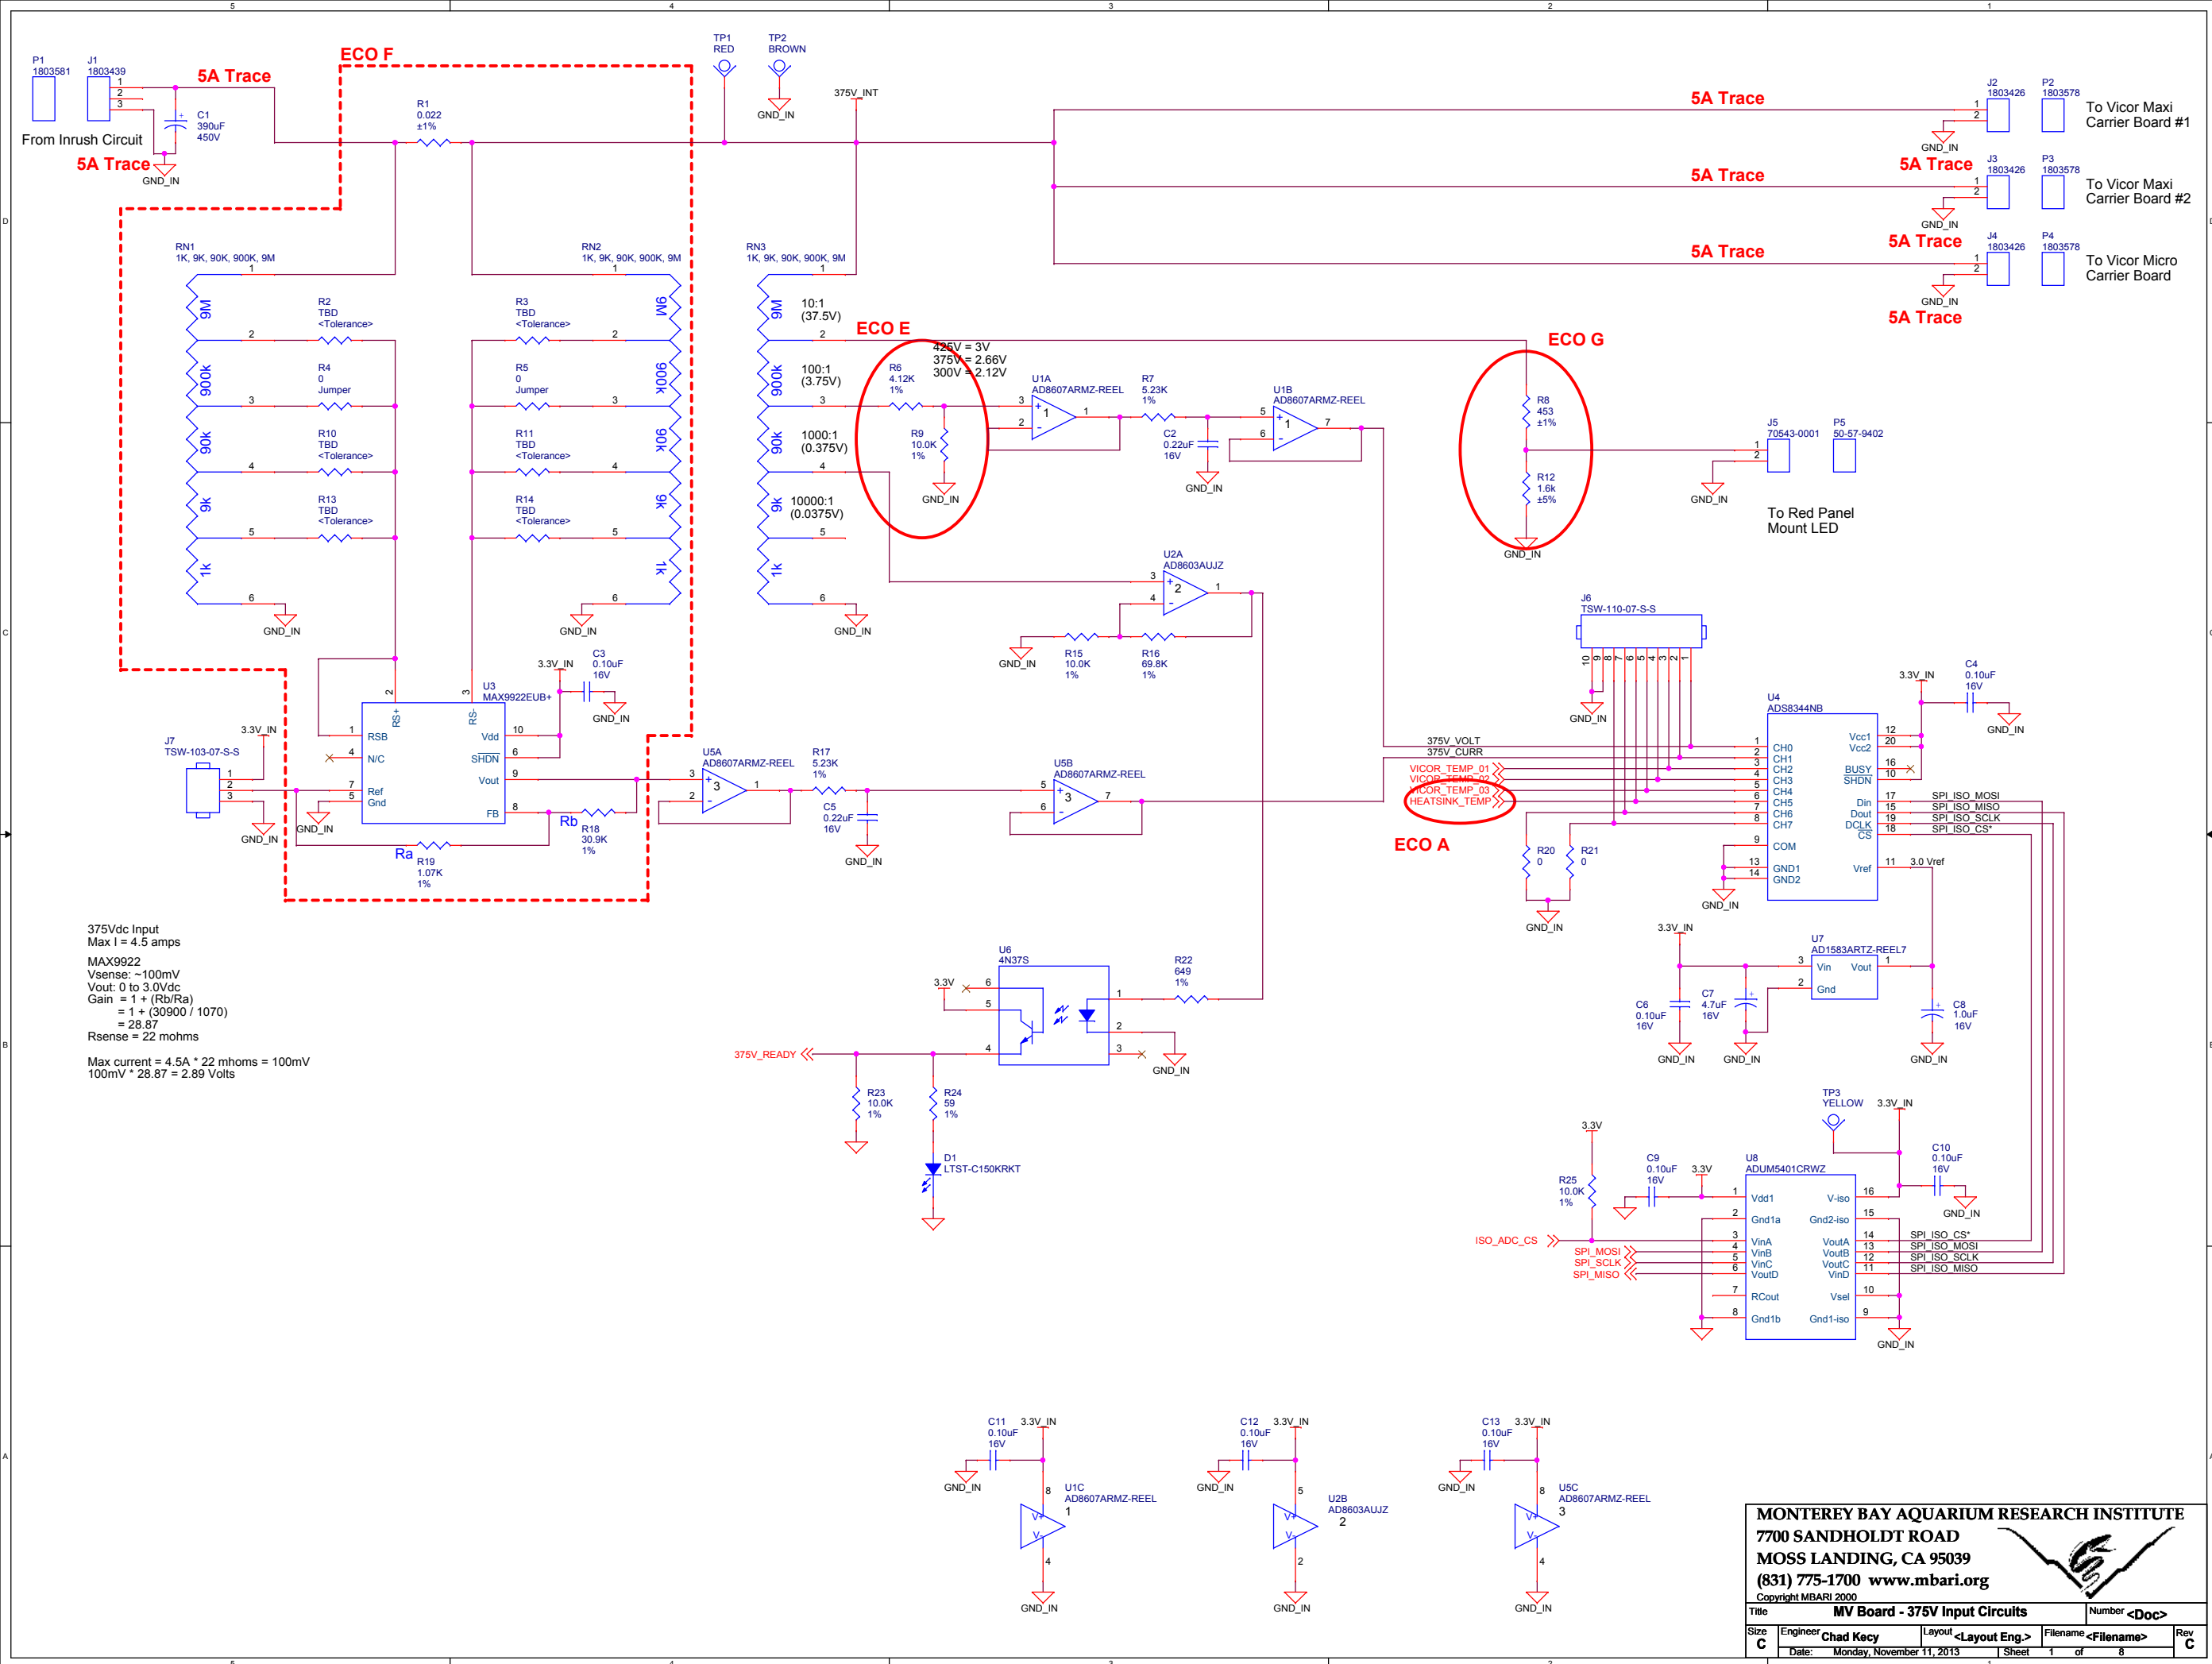
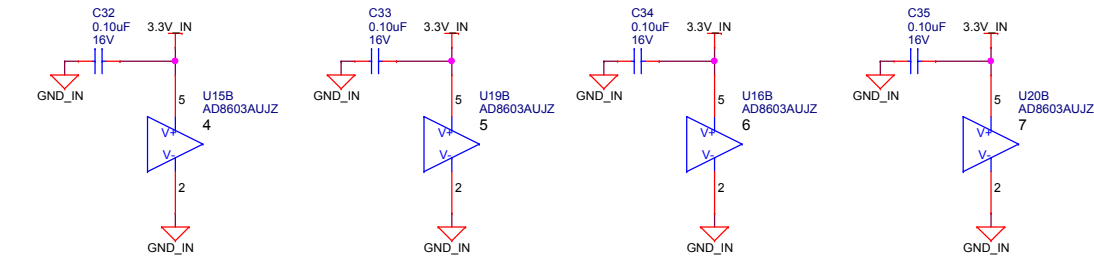
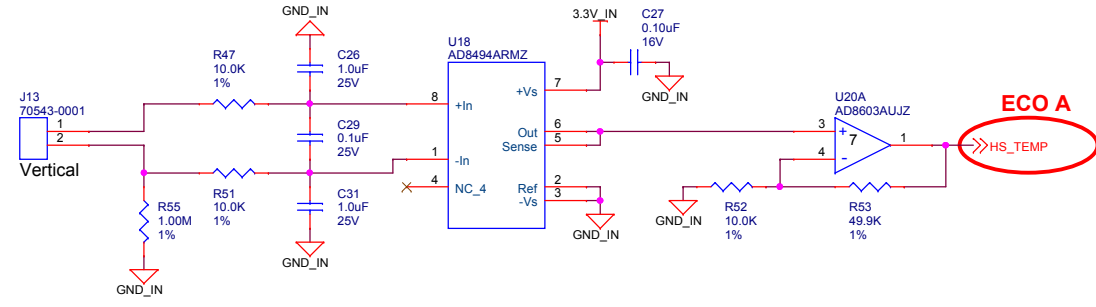
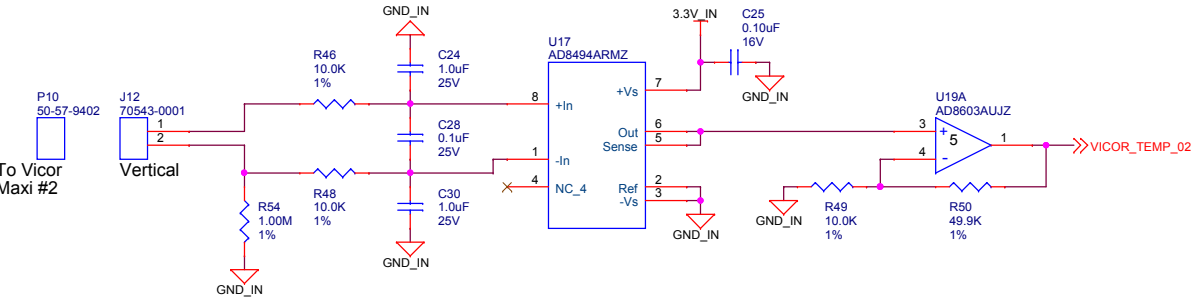
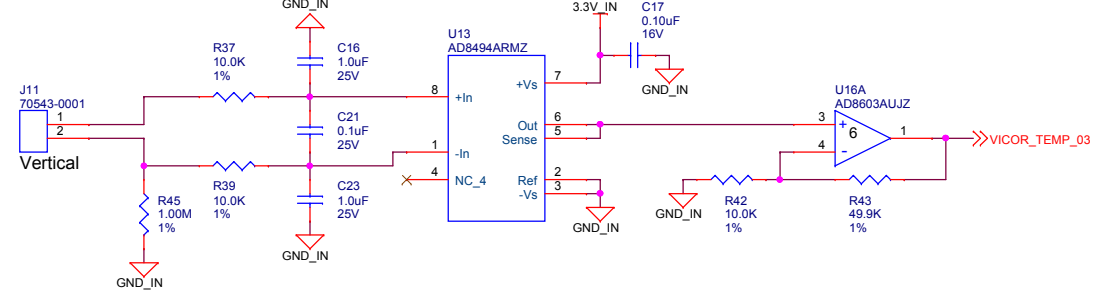
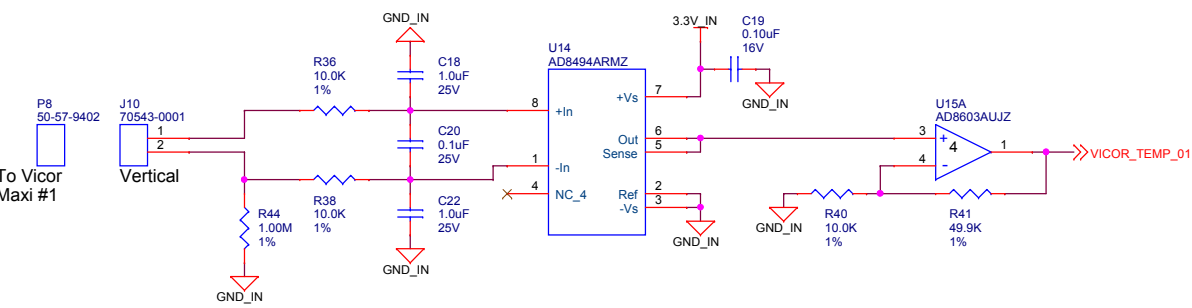


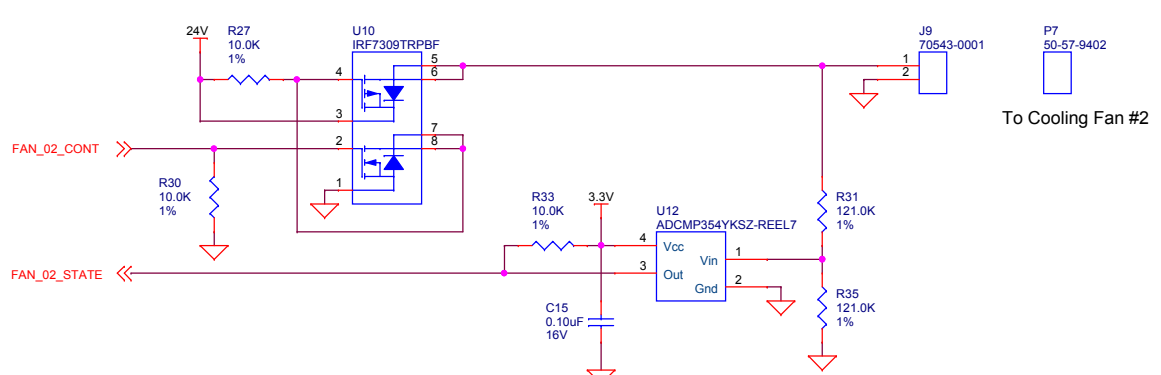


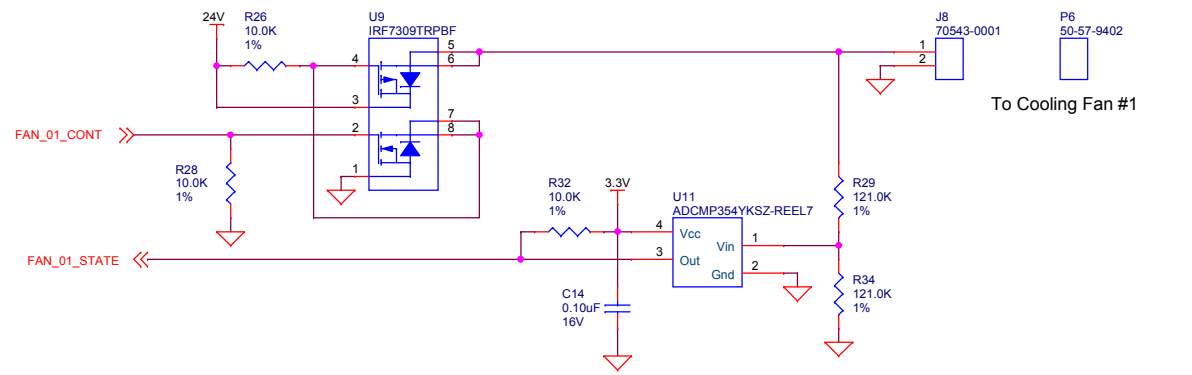

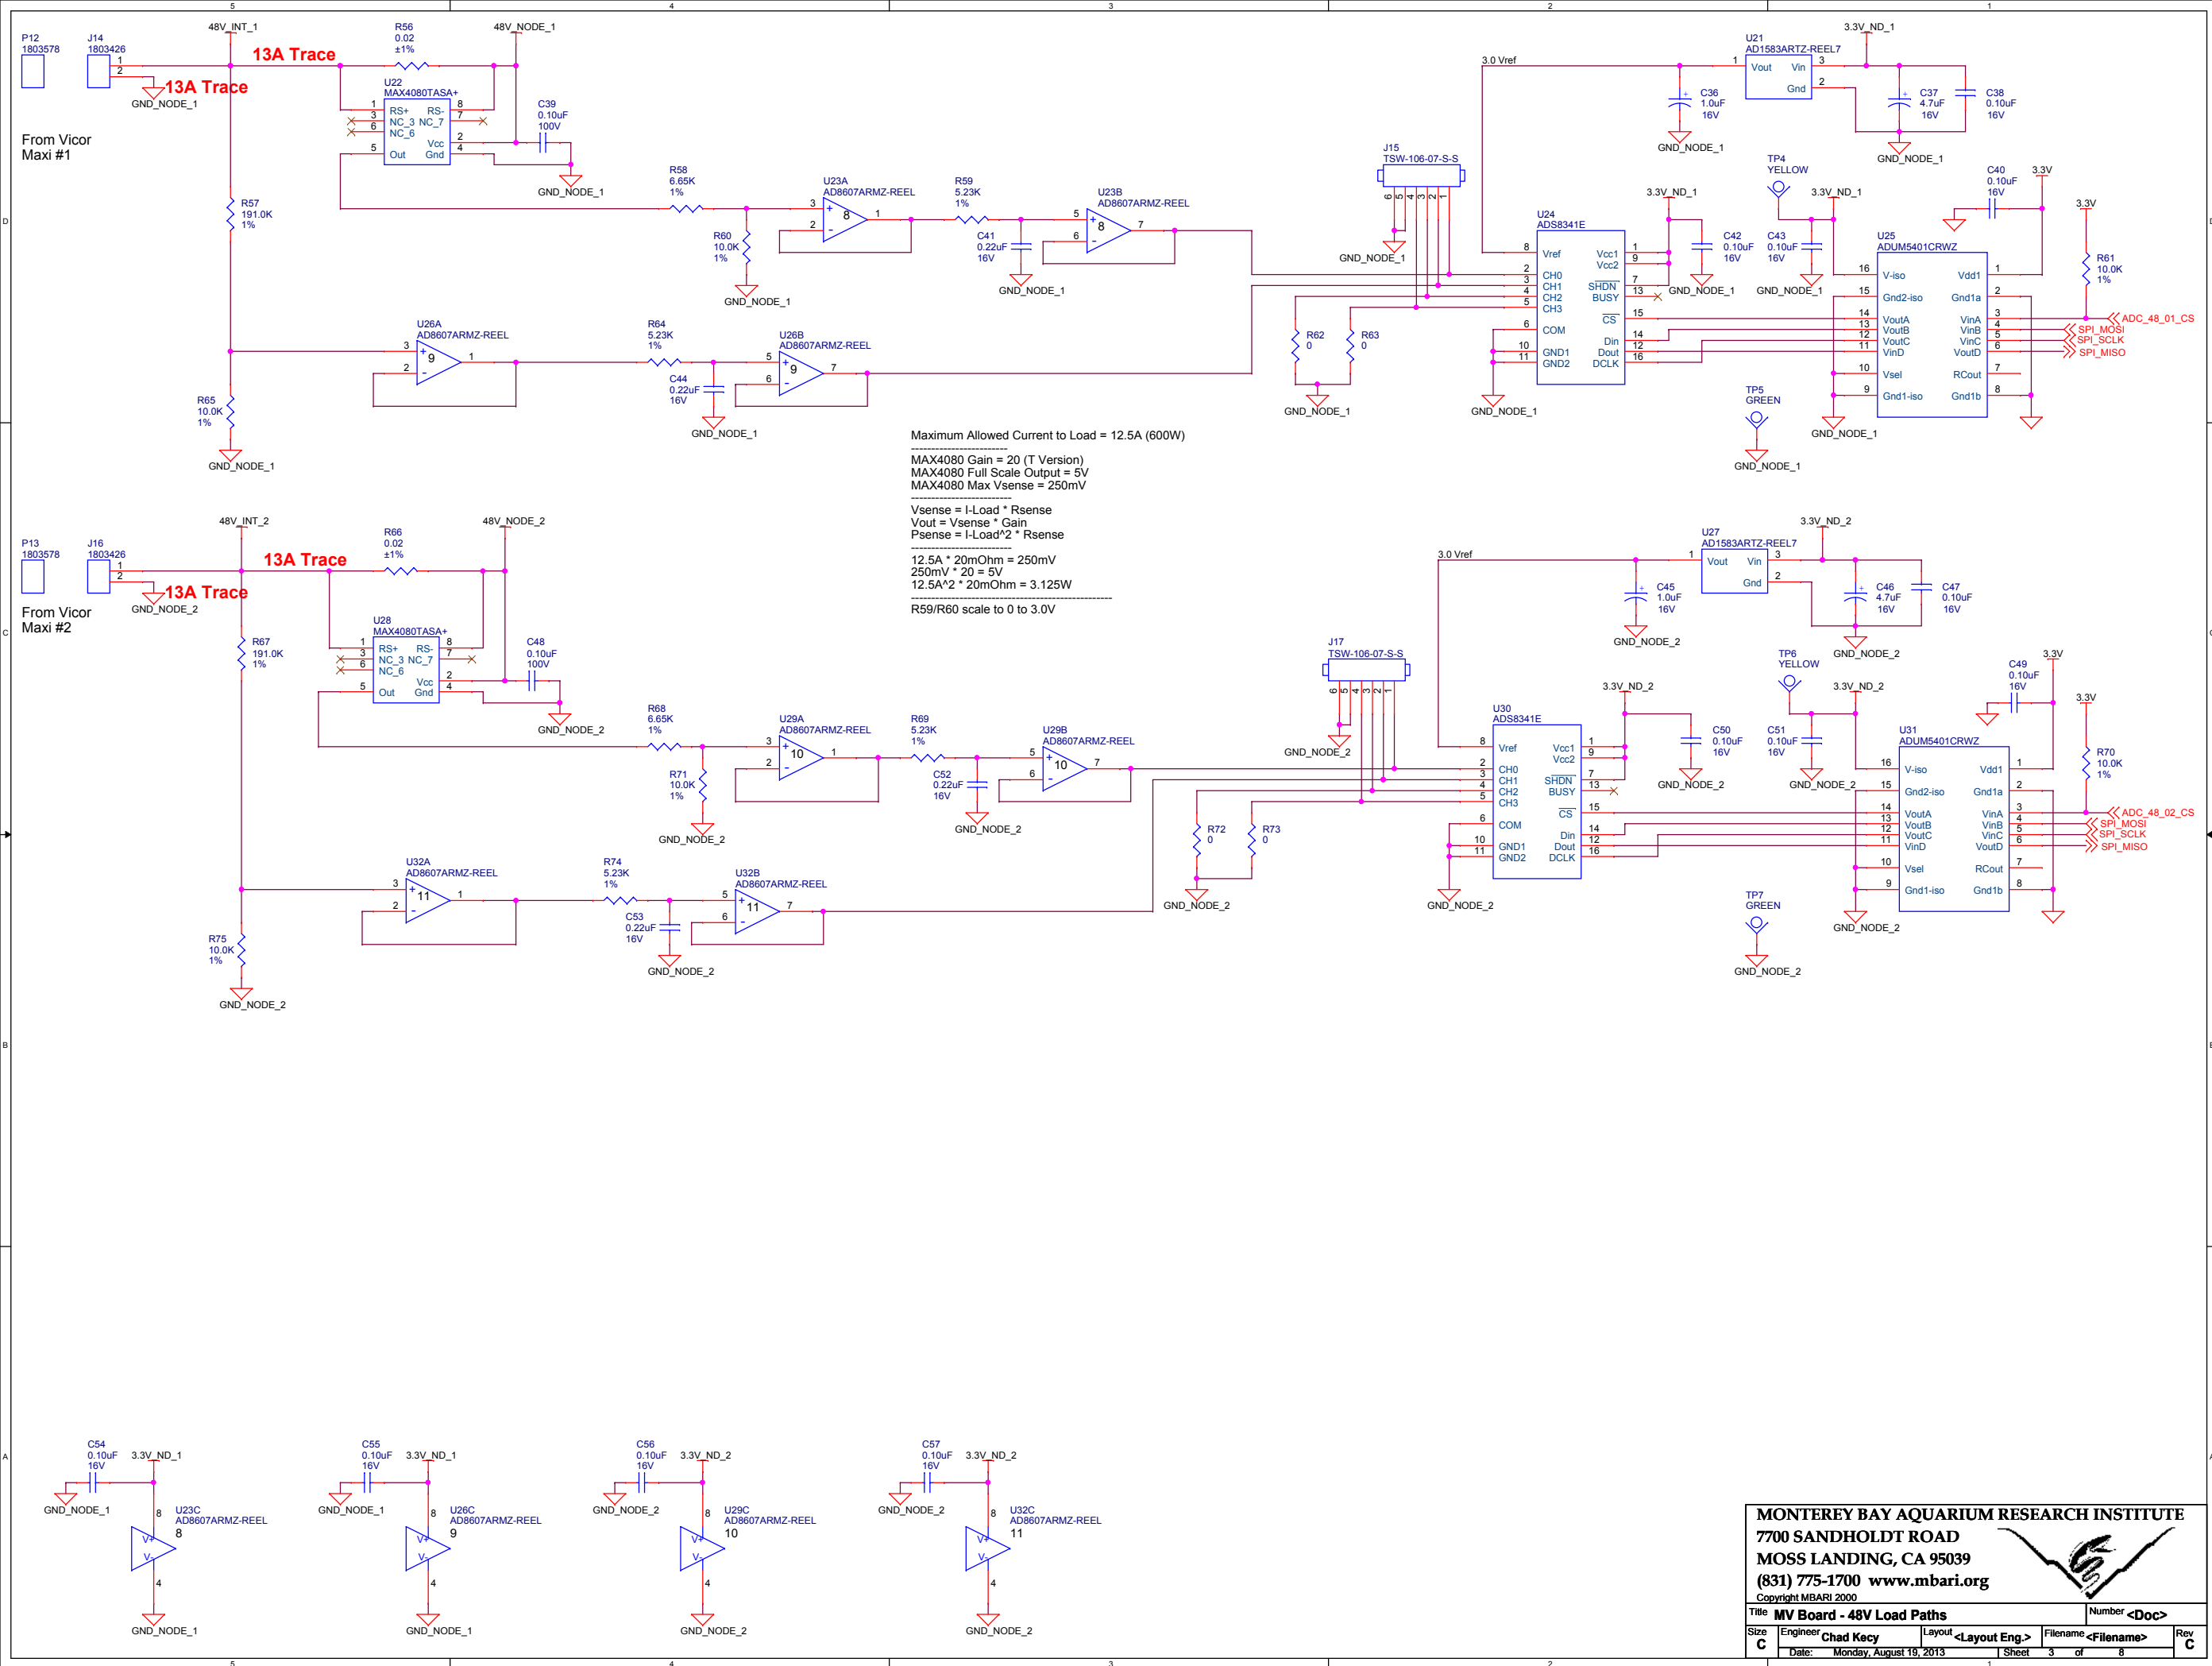


MONTEREY BAY AQUARIUM RESEARCH INSTITUTE
7700 SANDHOLDT ROAD
MOSS LANDING, CA 95039
(831) 775-1700 www.mbari.org
Copyright MBARI 2000


Title MV Board - 48V Load Paths				Number <Doc>
Size Engineer Chad Kacy	Layout <Layout Eng.>	Filename <Filename>	Rev C	
Date: Monday, August 19, 2013	Sheet 3	of 8		

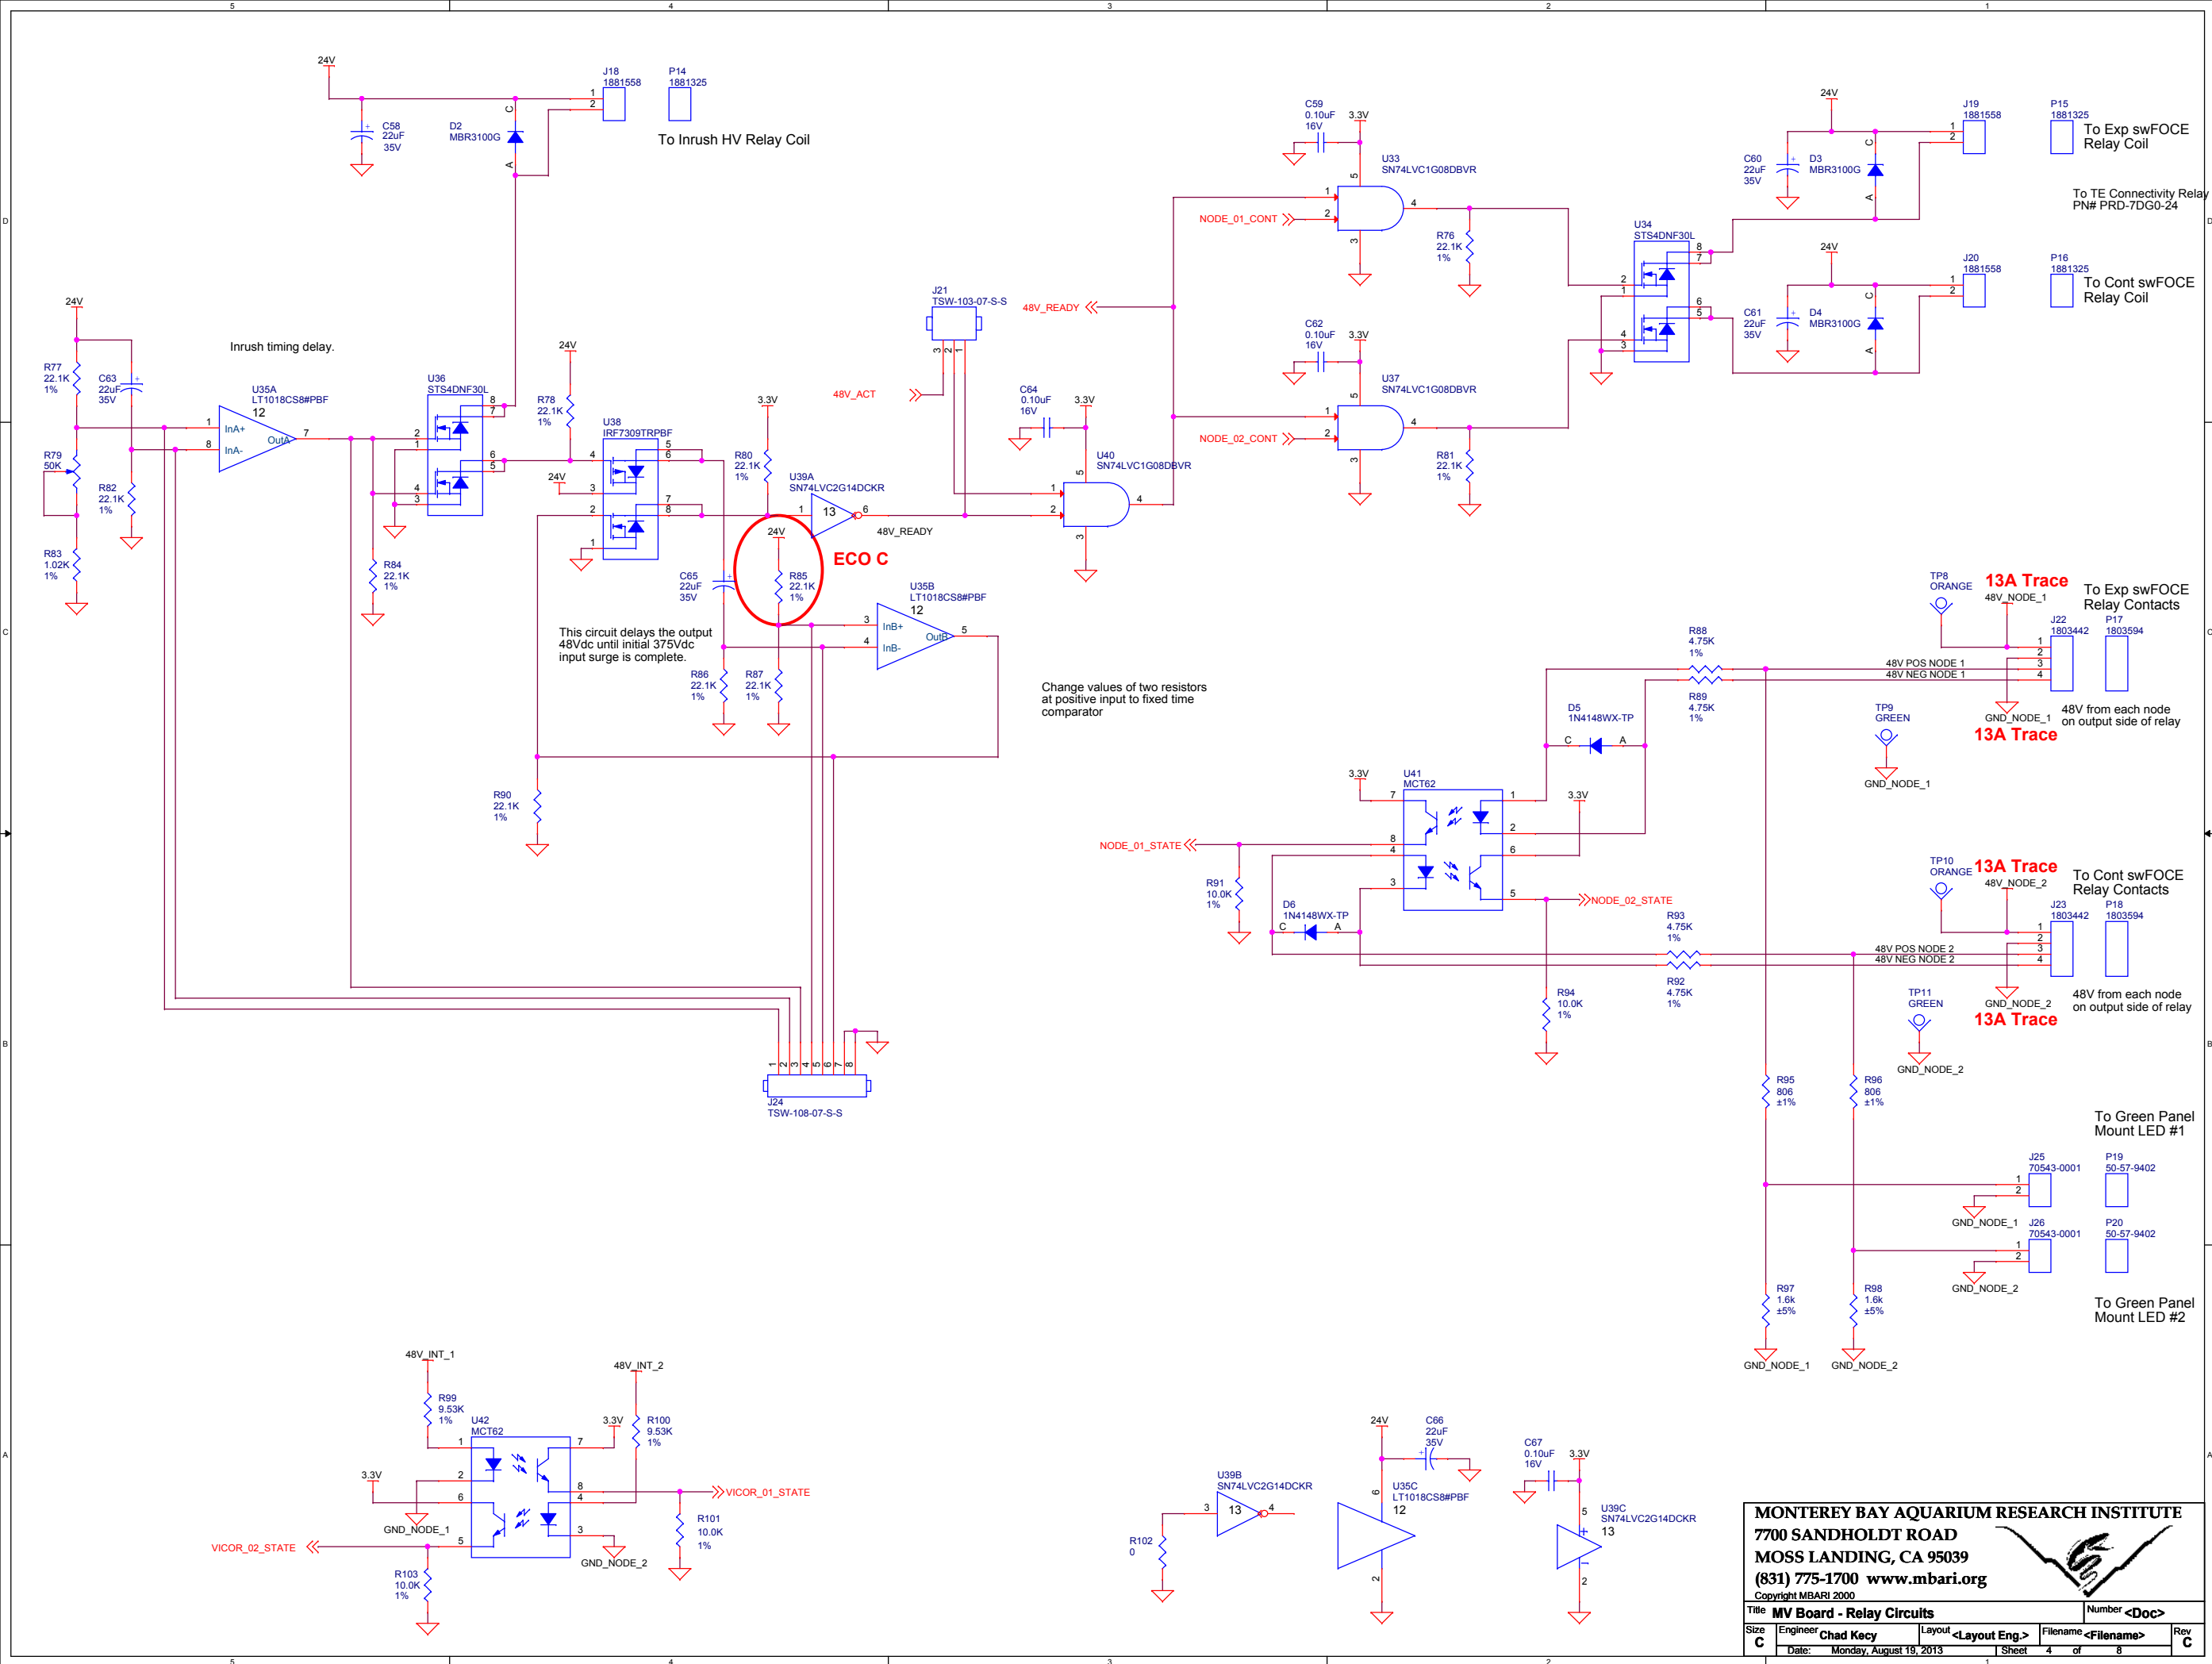


MONTEREY BAY AQUARIUM RESEARCH INSTITUTE
7700 SANDHOLDT ROAD
MOSS LANDING, CA 95039
(831) 775-1700 www.mbari.org
Copyright MBARI 2000

Title MV Board - Relay Circuits			Number <Doc>
Size C	Engineer Chad Kacy	Layout <Layout Eng.>	Filename <Filename>
Date: Monday, August 19, 2013		Sheet 4 of 8	Rev C

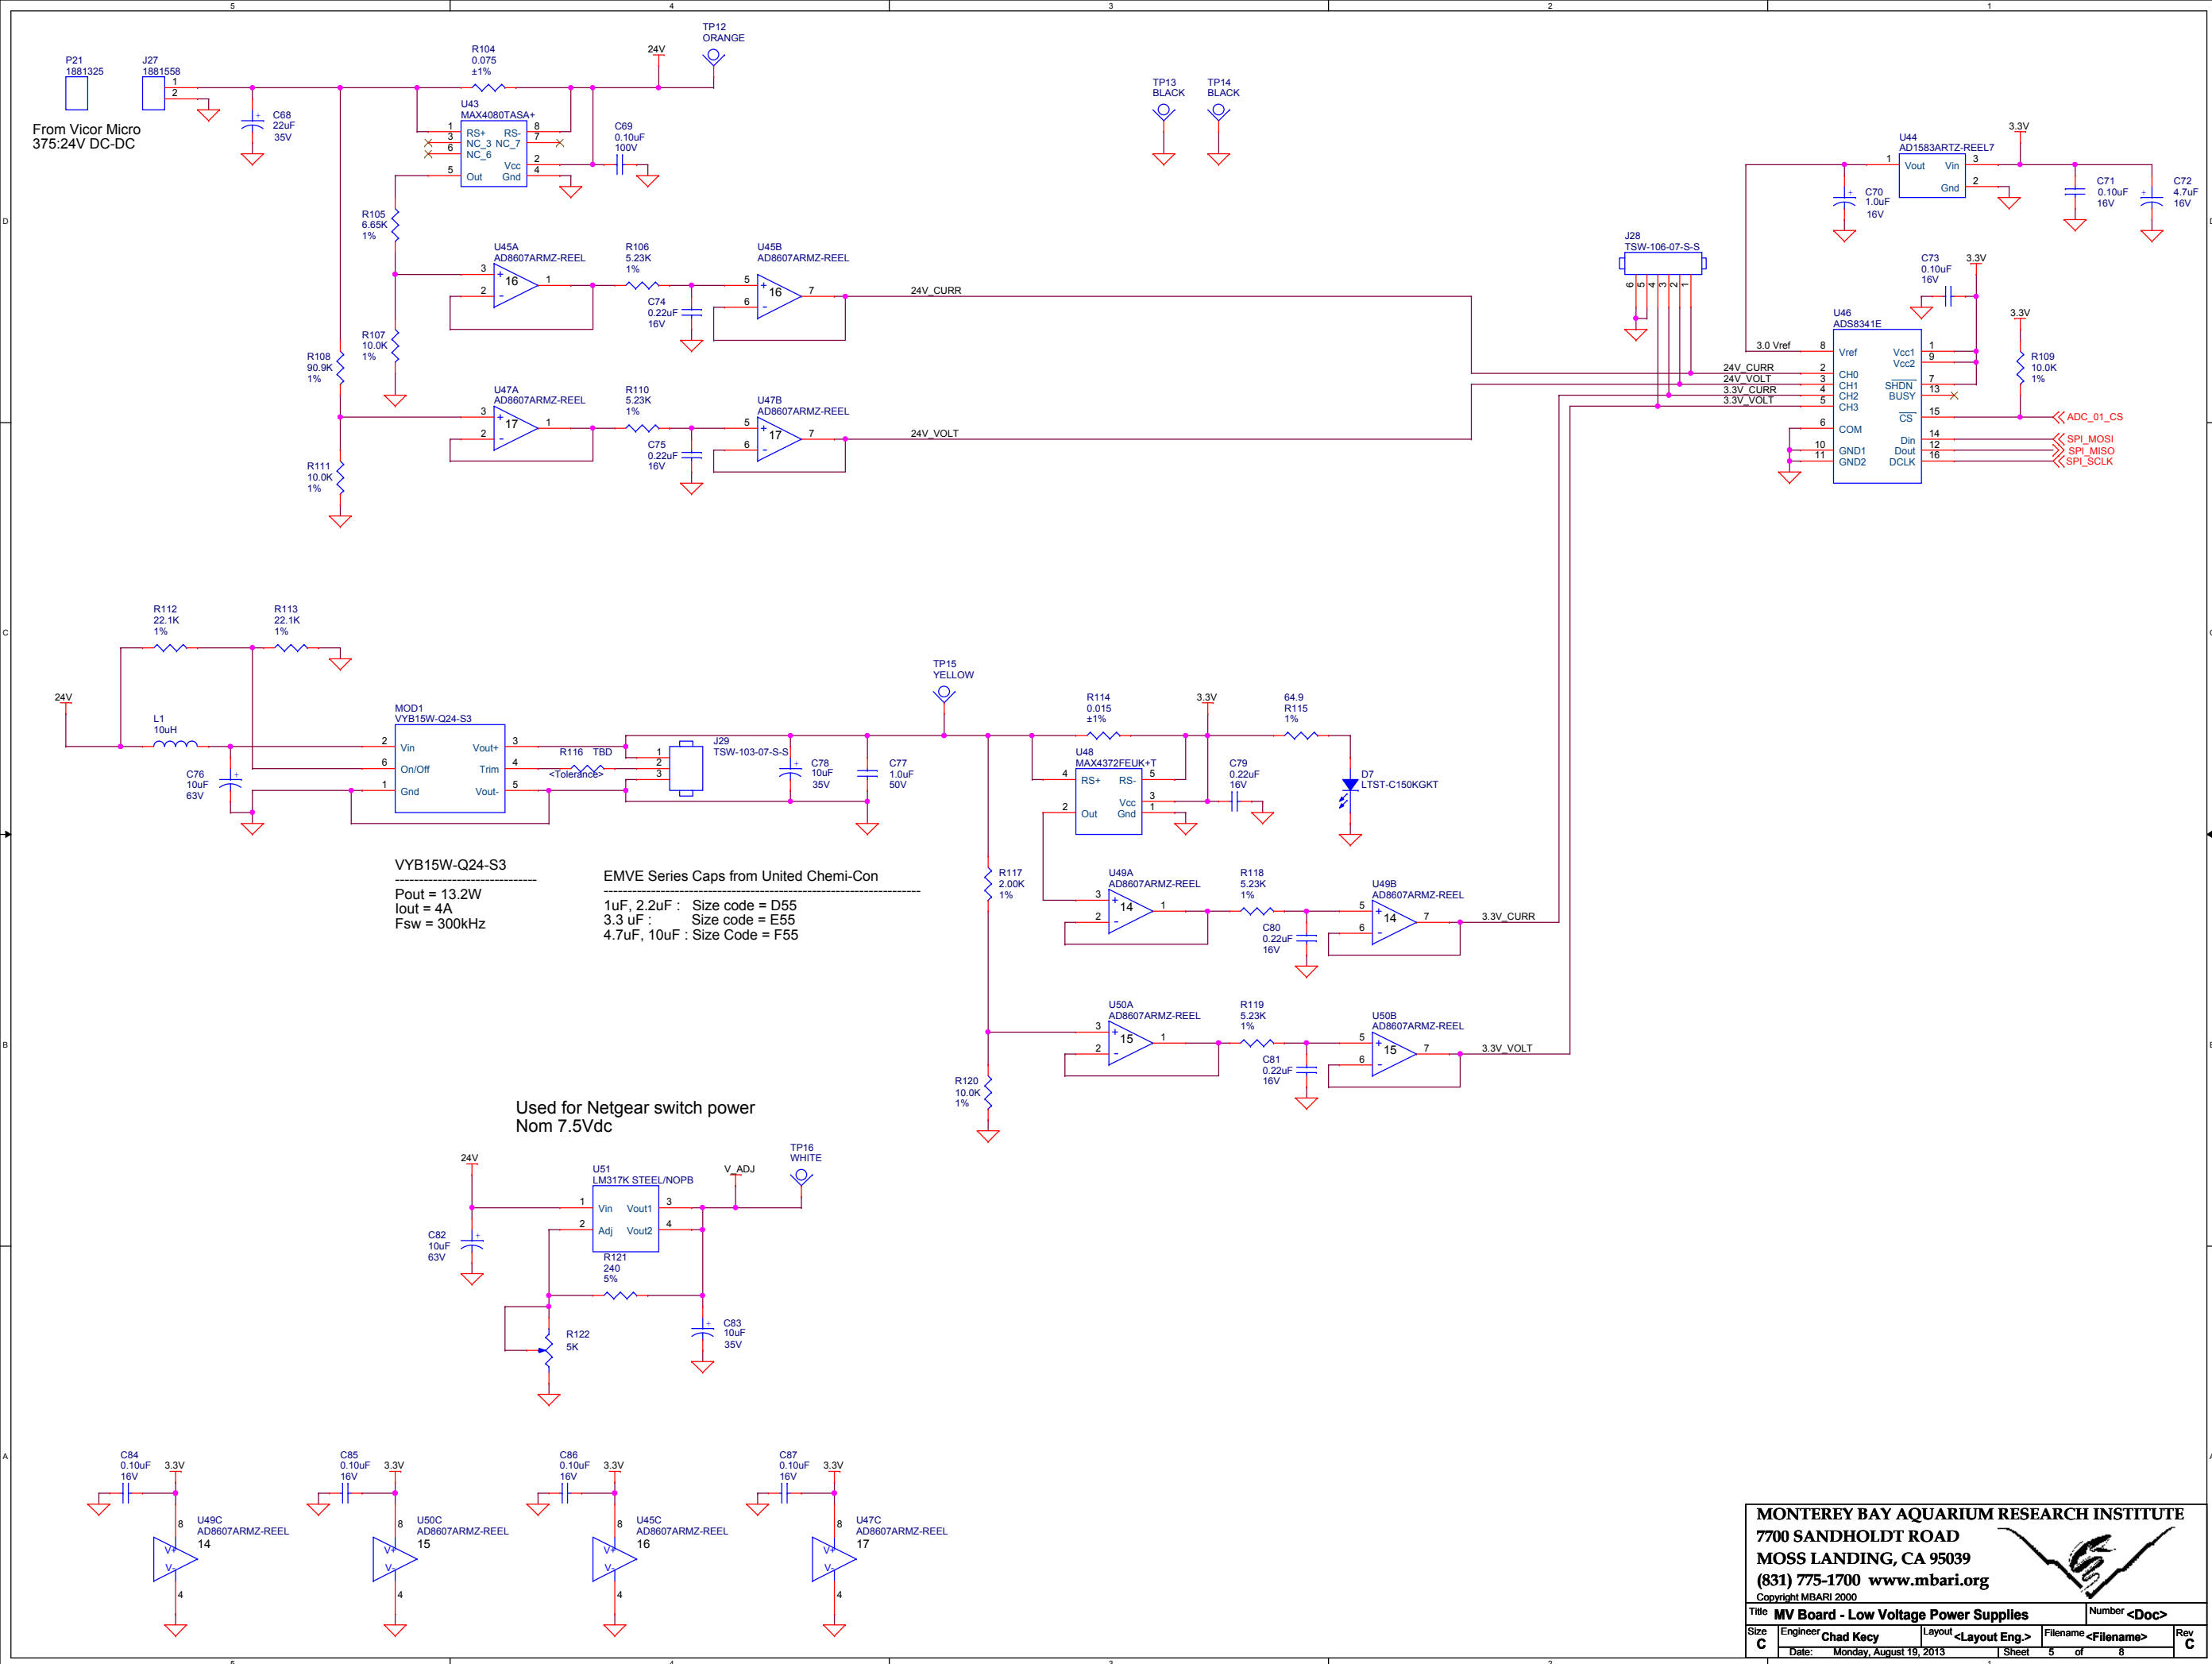


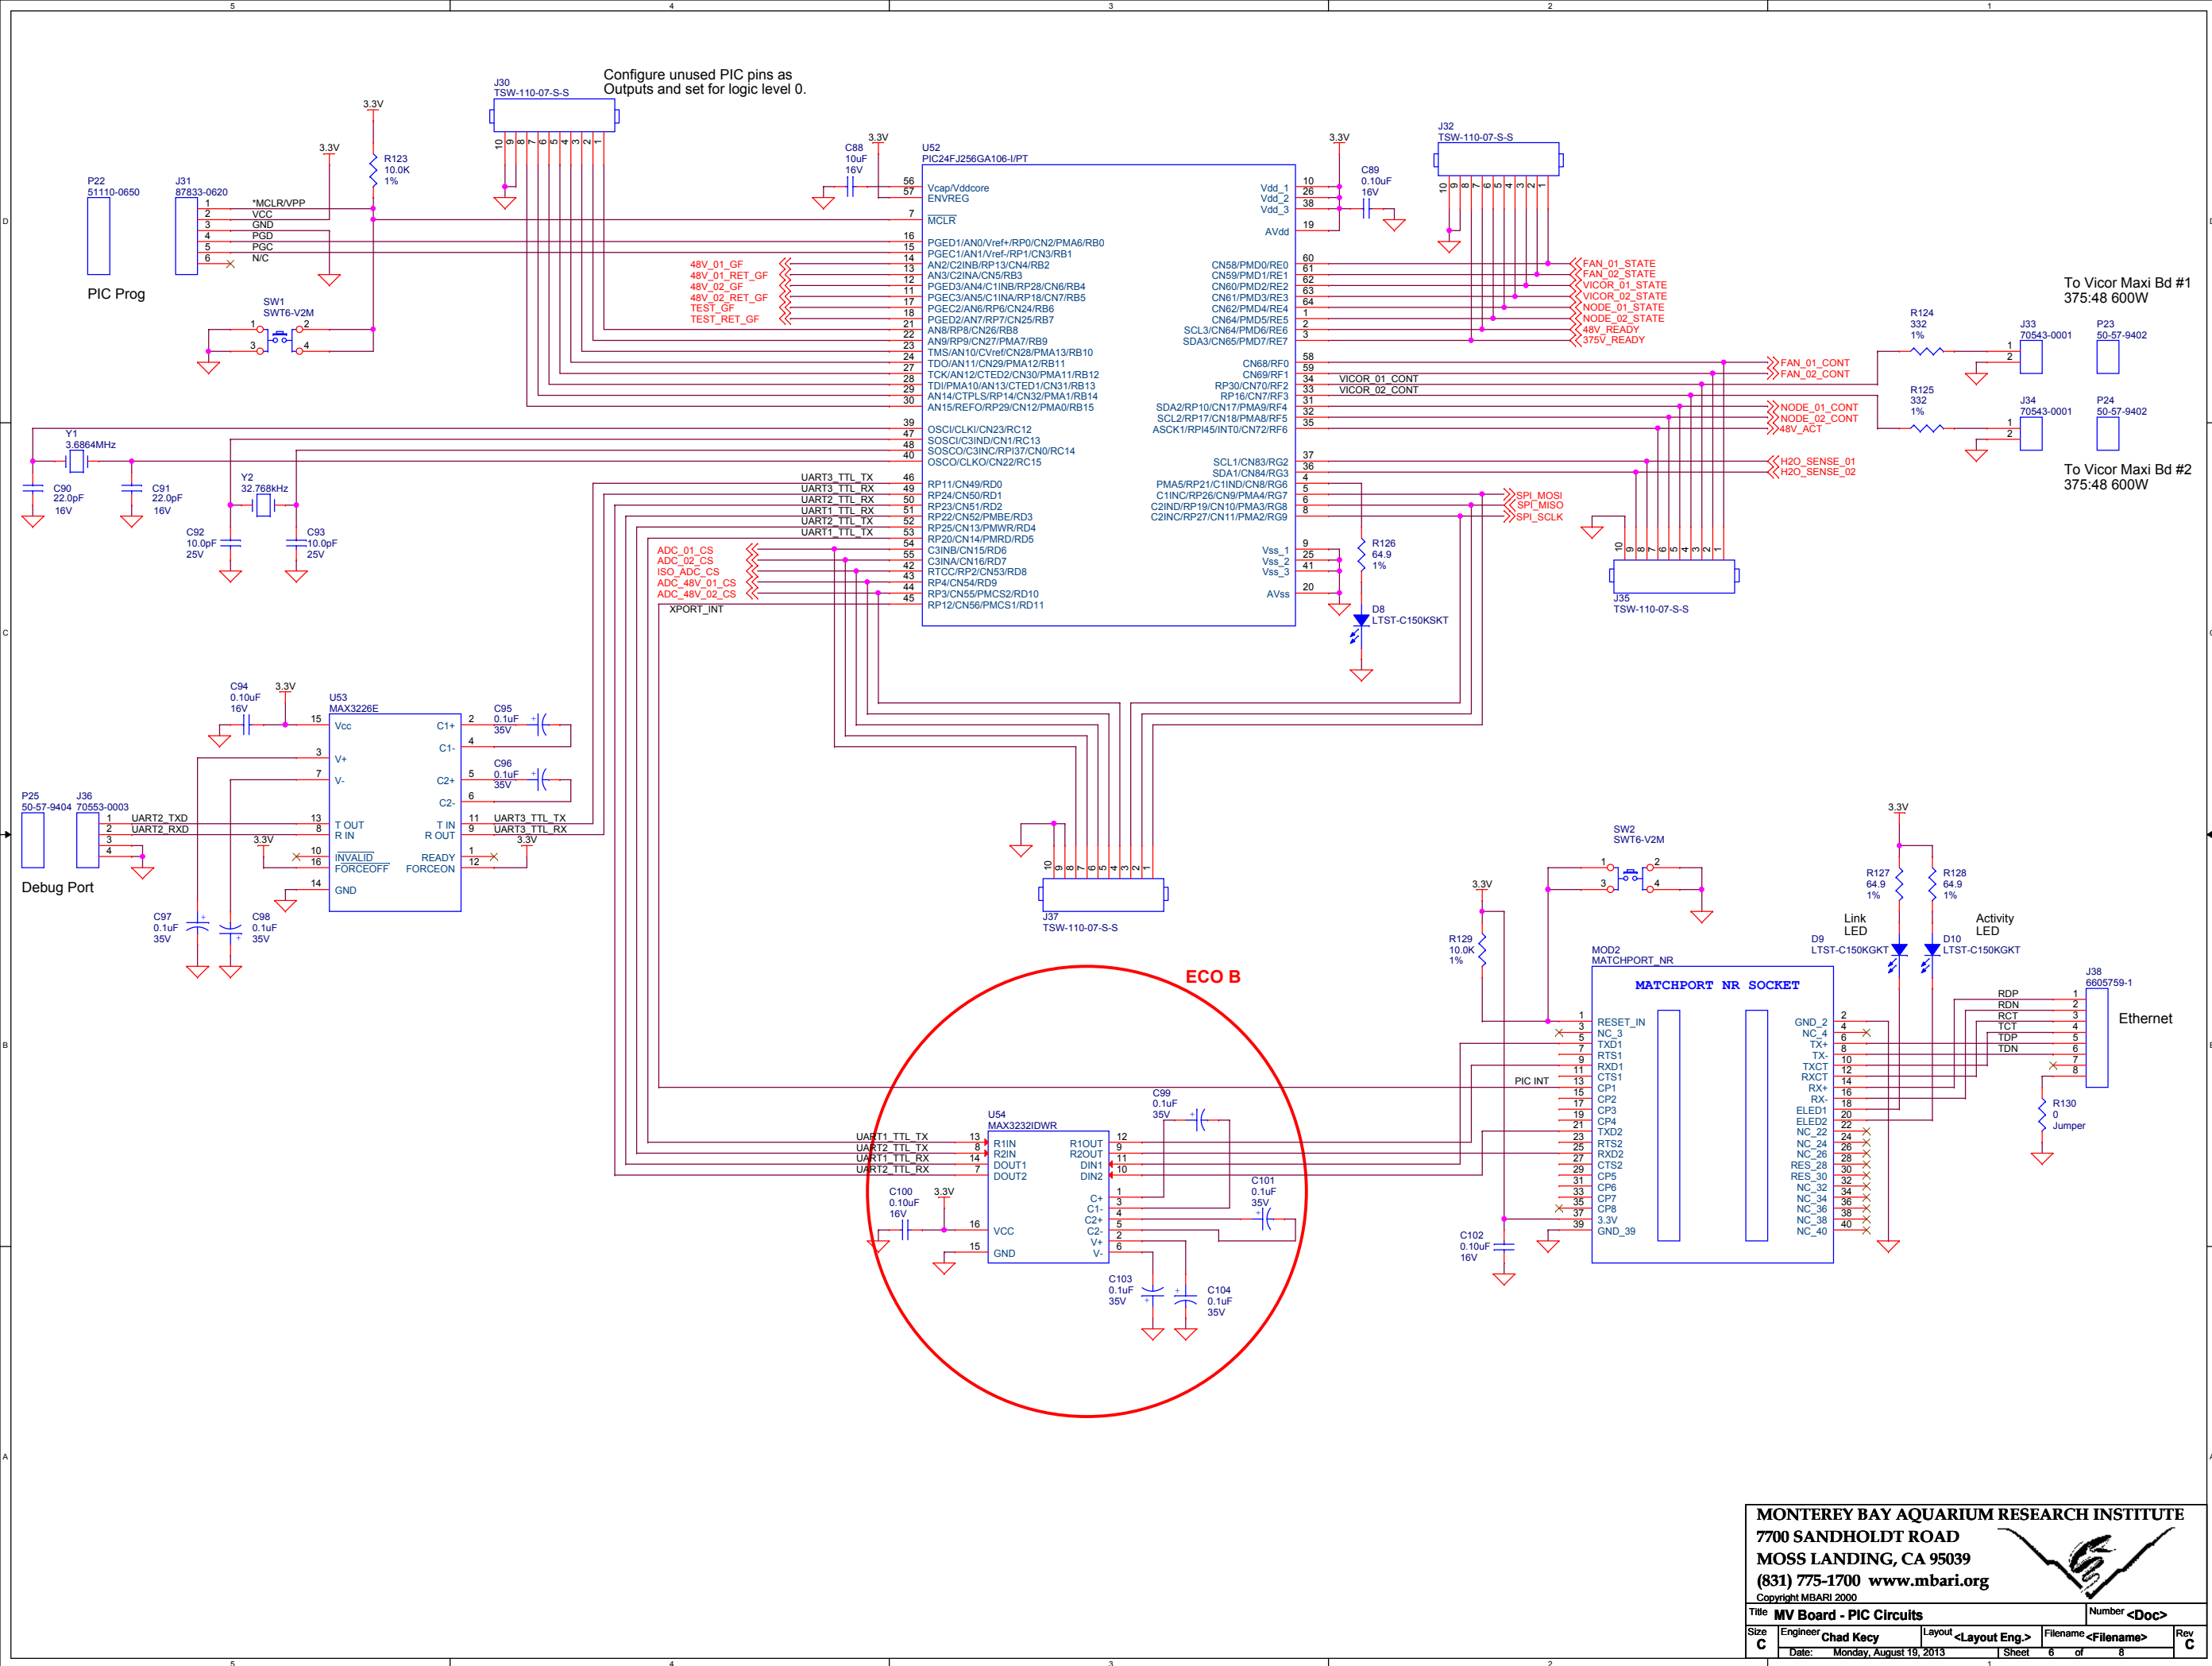

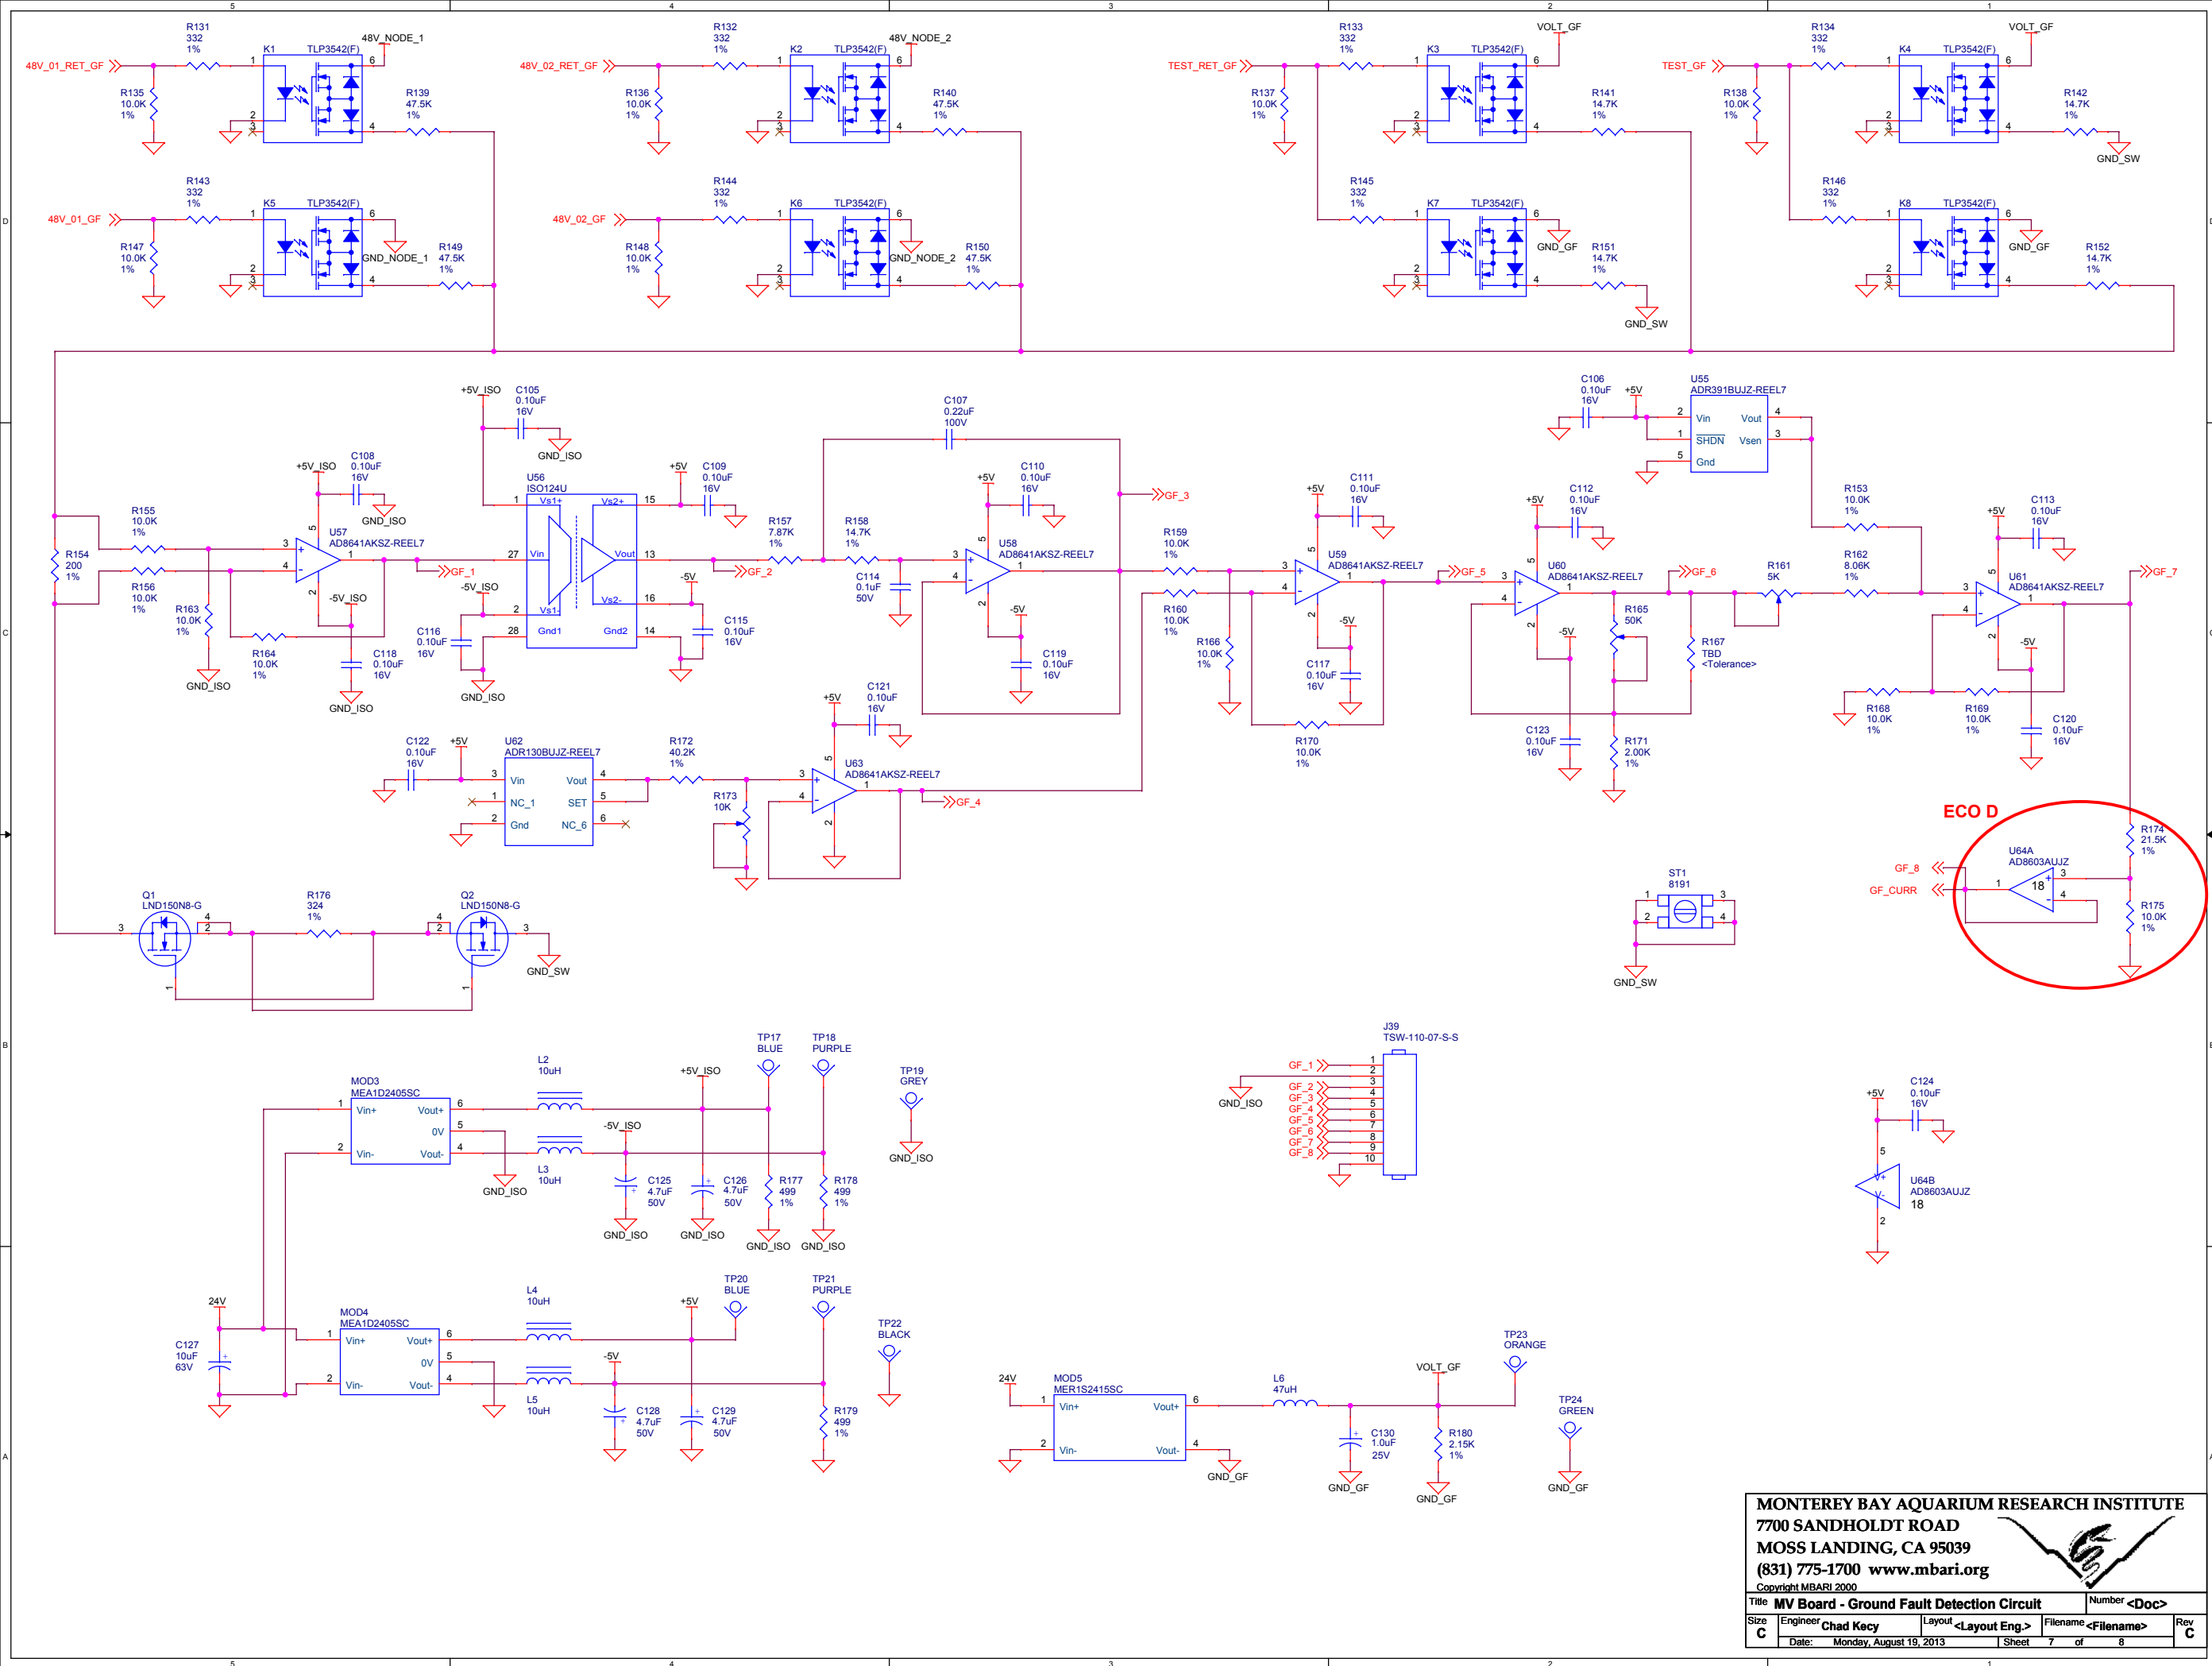

MONTEREY BAY AQUARIUM RESEARCH INSTITUTE
7700 SANDHOLDT ROAD
MOSS LANDING, CA 95039
(831) 775-1700 www.mbari.org
Copyright MBARI 2000

Title MV Board - Ground Fault Detection Circuit				Number <Doc>
Size C	Engineer Chad Key	Layout <Layout Eng.>	Filename <Filename>	Rev C
Date: Monday, August 19, 2013		Sheet 7	of 8	

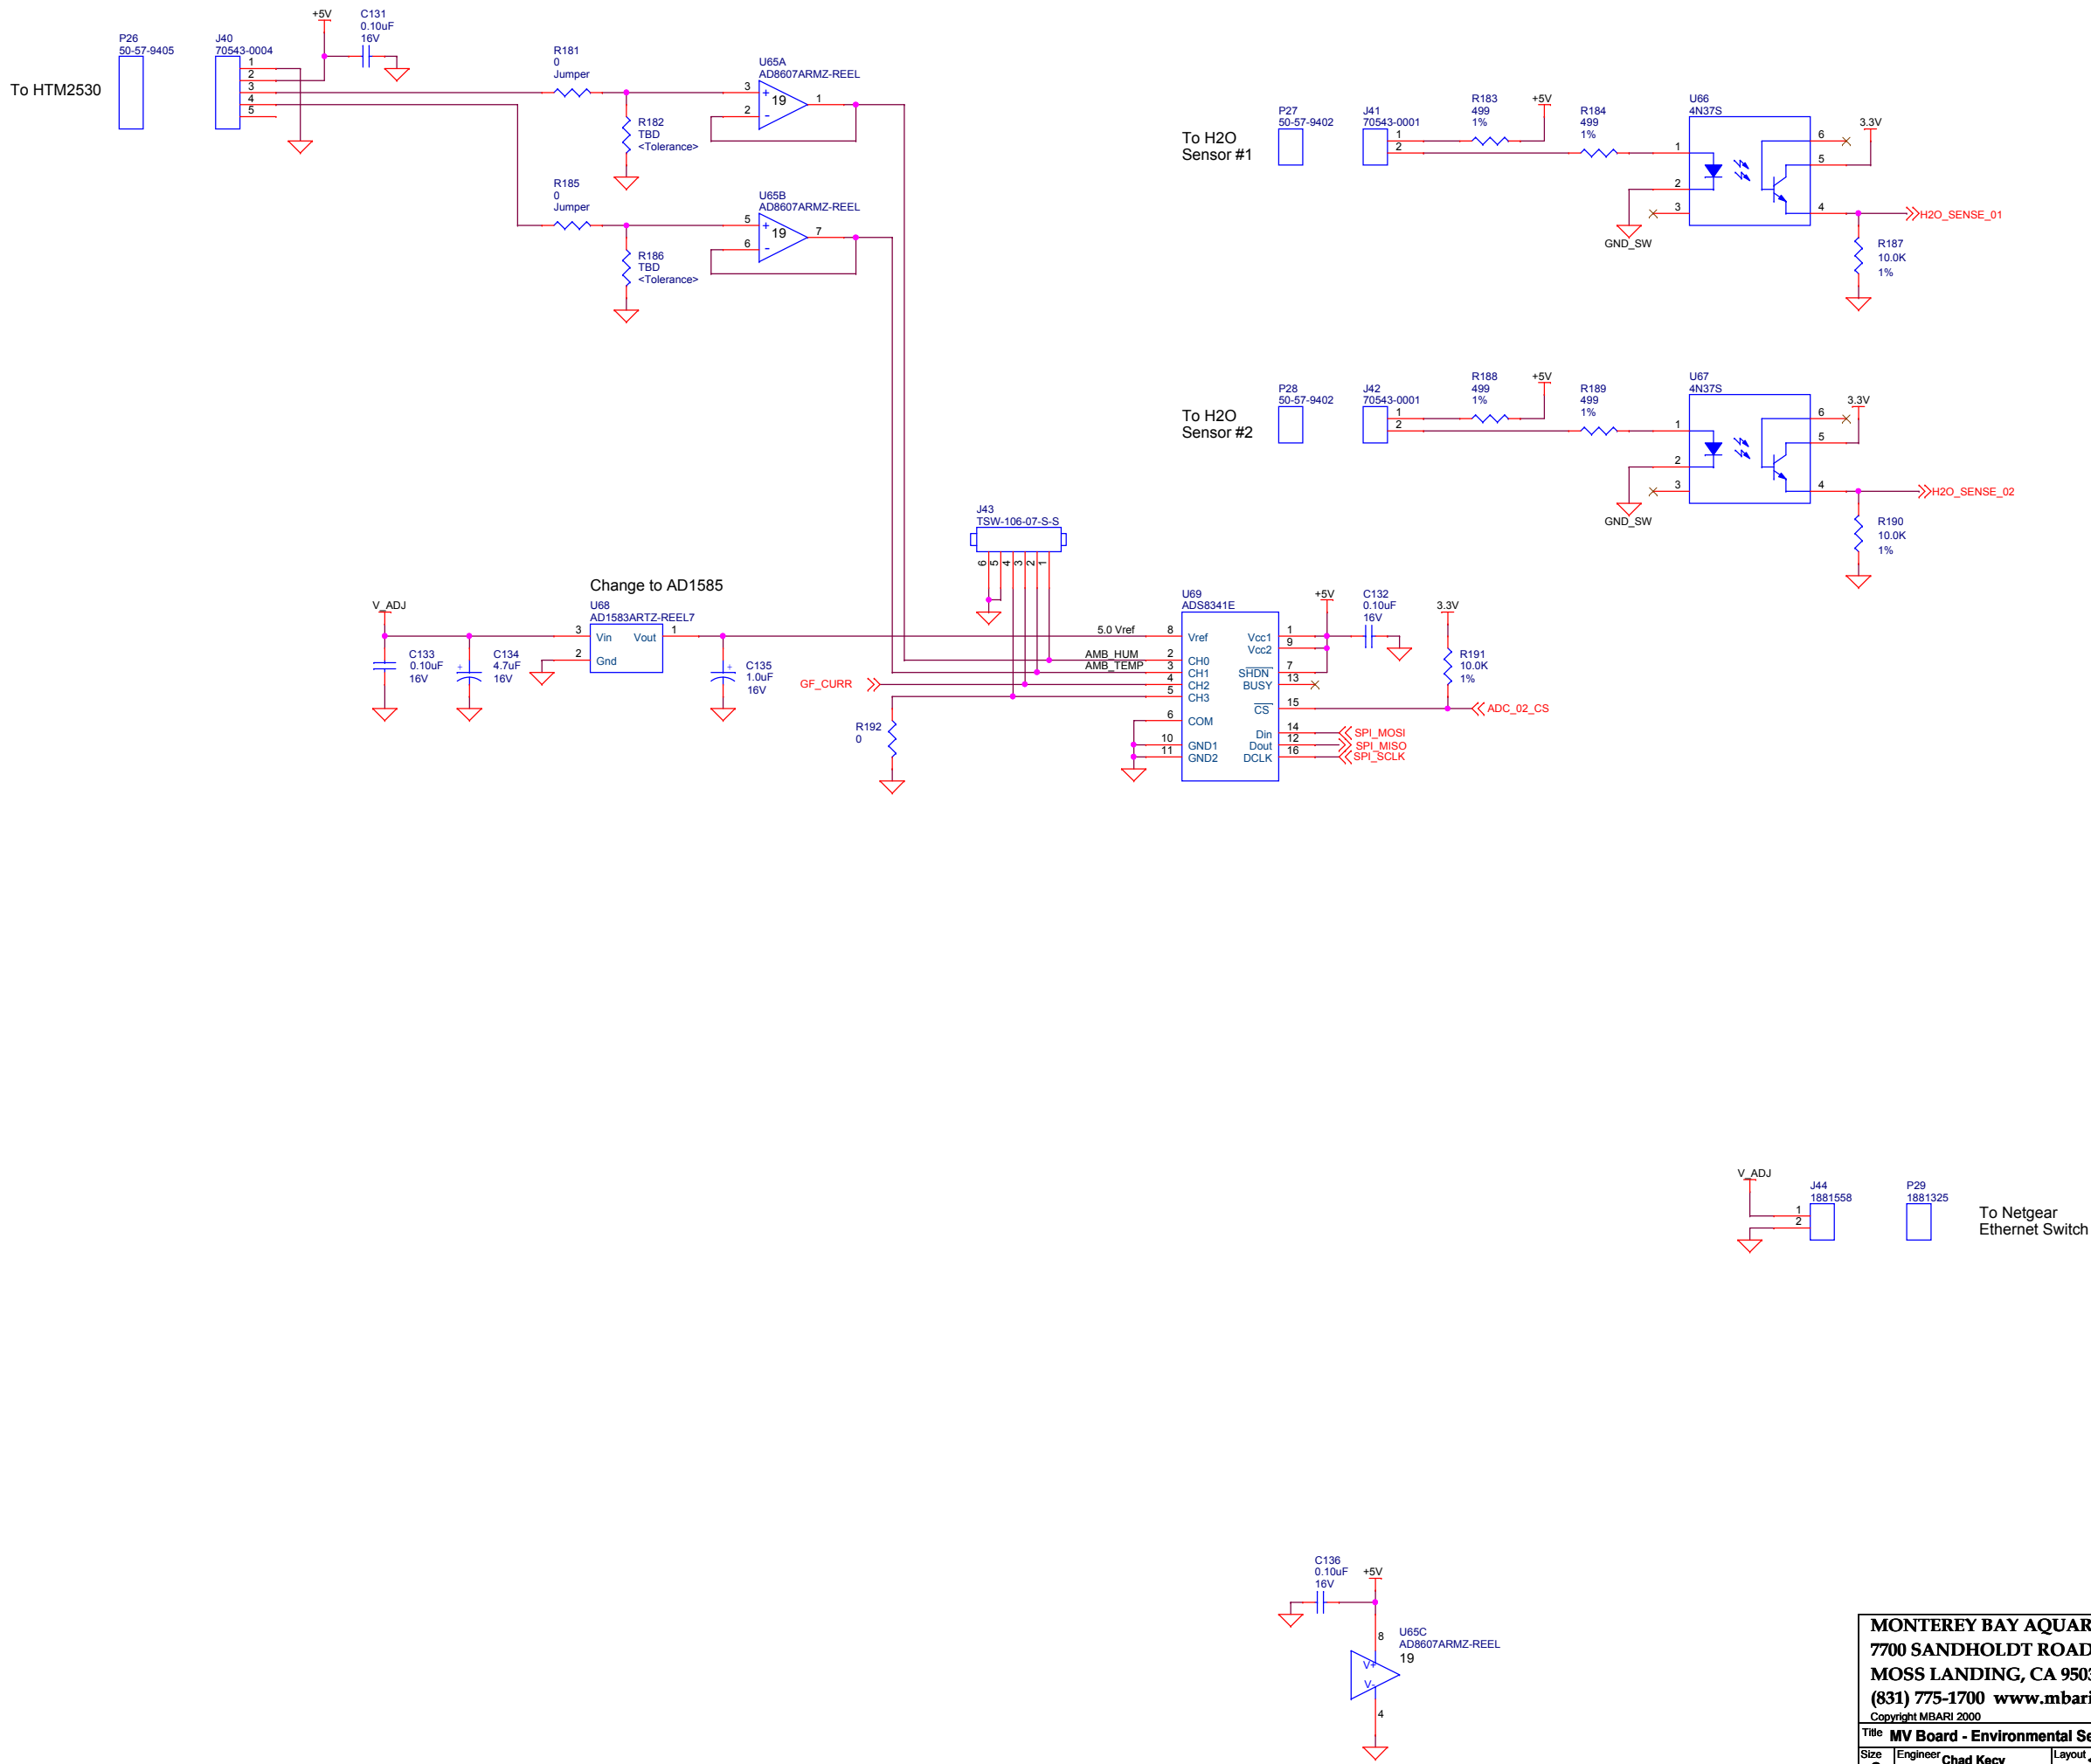

MONTEREY BAY AQUARIUM RESEARCH INSTITUTE
7700 SANDHOLDT ROAD
MOSS LANDING, CA 95039
(831) 775-1700 www.mbari.org
Copyright MBARI 2000



Title MV Board - Environmental Sensing Circuits				Number <Doc>
Size C	Engineer Chad Kacy	Layout <Layout Eng.>	Filename <Filename>	Rev C
Date: Monday, August 19, 2013		Sheet 8 of 8		