

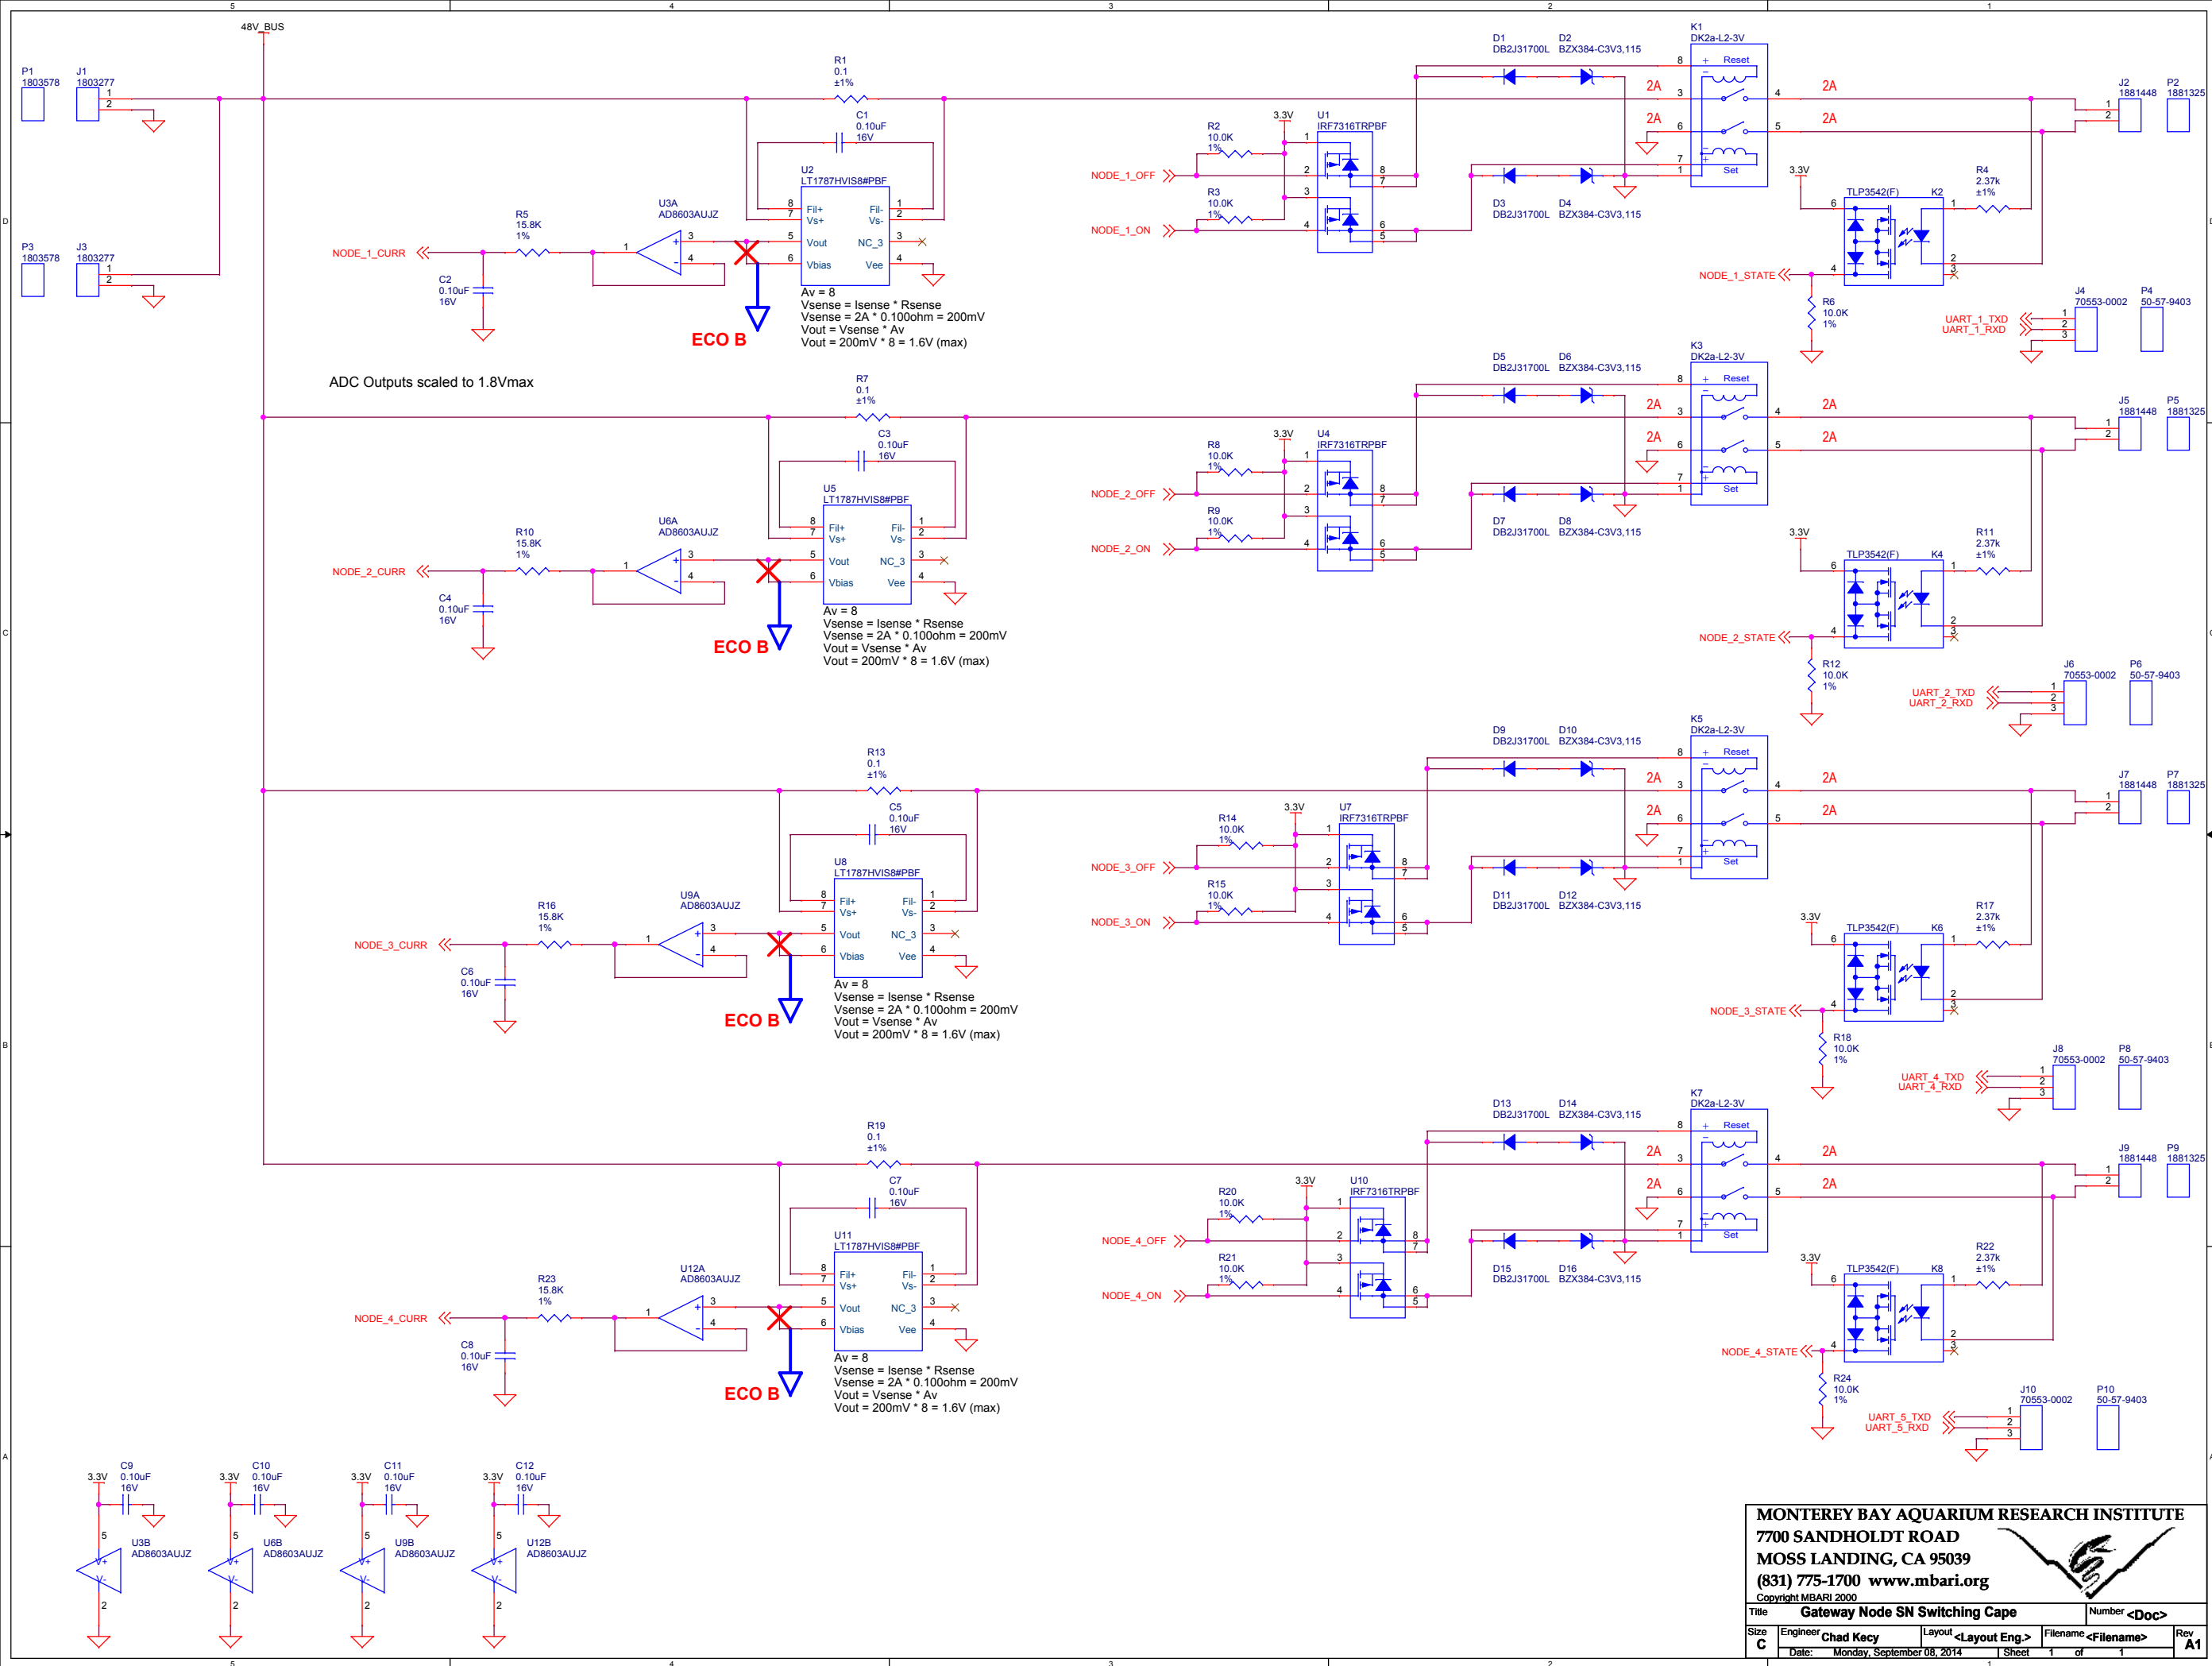
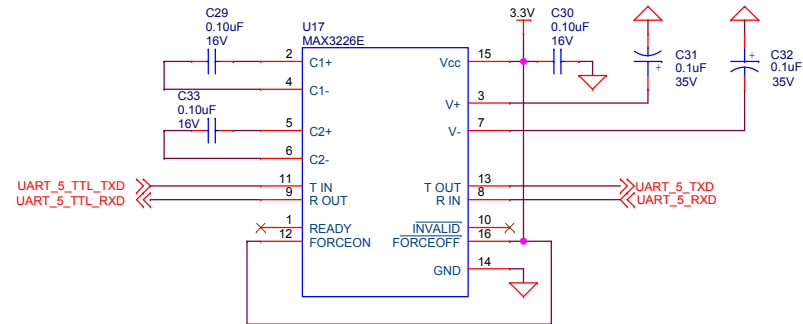
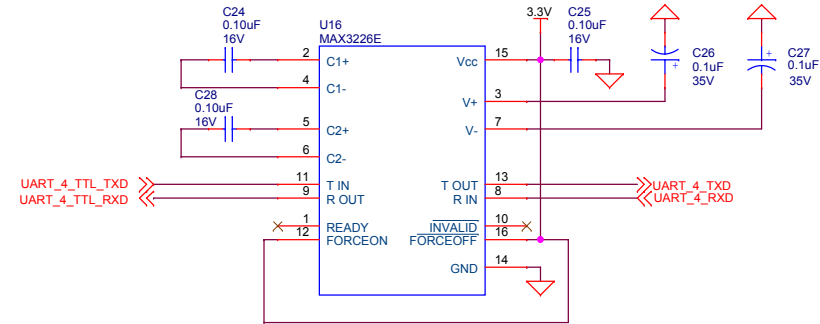
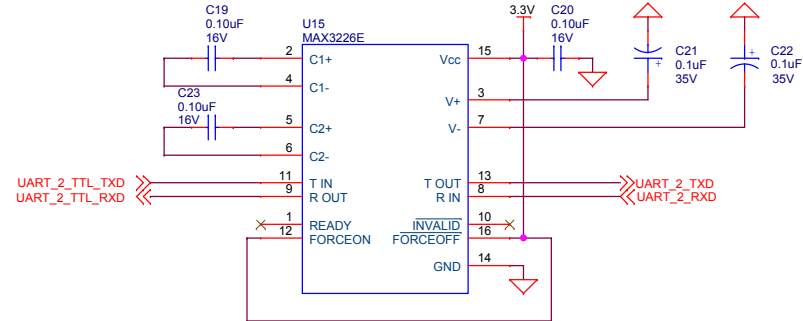


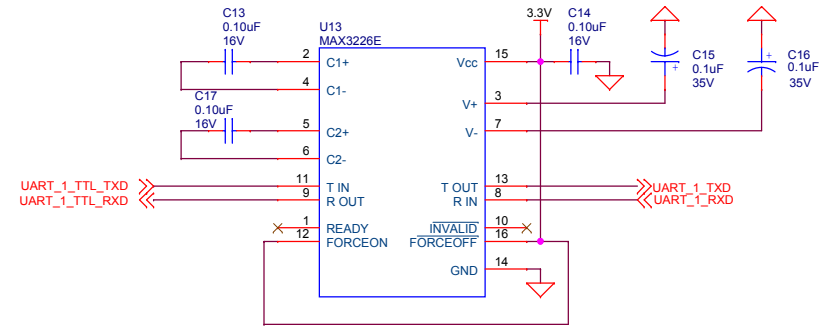

MONTEREY BAY AQUARIUM RESEARCH INSTITUTE
7700 SANDHOLDT ROAD
MOSS LANDING, CA 95039
(831) 775-1700 www.mbari.org
Copyright MBARI 2000


Title	Gateway Node SN Switching Cape		Number	<Doc>
Size	Engineer	Chad Kacy	Layout	<Layout Eng.>
C	Date	Monday, September 08, 2014	Filename	<Filename>
			Rev	A1

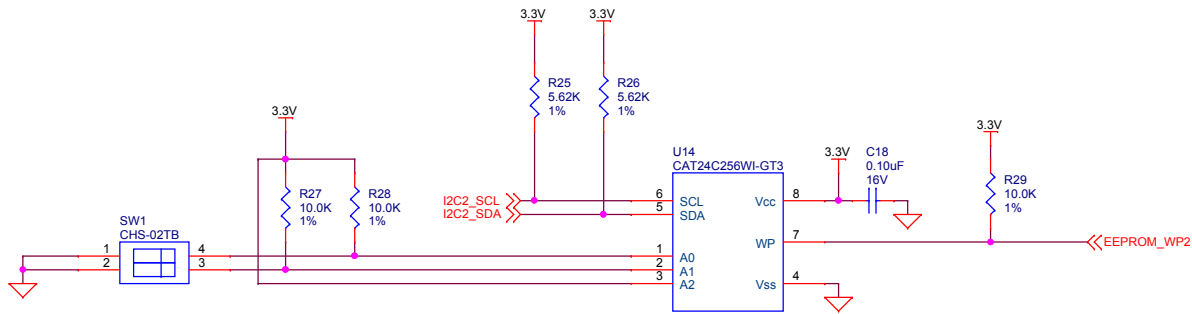

MONTEREY BAY AQUARIUM RESEARCH INSTITUTE
7700 SANDHOLDT ROAD
MOSS LANDING, CA 95039
(831) 775-1700 www.mbari.org
Copyright MBARI 2000



Title Gateway Node SN Switching Cape		Number <Doc>	
Size C	Engineer Chad Kacy	Layout <Layout Eng.>	Rev A1
Date: Monday, September 08, 2014		Sheet 2 of 2	

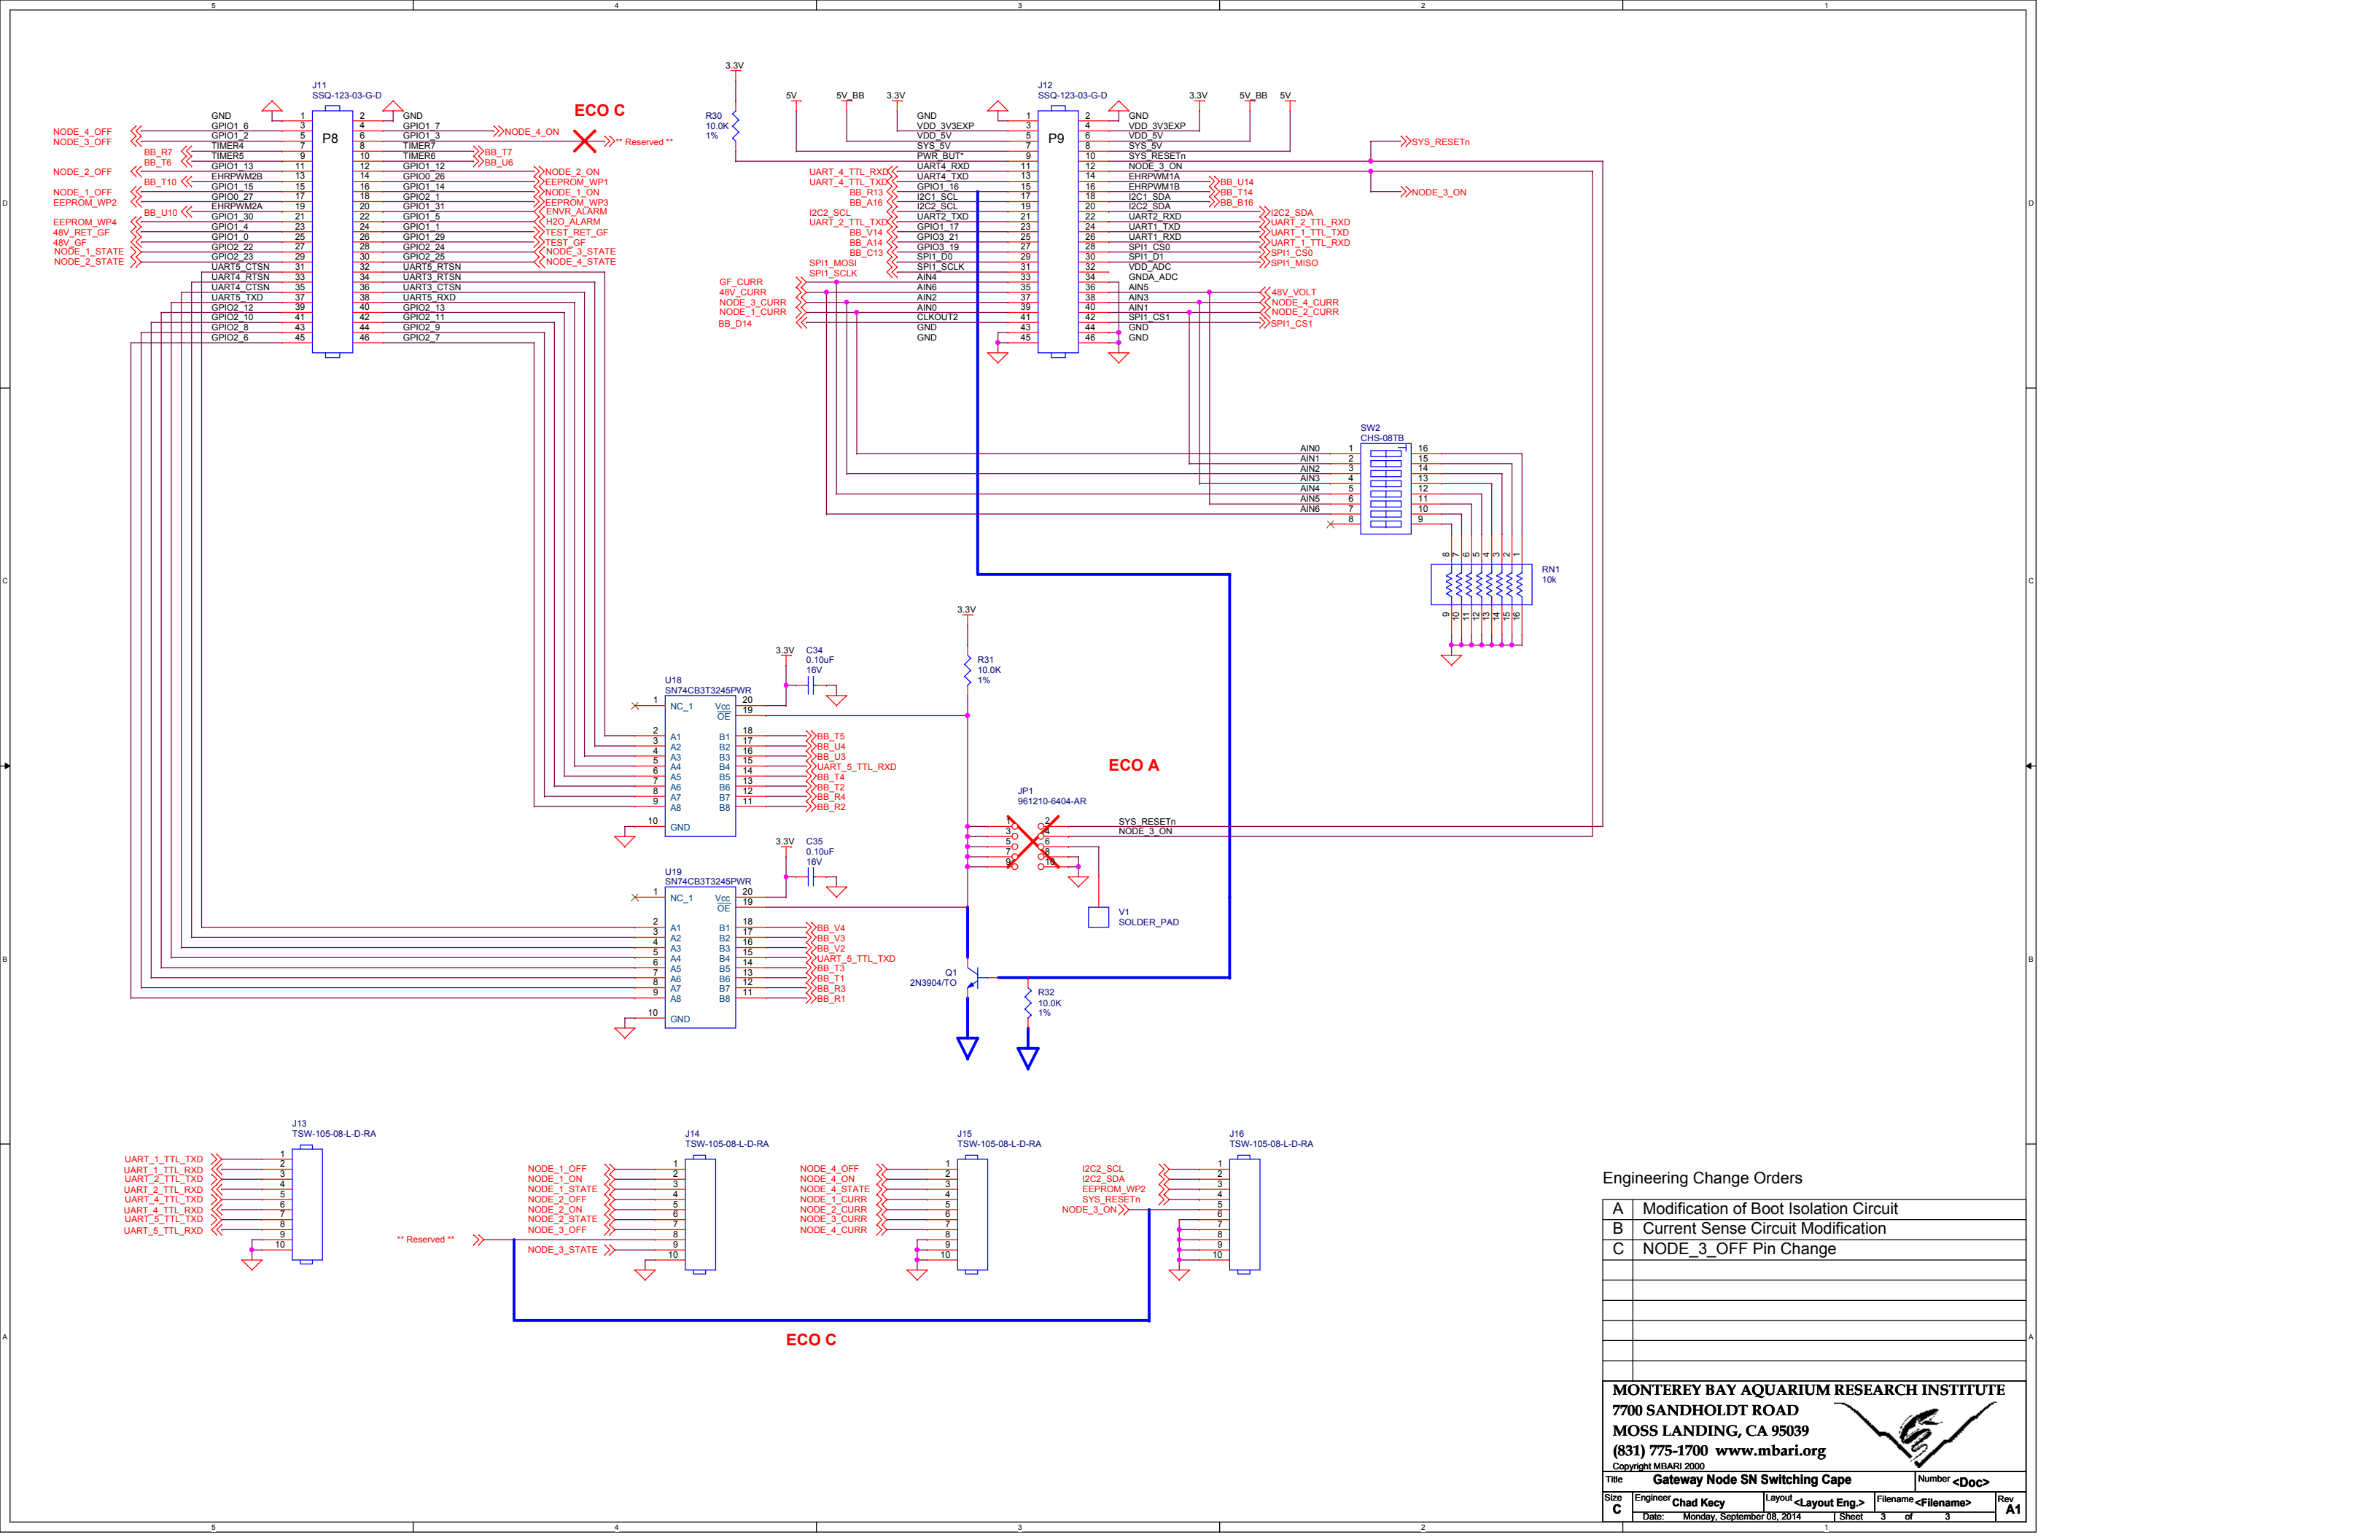

Engineering Change Orders

A	Modification of Boot Isolation Circuit
B	Current Sense Circuit Modification
C	NODE_3_OFF Pin Change

MONTEREY BAY AQUARIUM RESEARCH INSTITUTE
7700 SANDHOLDT ROAD
MOSS LANDING, CA 95039
(831) 775-1700 www.mbari.org
Copyright MBARI 2000

TitleGateway Node SN Switching CapeNumber<Doc>

SizeEngineerChad KacyLayout<Layout Eng.>Filename<Filename>RevA1

DateMonday, September 08, 2014Sheet3 of 3