


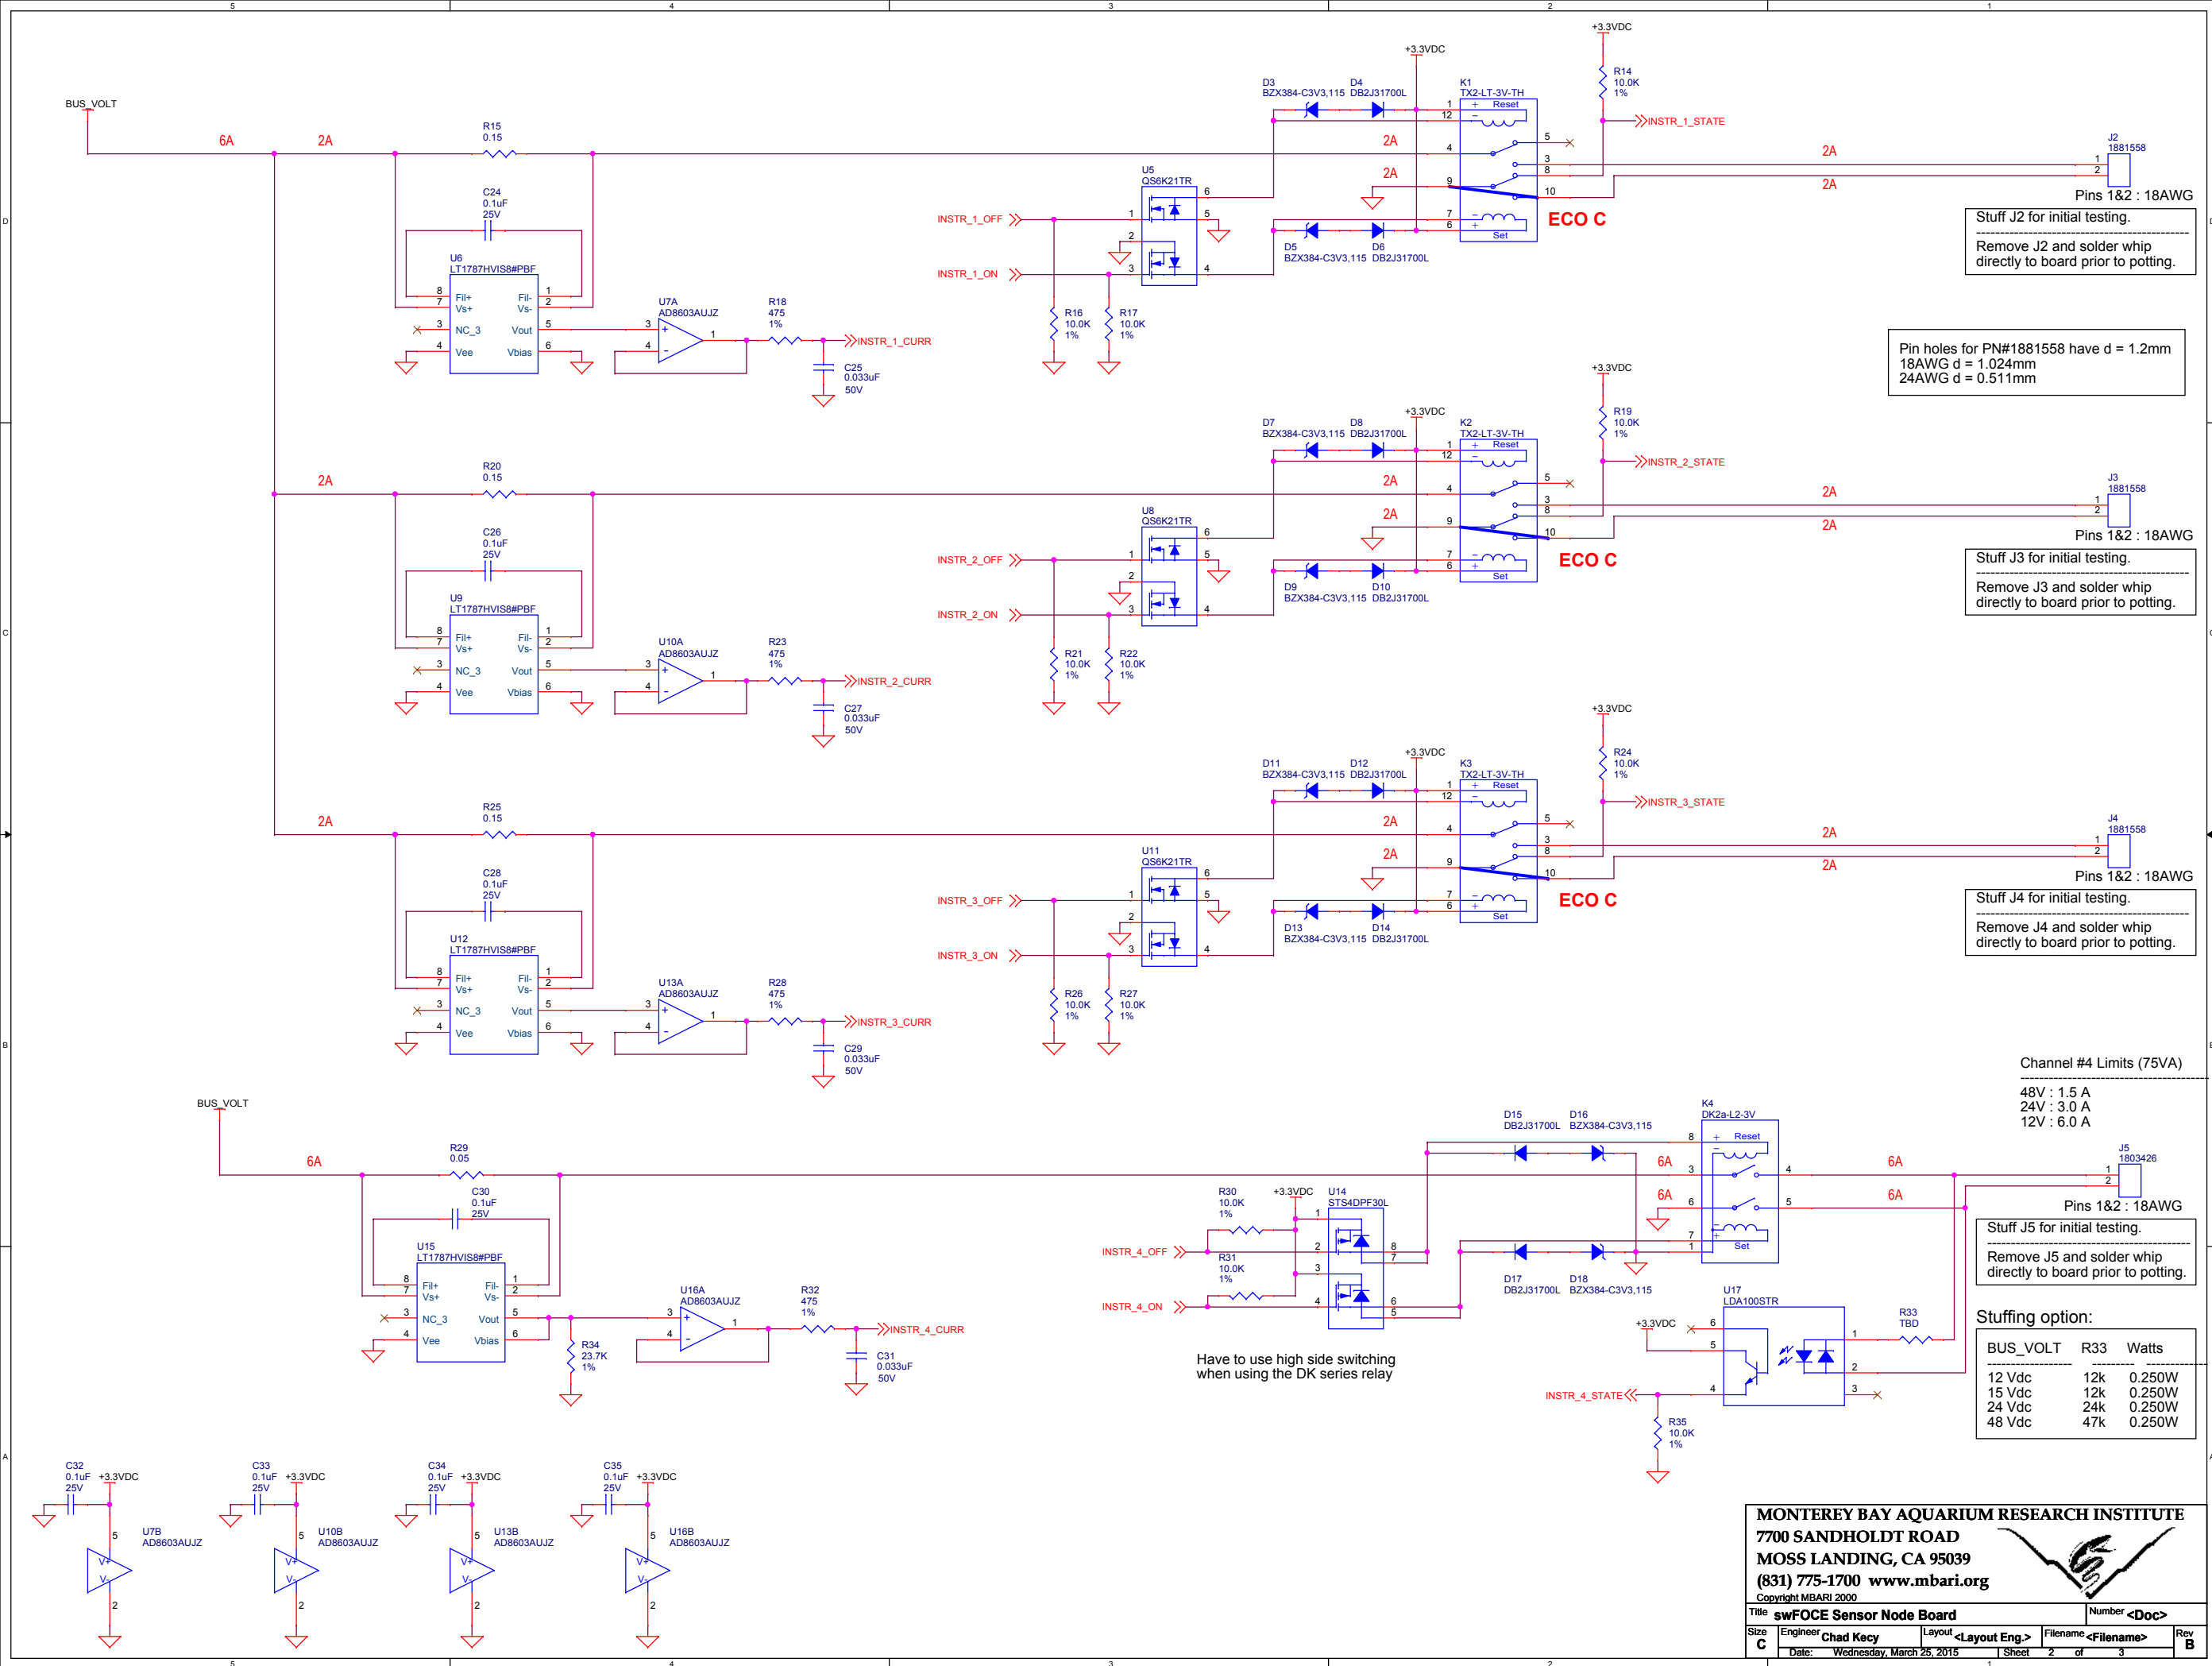





Remove J7, J8, J9, and J10 and solder whip directly to board prior to potting.

Optional parts for 4-20ma circuit.

If not using 4-20ma, the following parts can be no stuff:
R48, R49, R50, R52, R53, C58, C59, C60, C62, U24, U25.
Also populate R51 with a zero ohm resistor.

If using 4-20ma, populate above parts, but leave R51 open.

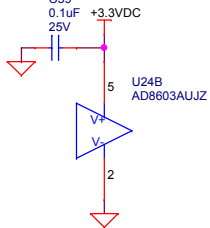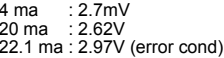

MONTEREY BAY AQUARIUM RESEARCH INSTITUTE
7700 SANDHOLDT ROAD
MOSS LANDING, CA 95039
(831) 775-1700 www.mbary.org
Copyright MBARI 2000

Title swFOCE Sensor Node Board				Number <Doc>	
Size C	Engineer Chad Key		Layout <Layout Eng.>		Rev B
	Date: Wednesday, March 25, 2015		Sheet 3 of 3		