


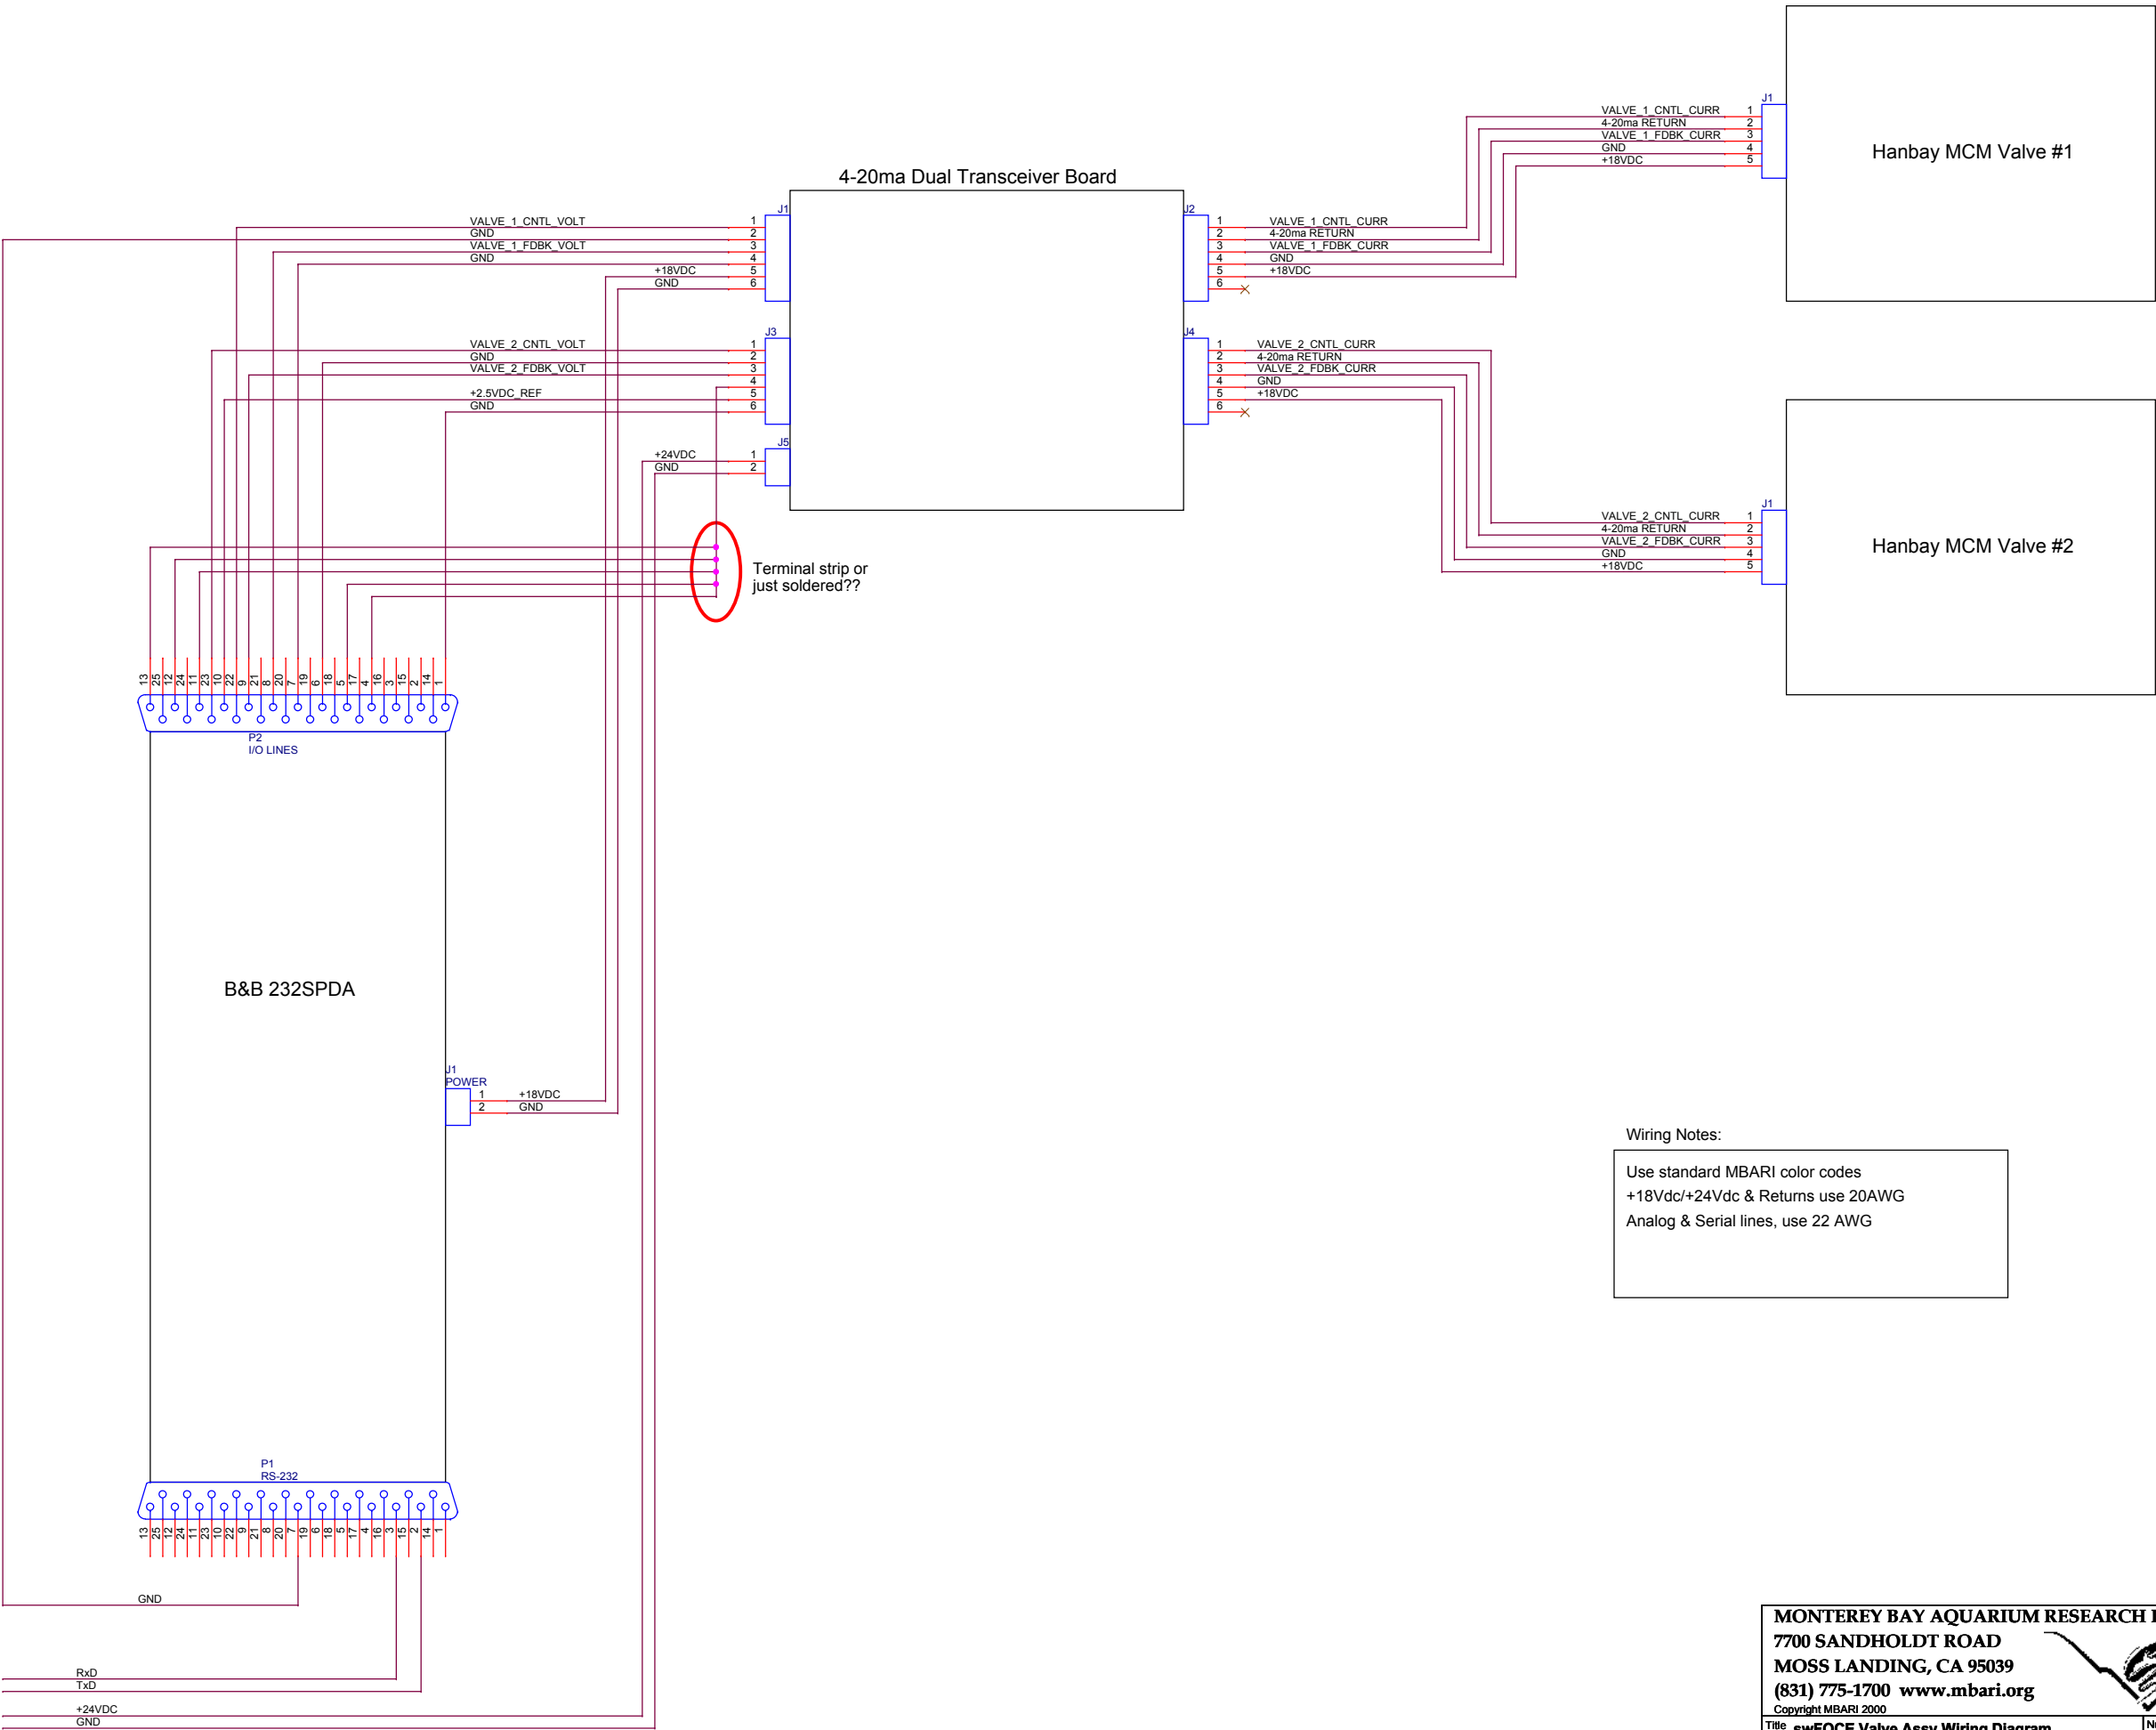

MONTEREY BAY AQUARIUM RESEARCH INSTITUTE
7700 SANDHOLDT ROAD
MOSS LANDING, CA 95039
(831) 775-1700 www.mbari.org
Copyright MBARI 2000



Title swFOCE Valve Assy Wiring Diagram				Number <Doc>
Size C	Engineer Chad Kacy	Layout <Layout Eng.>	Filename <Filename>	Rev B
Date: Tuesday, March 04, 2014		Sheet 9 of 9		