


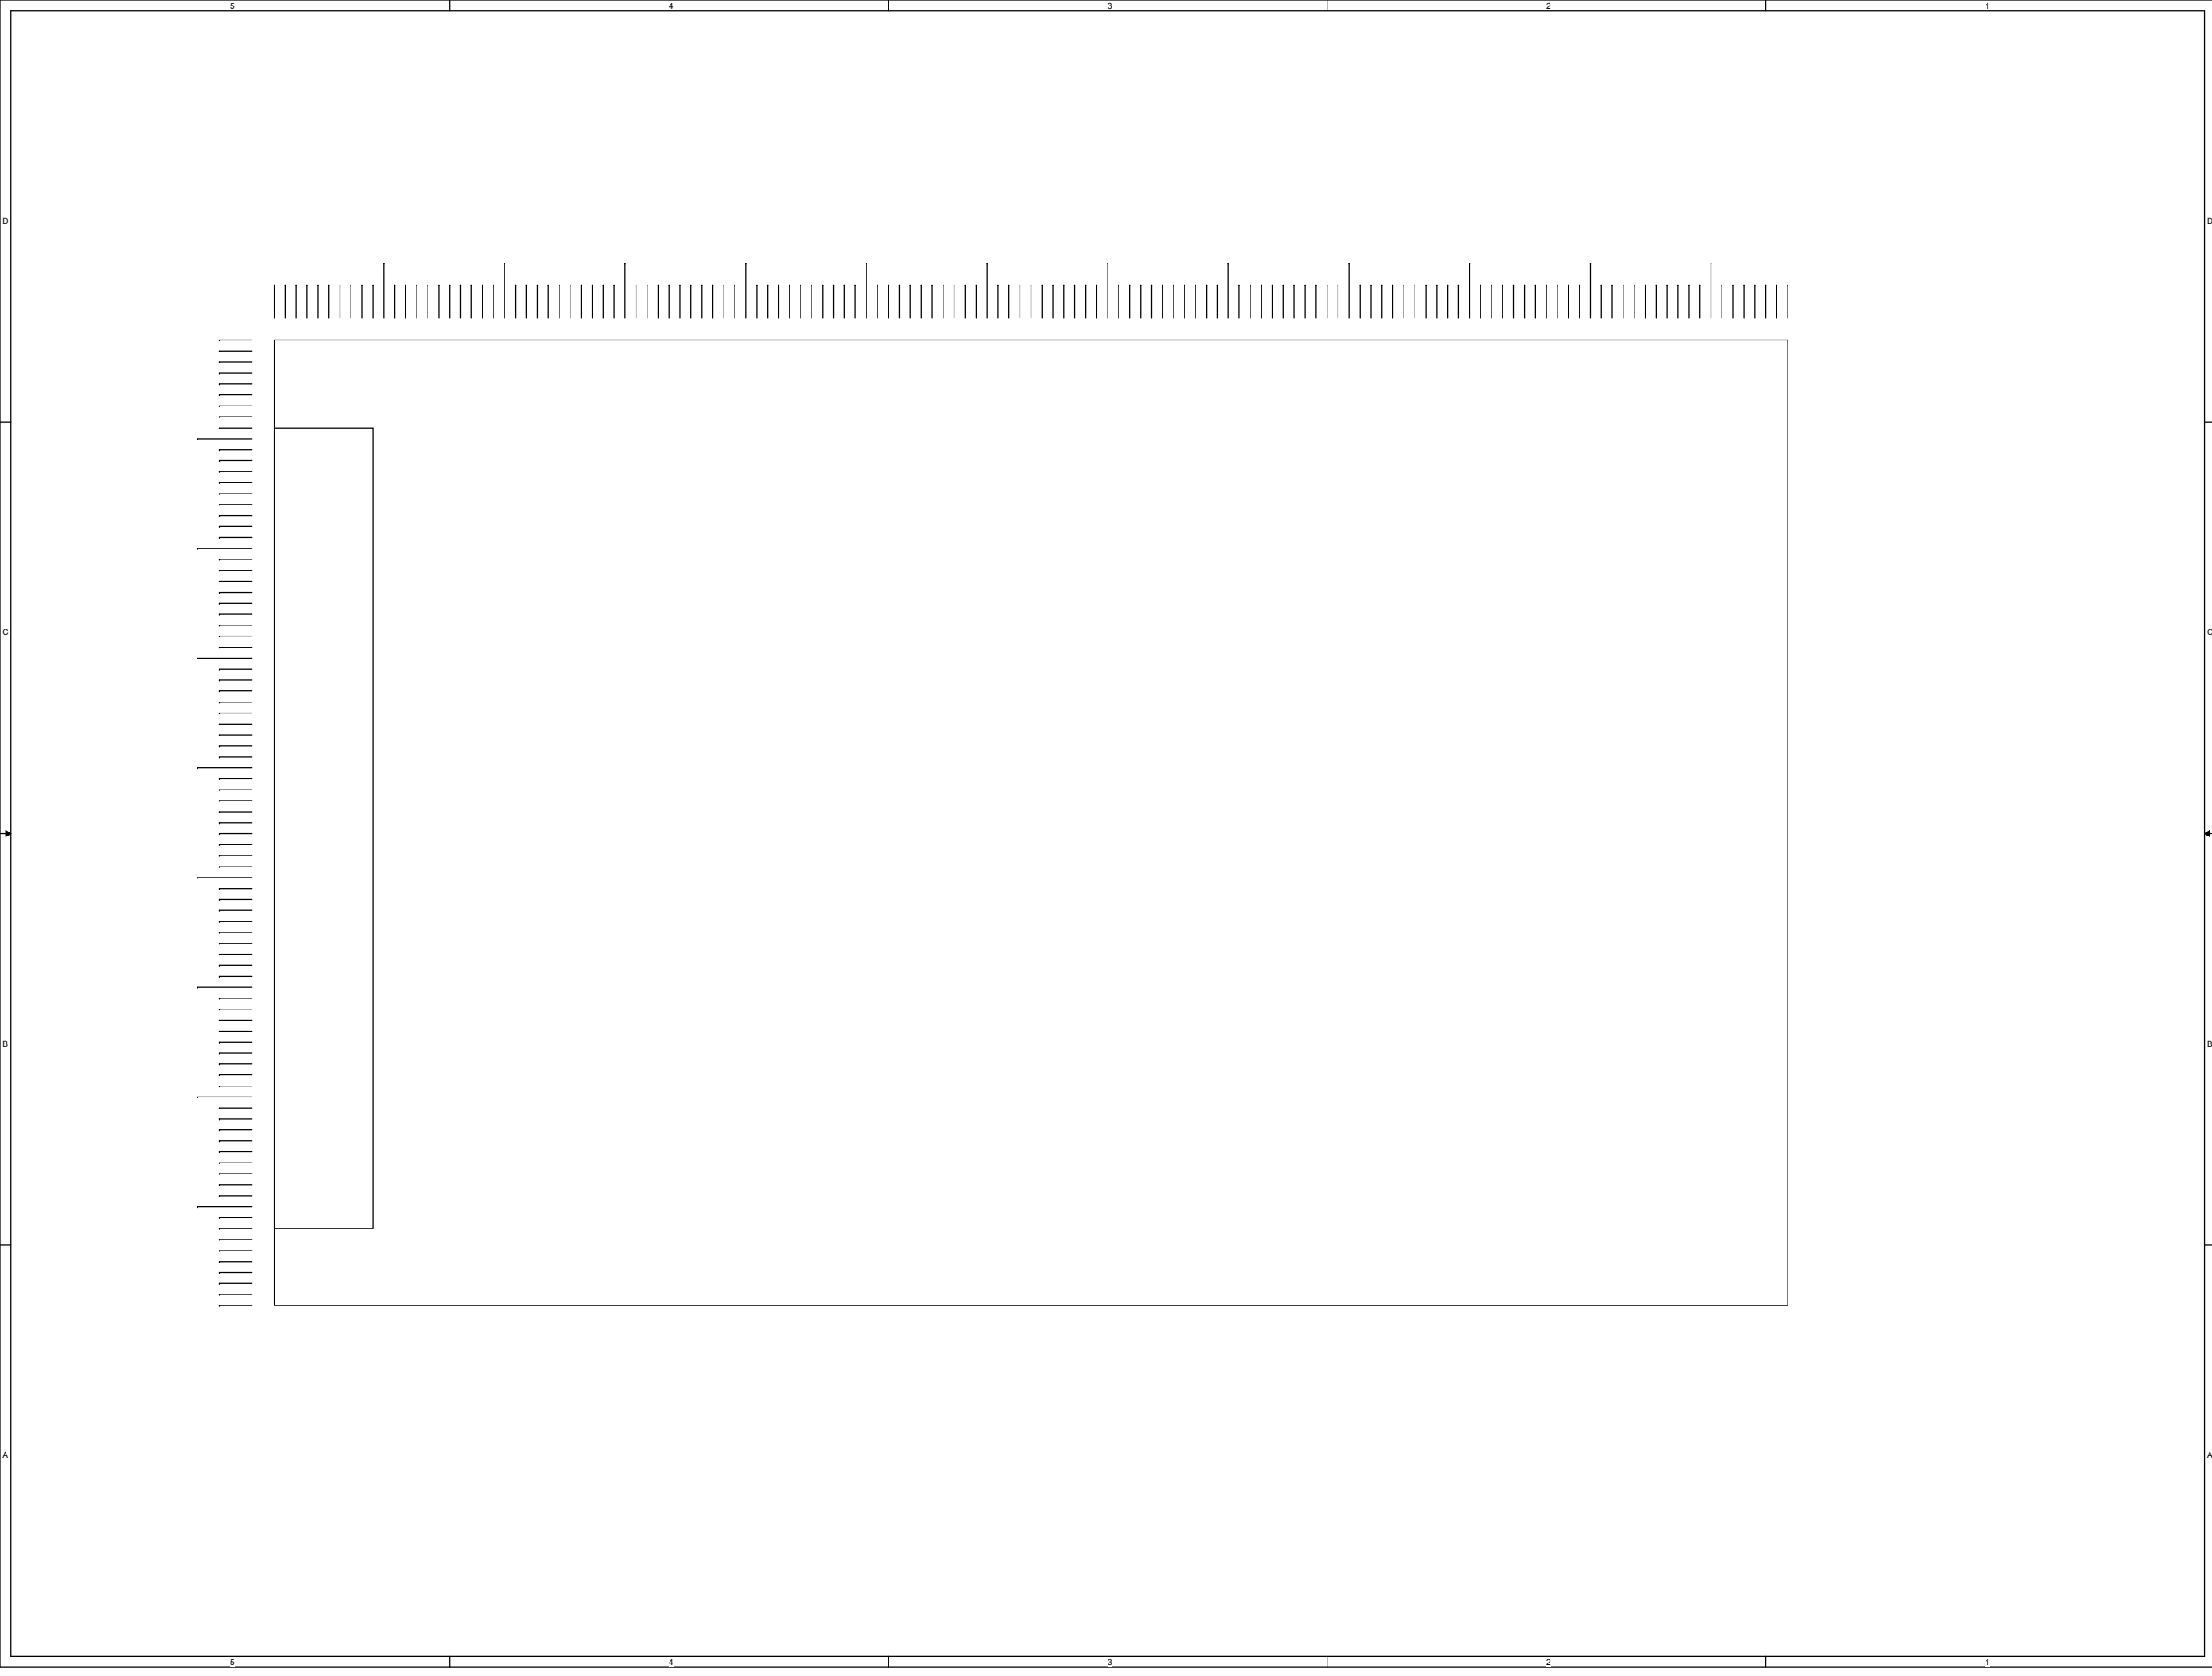
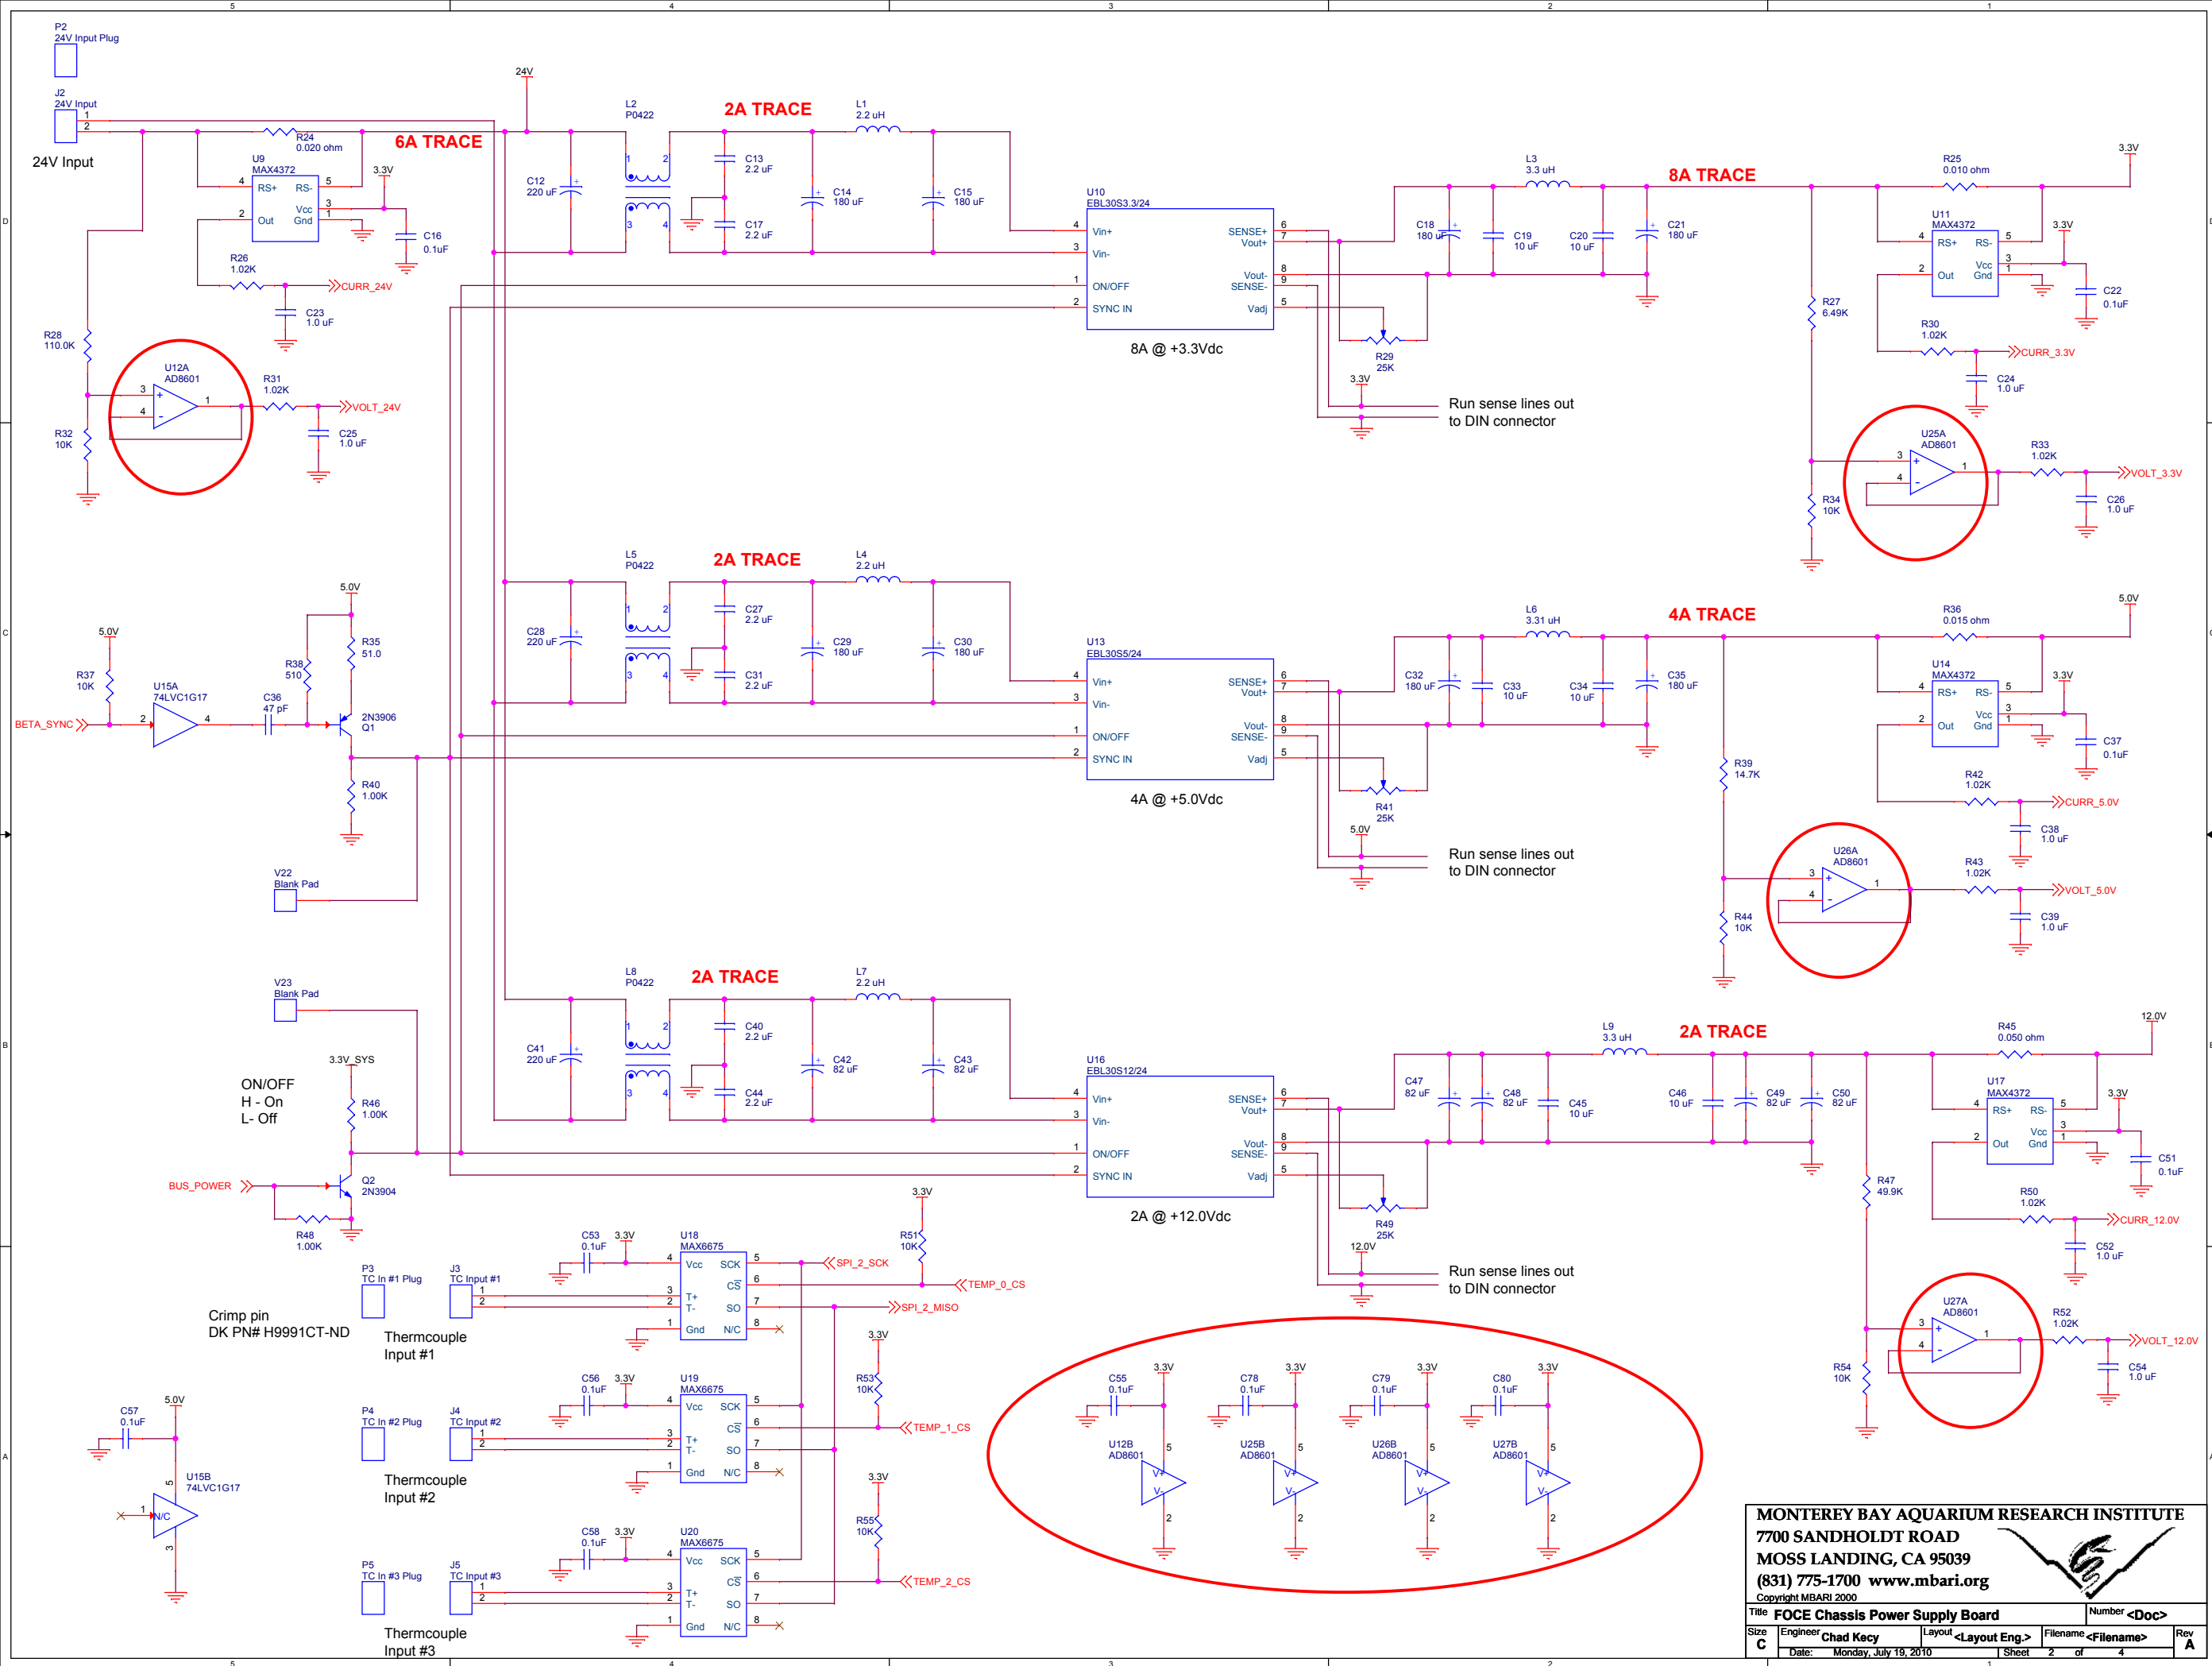
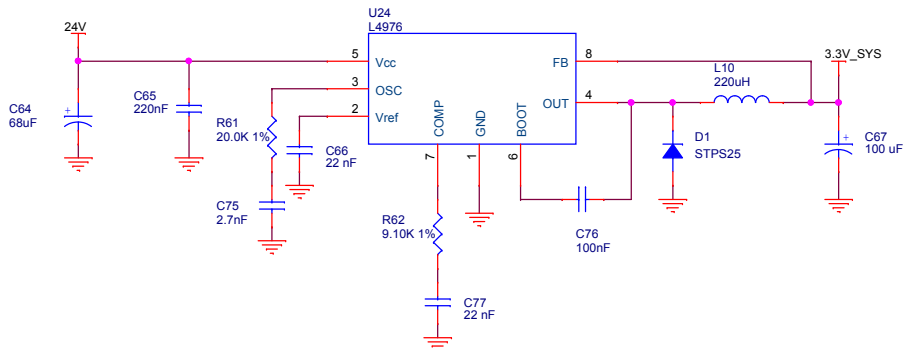
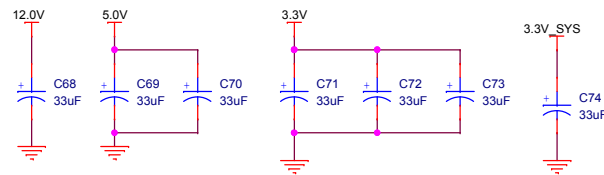
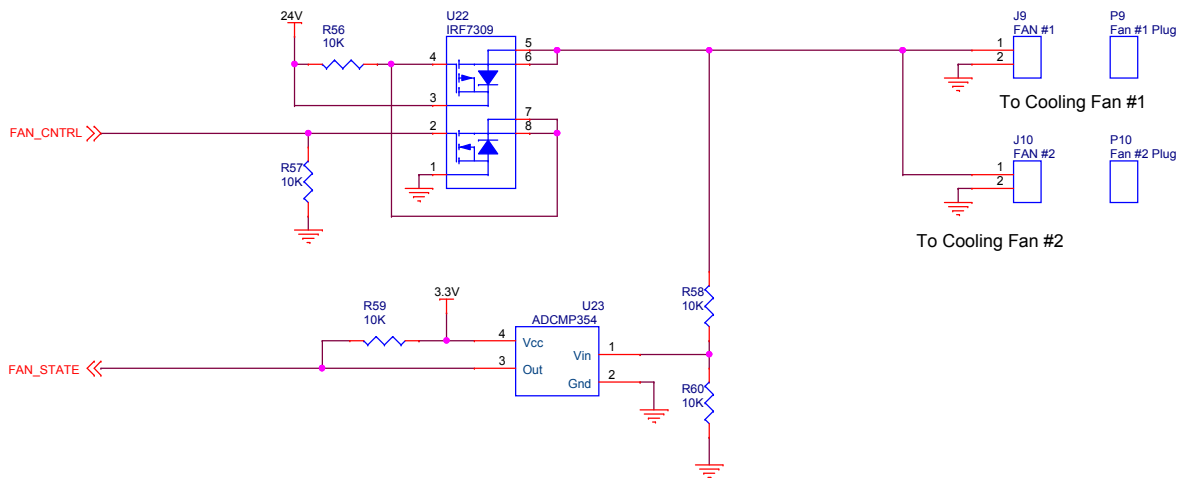


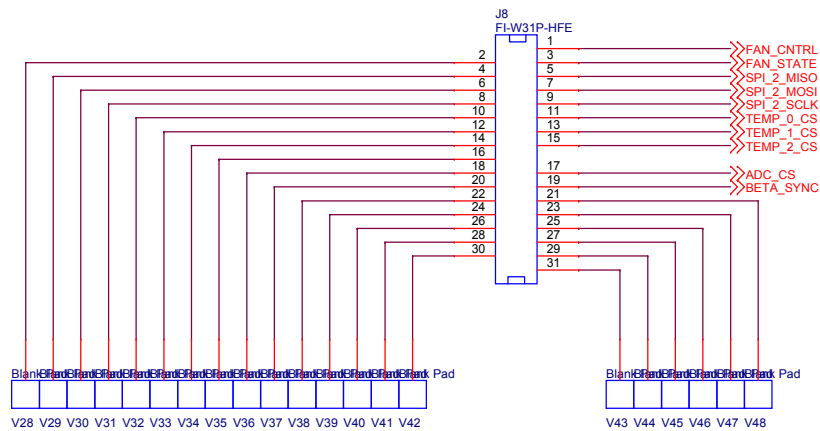

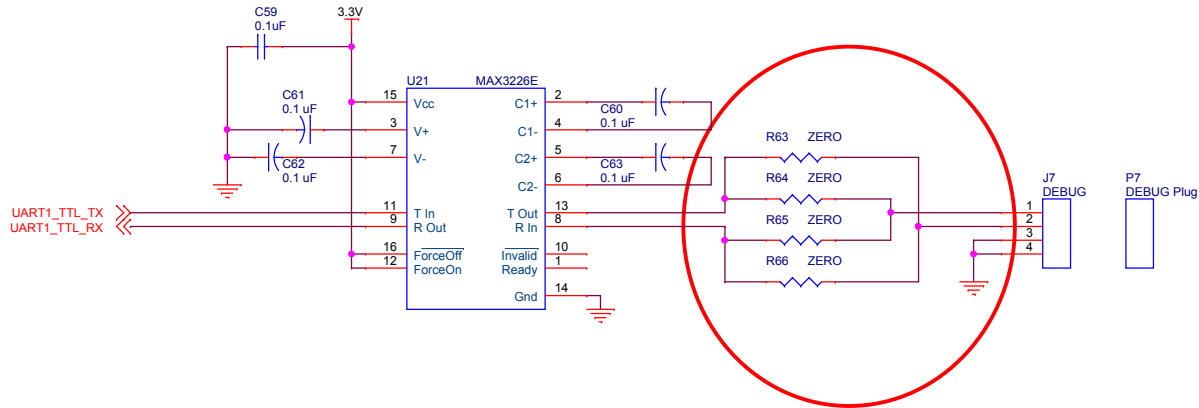

MONTEREY BAY AQUARIUM RESEARCH INSTITUTE
7700 SANDHOLDT ROAD
MOSS LANDING, CA 95039
(831) 775-1700 www.mbari.org
Copyright MBARI 2000

Title FOCE Chassis Power Supply Board			Number <Doc>
Size C	Engineer Chad Kacy	Layout <Layout Eng.>	Filename <Filename>
Date: Monday, July 19, 2010	1	Sheet 2 of 4	Rev A

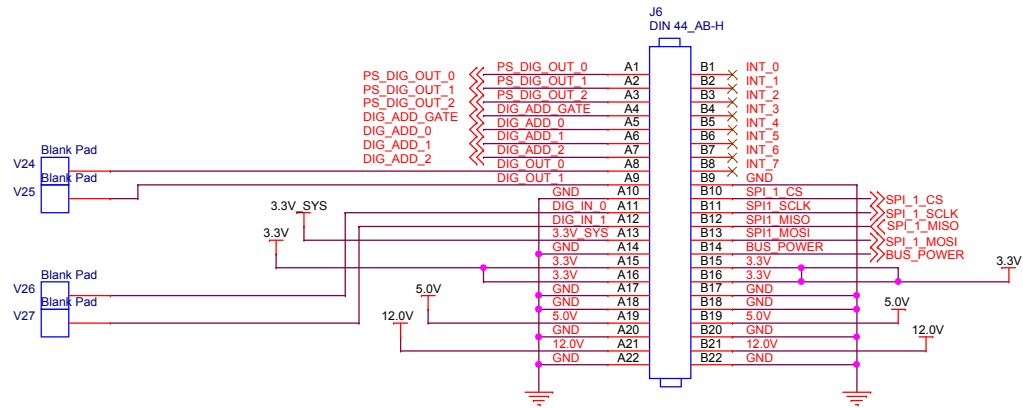

Place physically close
to the DIN Connector

MONTEREY BAY AQUARIUM RESEARCH INSTITUTE
7700 SANDHOLDT ROAD
MOSS LANDING, CA 95039
(831) 775-1700 www.mbari.org
Copyright MBARI 2000

Title	FOCE Chassis Power Supply Board			Number	<Doc>	
Size	Engineer	Chad Key	Layout	<Layout Eng.>	Filename	<Filename>
C	Date:	Tuesday, July 20, 2010	Sheet	3	of	4
					Rev	A