



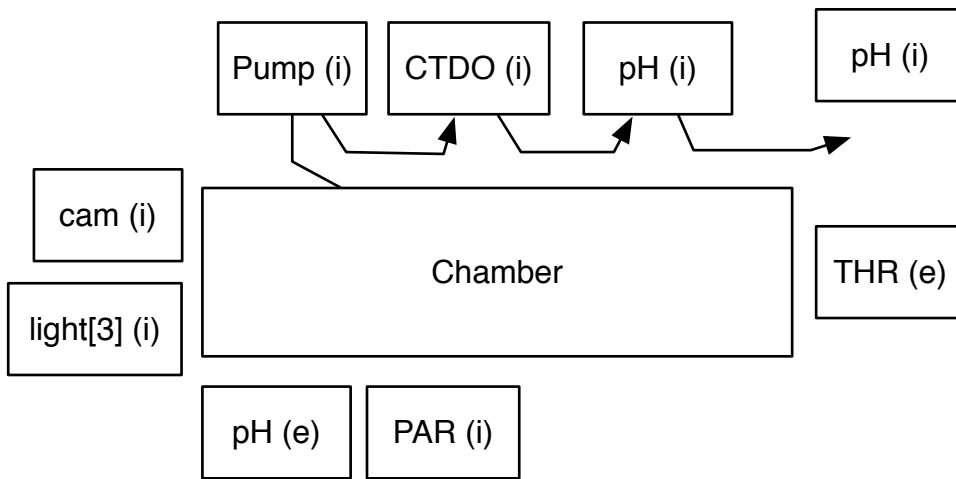

2 internal pH,
1 Pump - how does
that work, if water
comes from same
place?

External pH pumped
too? by what?

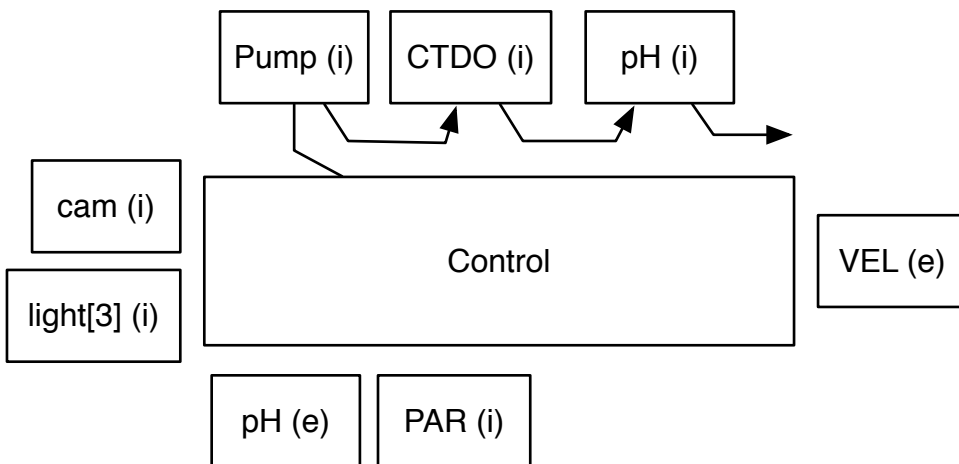

i: internal
e: external
r: reference (environment)
CTDO: SBE52MP+43
Pump: CTDO pump
pH: SBE18S
THR: thruster

Is reference CTD
pumped?

Is there a reference
(environment) pH
sensor?

