


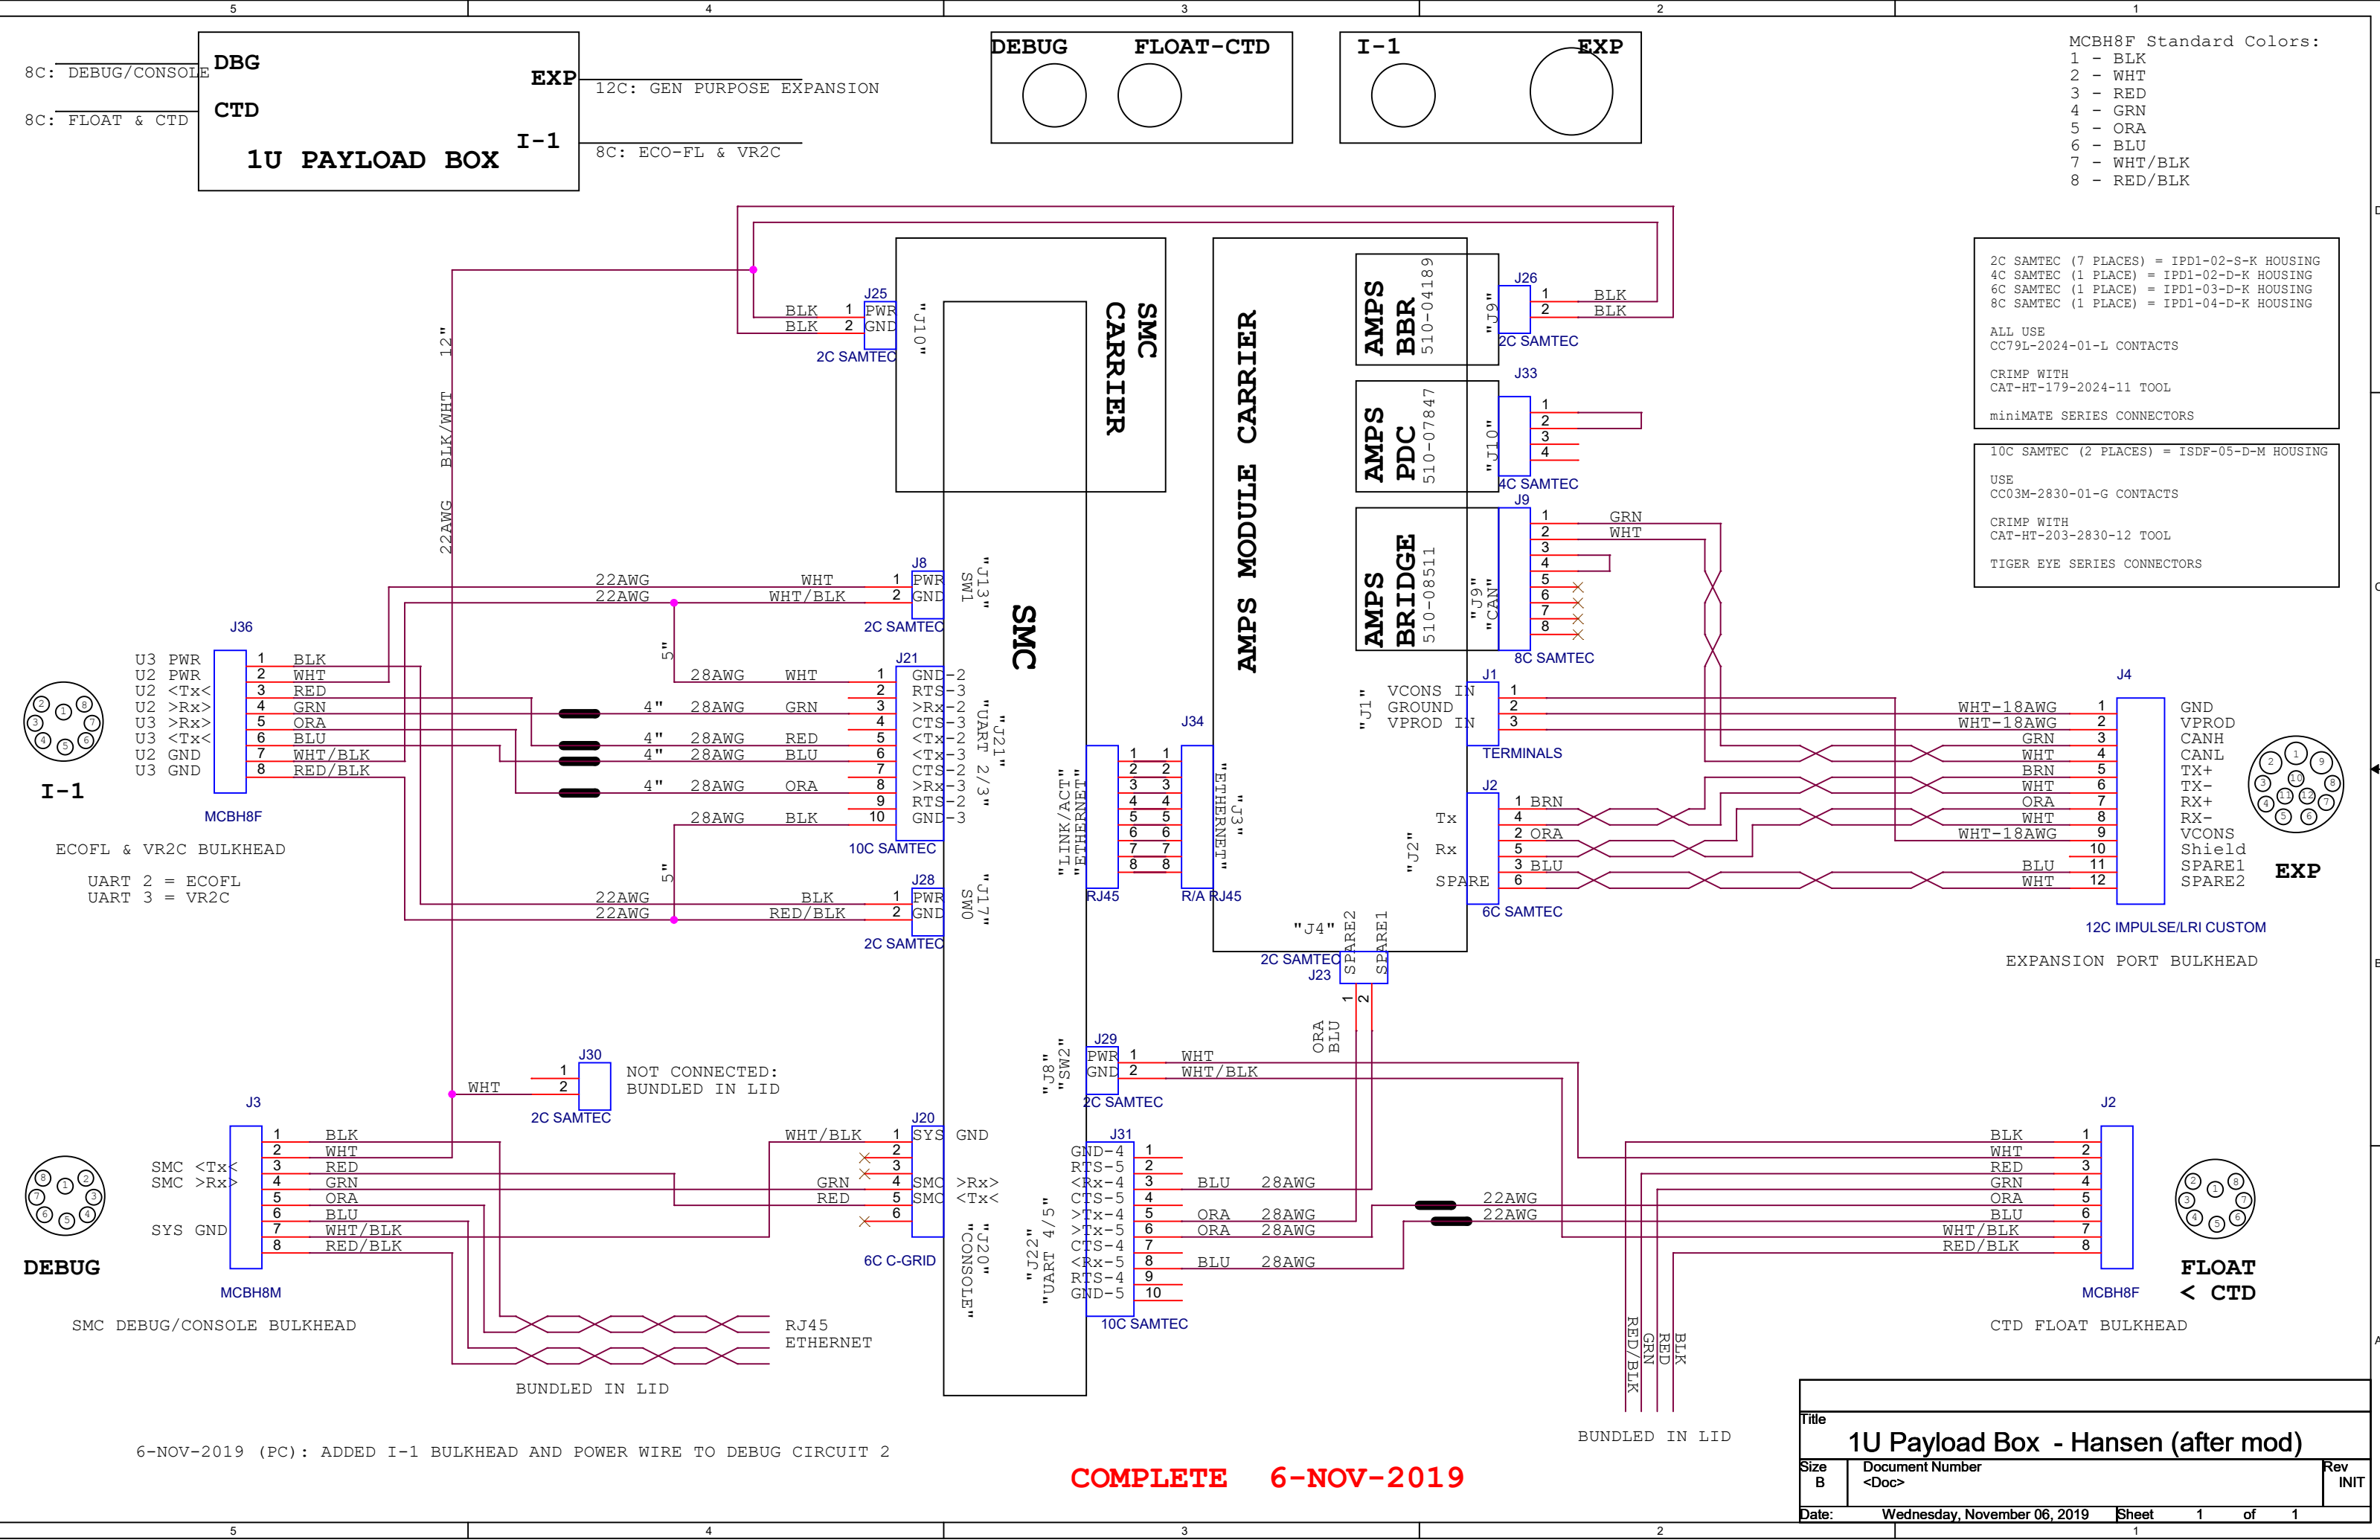

MCBH8F Standard Colors:
1 - BLK
2 - WHT
3 - RED
4 - GRN
5 - ORA
6 - BLU
7 - WHT/BLK
8 - RED/BLK

2C SAMTEC (7 PLACES) = IPD1-02-S-K HOUSING
4C SAMTEC (1 PLACE) = IPD1-02-D-K HOUSING
6C SAMTEC (1 PLACE) = IPD1-03-D-K HOUSING
8C SAMTEC (1 PLACE) = IPD1-04-D-K HOUSING

ALL USE
CC79L-2024-01-L CONTACTS

CRIMP WITH
CAT-HT-179-2024-11 TOOL

miniMATE SERIES CONNECTORS

10C SAMTEC (2 PLACES) = ISDF-05-D-M HOUSING

USE
CC03M-2830-01-G CONTACTS

CRIMP WITH
CAT-HT-203-2830-12 TOOL

TIGER EYE SERIES CONNECTORS

Title		
1U Payload Box - Hansen (after mod)		
Size B	Document Number <Doc>	Rev INIT
Date:	Wednesday, November 06, 2019	Sheet 1 of 1

COMPLETE 6-NOV-2019

6-NOV-2019 (PC): ADDED I-1 BULKHEAD AND POWER WIRE TO DEBUG CIRCUIT 2