



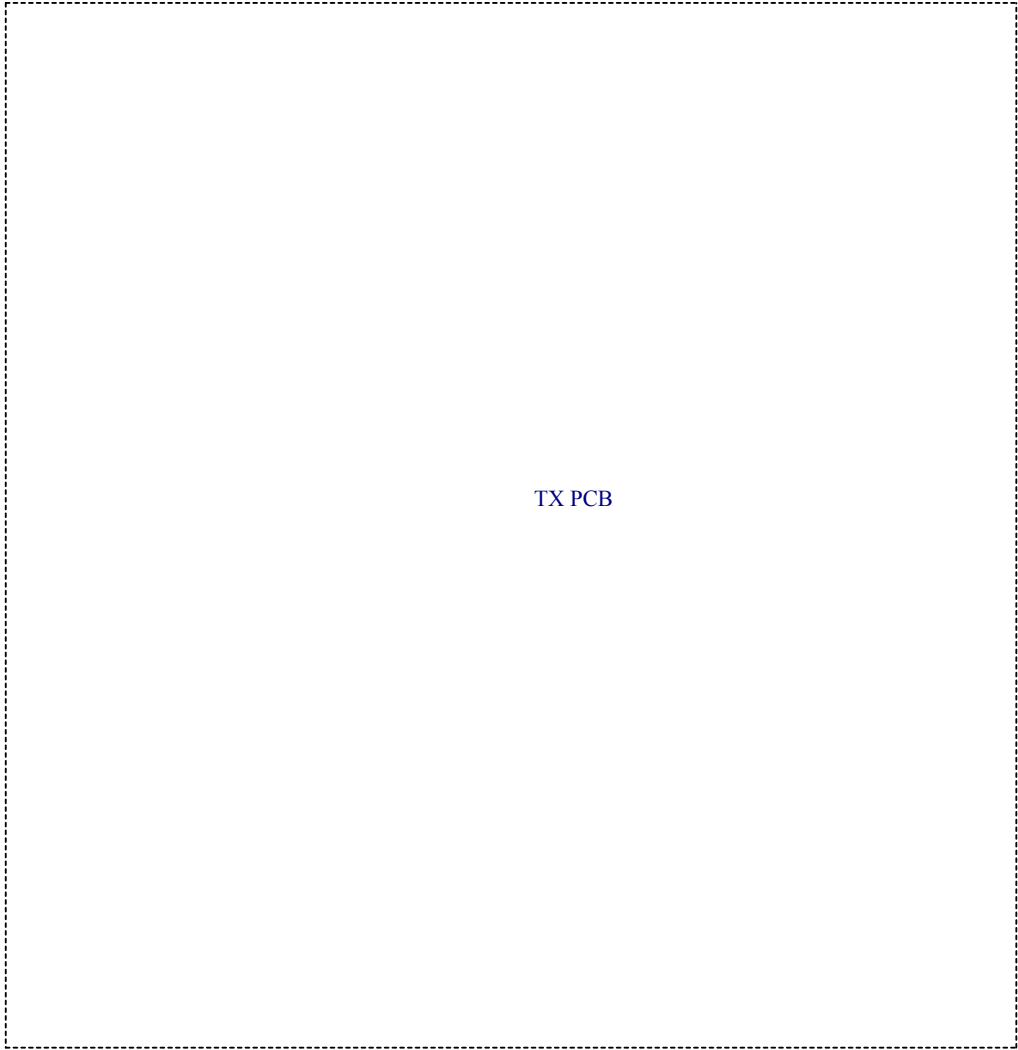
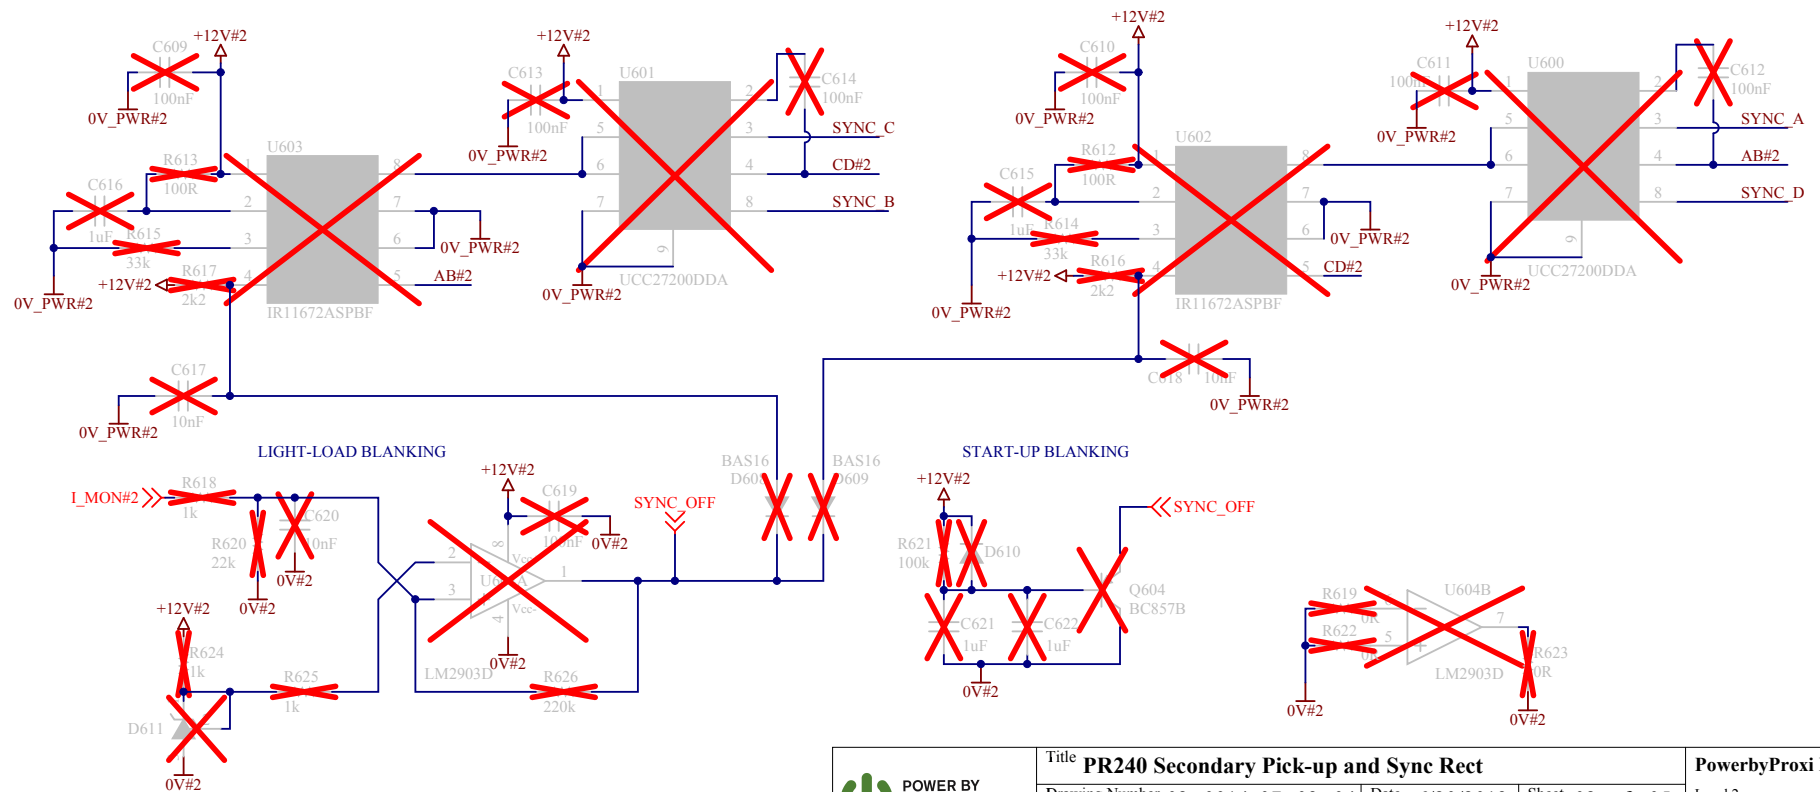
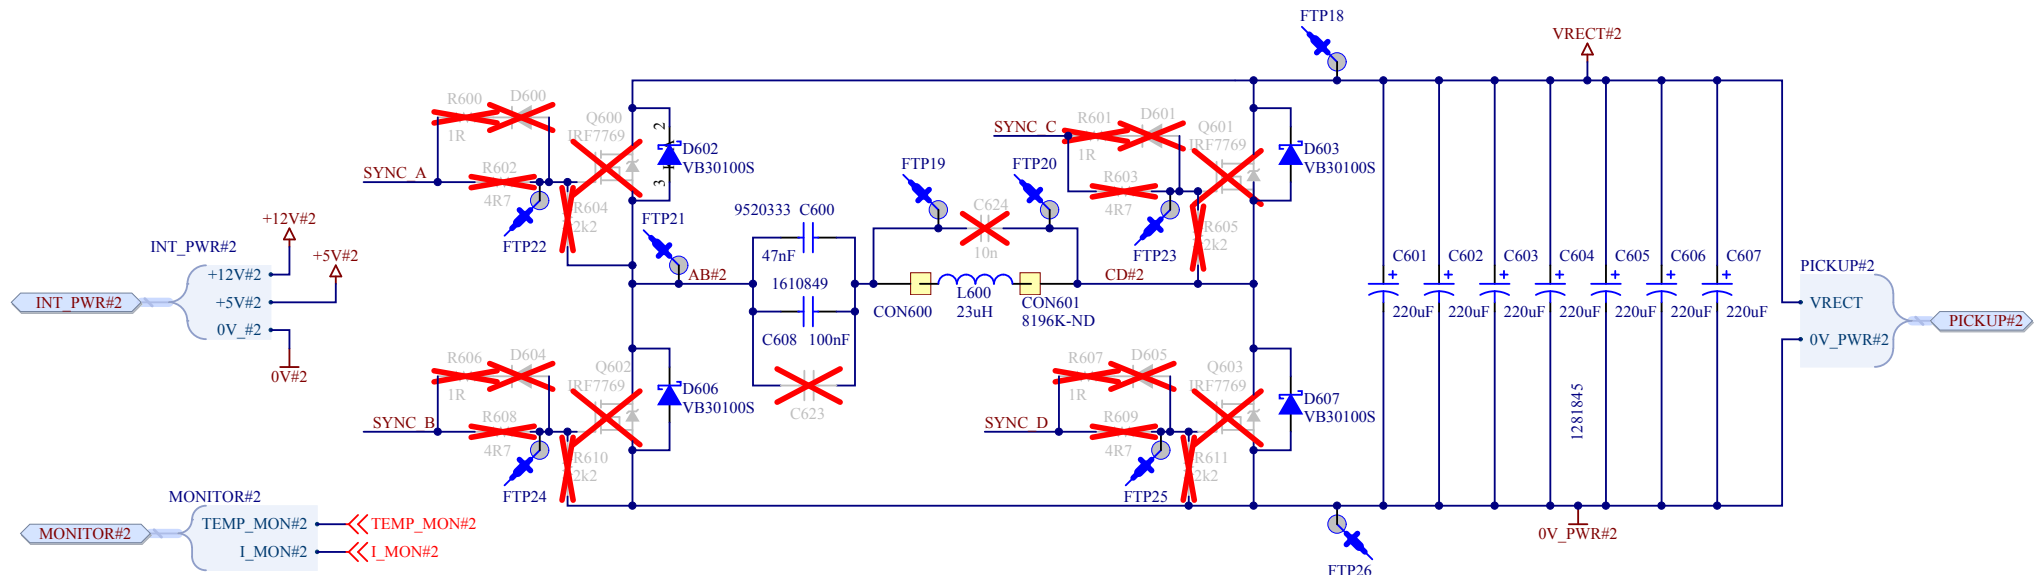
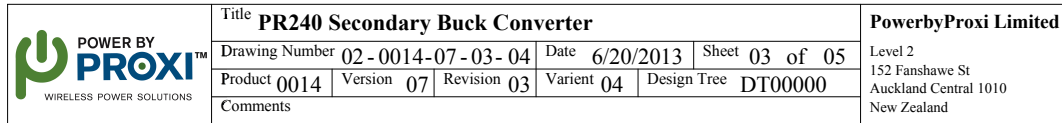


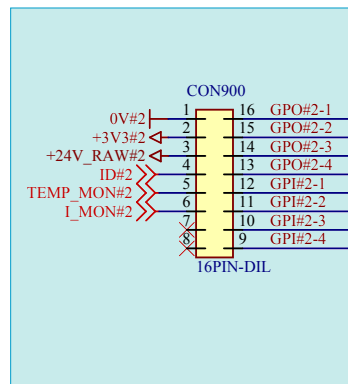








```
00 - All parts fitted
01 - *****
02 - *****
03 - *****
04 - All parts except Sync Rect (2013 Build)
```

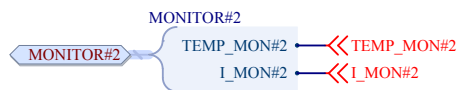

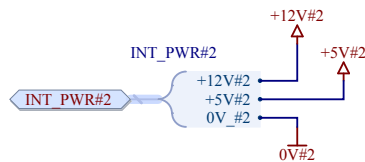

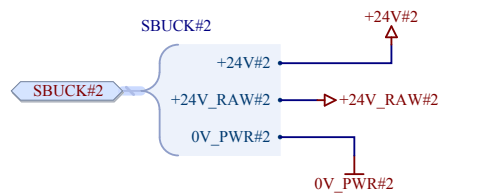

To Proxi-Com Bdr

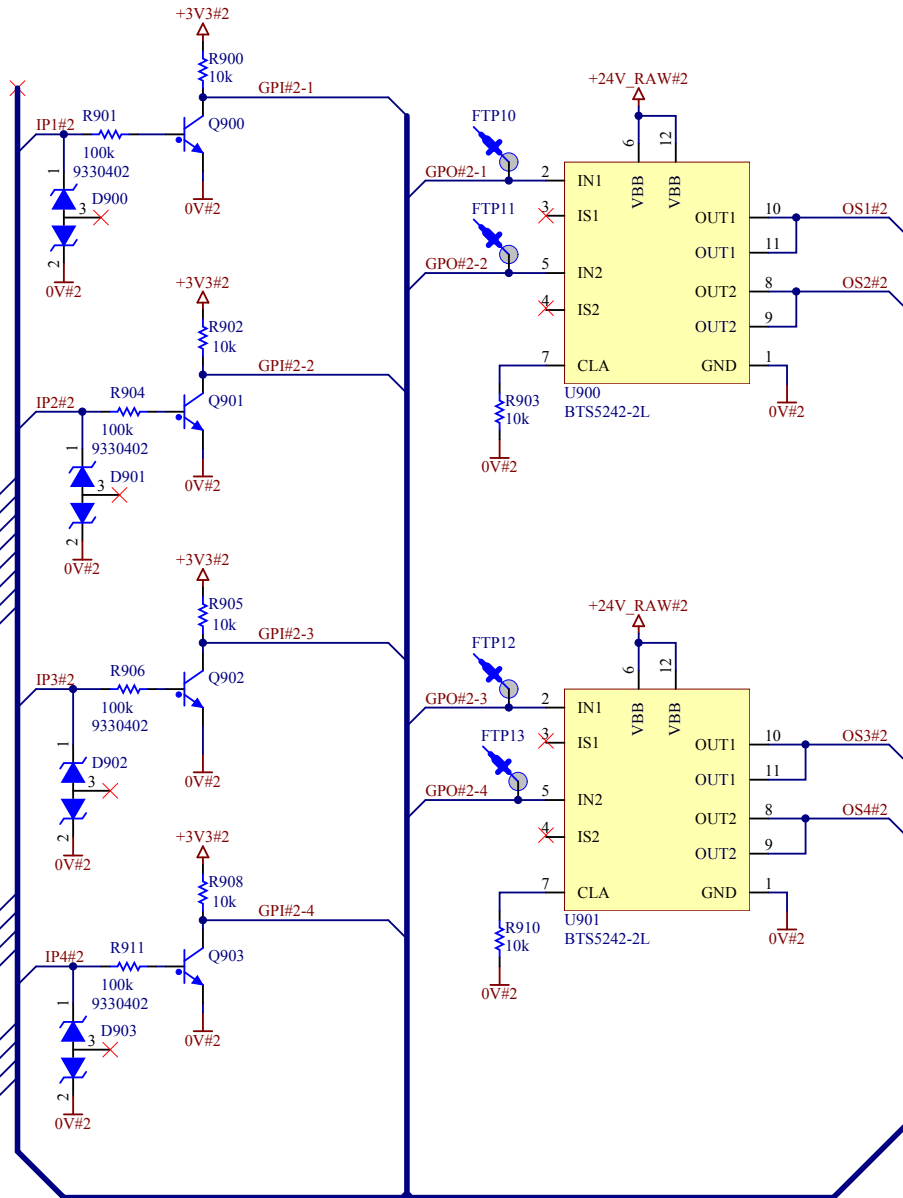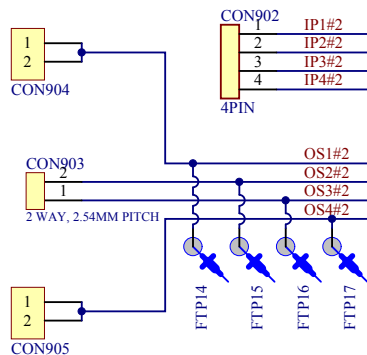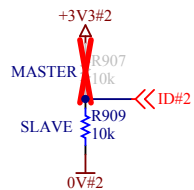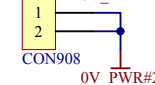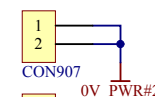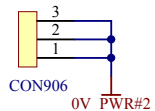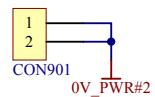

Title PR240 Secondary GPIO						
Drawing Number	02 - 0014-07 - 03 - 04		Date	6/20/2013	Sheet	04 of 05
Product	0014	Version	07	Revision	03	
				Variant	04	Design Tree
Comments				DT000000		

PowerbyProxi Limited
 Level 2
 152 Fanshawe St
 Auckland Central 1010
 New Zealand

