
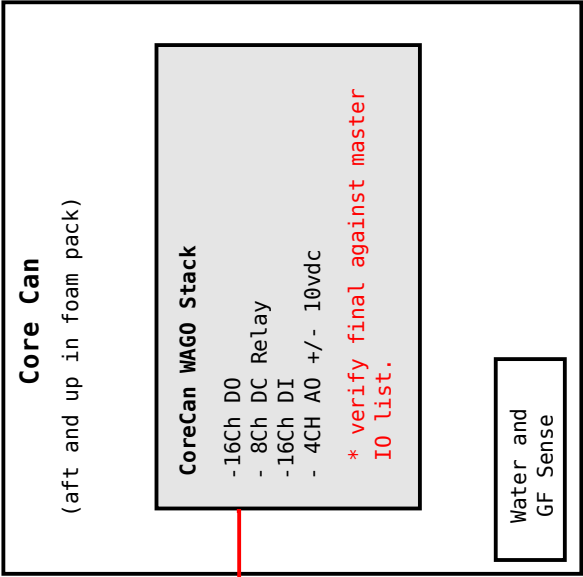
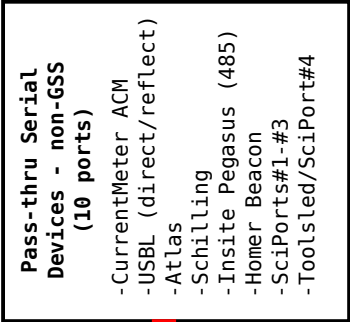
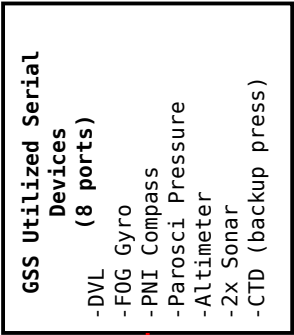
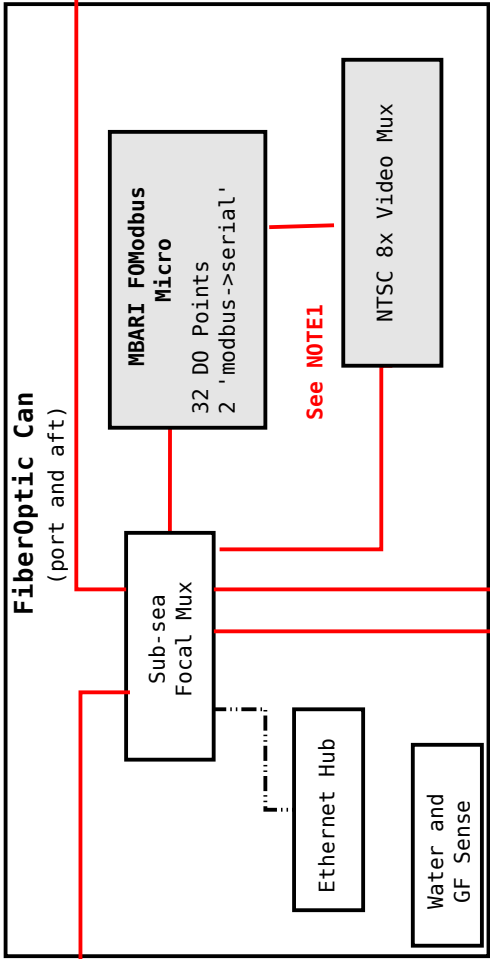
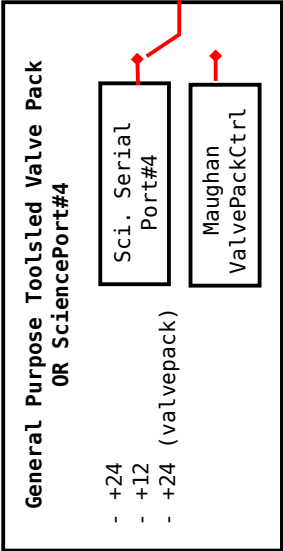
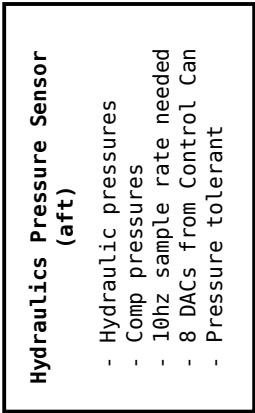
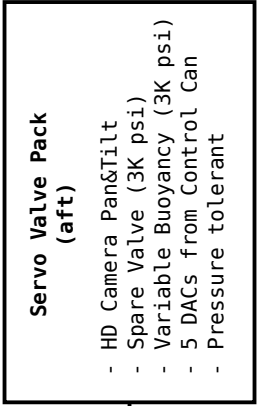
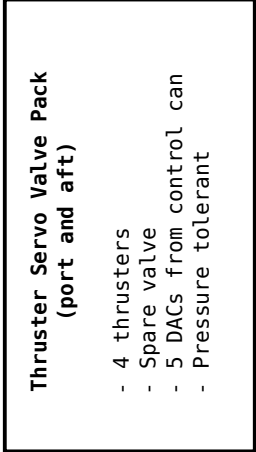
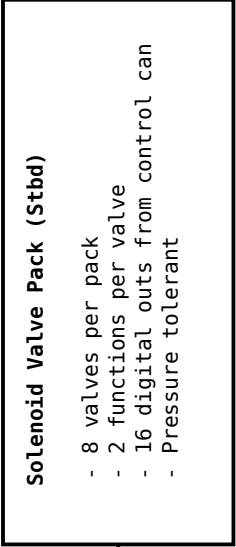
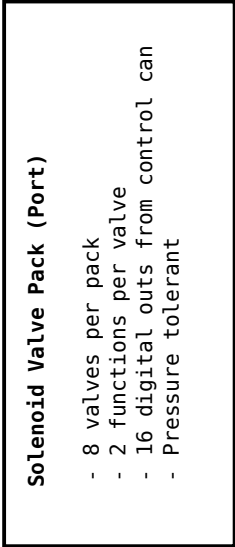
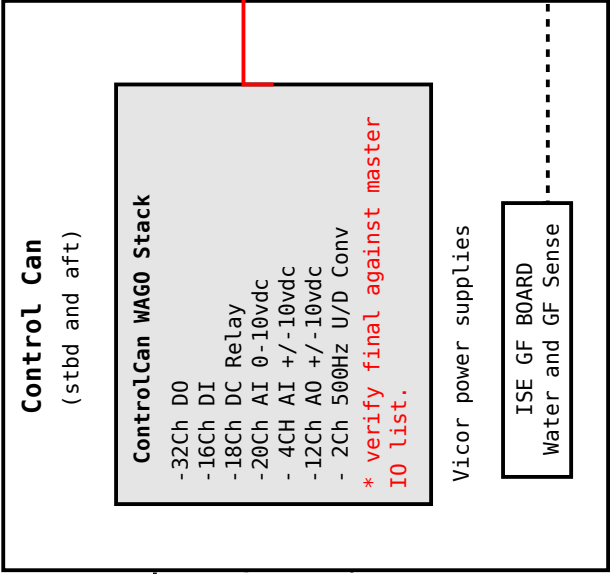


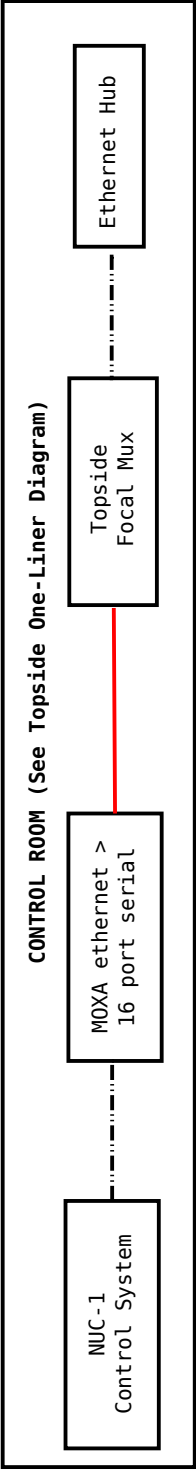

----- analog and digital signal wiring
— serial rs232 to focal
- - - - - ethernet

NOTE1:As discussed w/Ben K. prefer GSS implement the NTSC Video Switching via the FOModbusMicro's Modbus->Serial protocol to conserve one physical serial port on the FocalMux.

MBARI	7700 Sandholdt Rd Moss Landing, CA 95039		
Title	Ventana Bottomside Oneliner		
Document	VEN2014-15		
Filename	Bottomside_Oneliner_Rev5.dia		Rev 5
Date	10-Sep-2014	M.Risi/R.Schramm	

Capacity: Needed:
21 RS232 22
5 RS485
** Check This Count**

<--This serport is counted here ---->