



Fiber Penetrator
Positive Lens

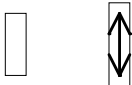

To ROV
High Power Port


MIN-K-10L

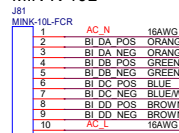

Verify Line & Neutral
from ROV connections

Add inline connector
for Ethernet lines




MIN-M-26

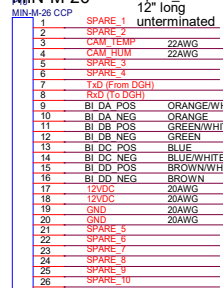

To Camera
Housing

Laserglow
LRS-0671-P10-01000-05
OEM 671nm Laser
DPSS Laser System
Output: >1000mW
12 VDC O.E.M.
PN: R6710B51X

\$5000 (include controller)

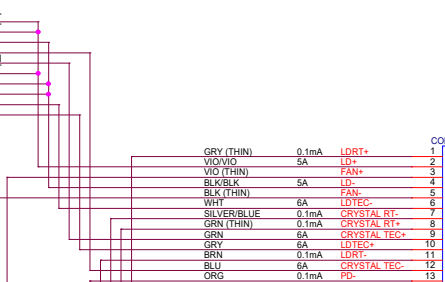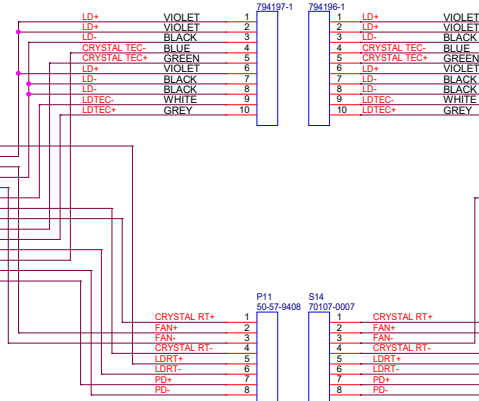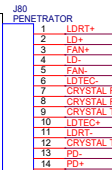




Laserglow
Controller
LRS-0671-P10-01000-05
S.N. 14070574
12 VDC O.E.M.

MBARI
AC/DC Module

Seawater Reference: Attach to Aluminum Baseplate

PORT 1 PORT 2
Digi
Port Server TS
Quad Serial Server

POWER
ETHERNET

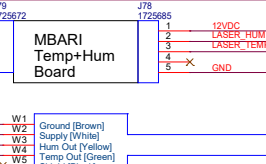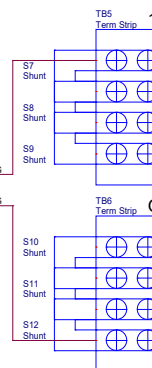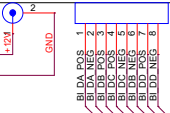

MOD6
HTM2500LF