


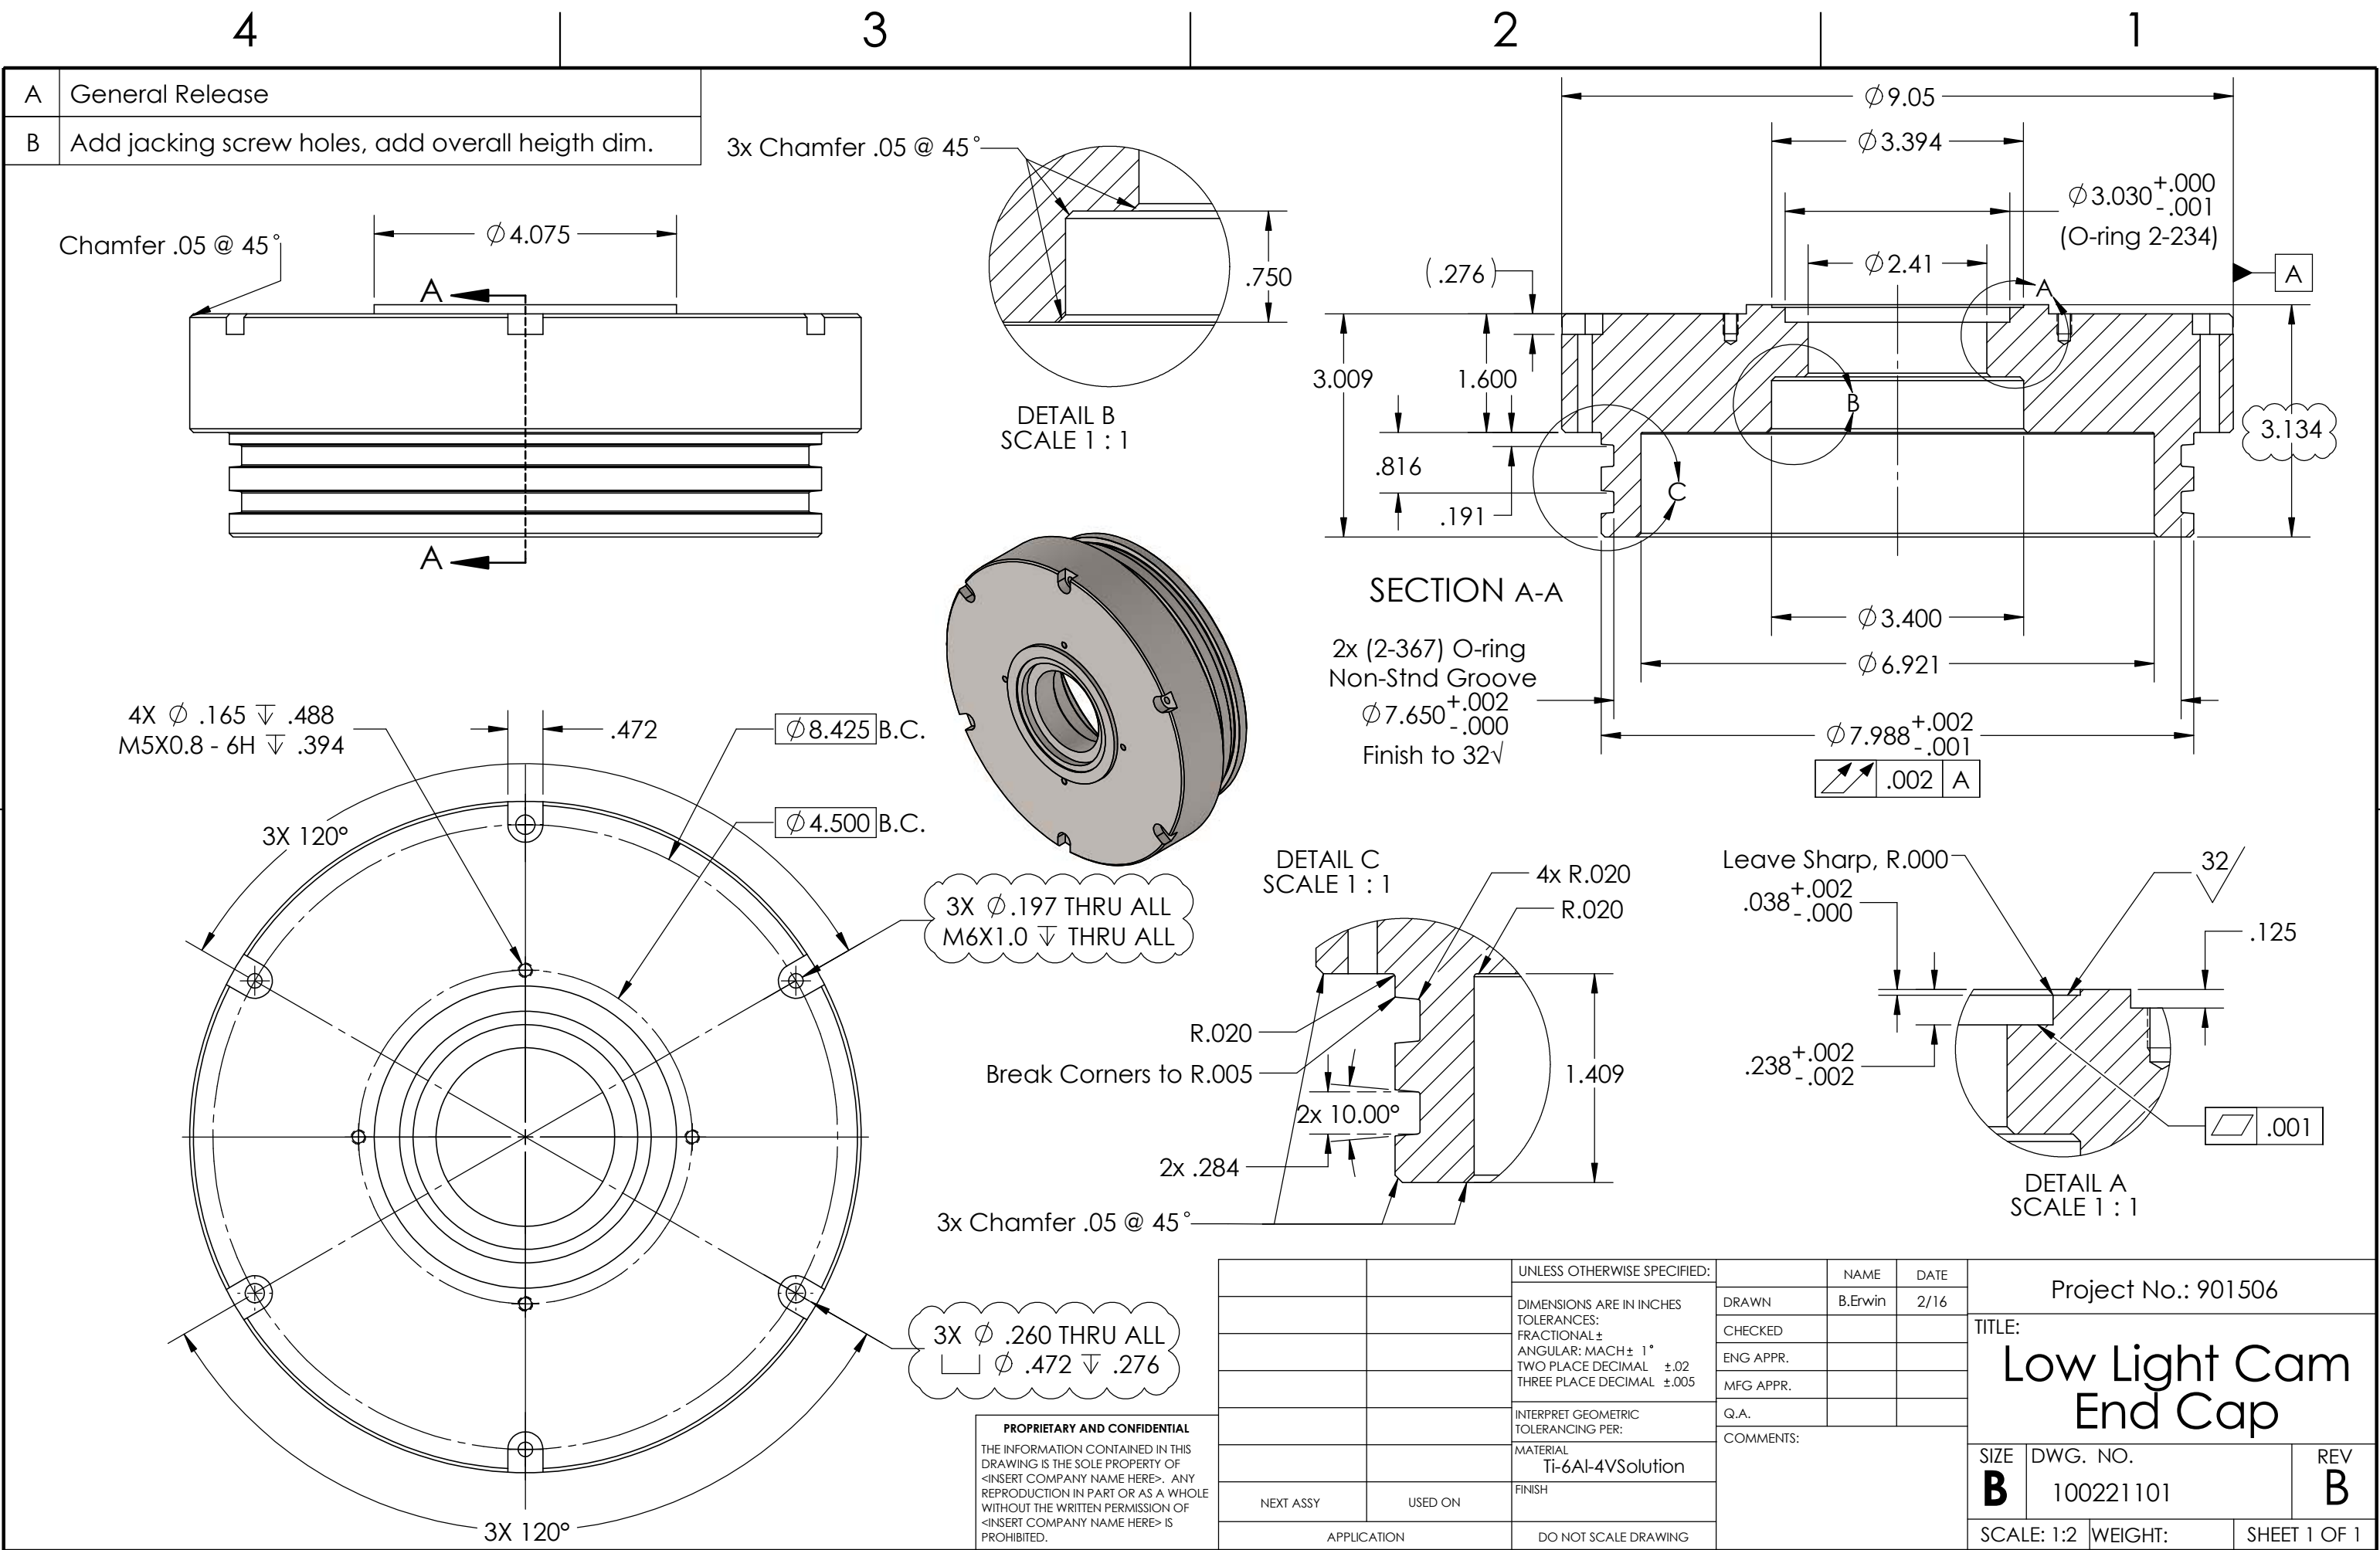

3x Chamfer .05 @ 45°

DETAIL B
SCALE 1 : 1

SECTION A-A

2x (2-367) O-ring
Non-Std Groove
 $\phi 7.650^{+.002}_{-.000}$
Finish to 32 $\sqrt{}$

DETAIL C
SCALE 1 : 1

DETAIL A
SCALE 1 : 1

PROPRIETARY AND CONFIDENTIAL
THE INFORMATION CONTAINED IN THIS
DRAWING IS THE SOLE PROPERTY OF
<INSERT COMPANY NAME HERE>. ANY
REPRODUCTION IN PART OR AS A WHOLE
WITHOUT THE WRITTEN PERMISSION OF
<INSERT COMPANY NAME HERE> IS
PROHIBITED.

UNLESS OTHERWISE SPECIFIED:

DIMENSIONS ARE IN INCHES
TOLERANCES:
FRACTIONAL $\pm$
ANGULAR: MACH $\pm$ 1°
TWO PLACE DECIMAL $\pm$.02
THREE PLACE DECIMAL $\pm$.005

INTERPRET GEOMETRIC
TOLERANCING PER:

MATERIAL
Ti-6Al-4V Solution

FINISH

NAME

DATE

DRAWN

CHECKED

ENG APPR.

MFG APPR.

Q.A.

COMMENTS:

Project No.: 901506

TITLE:
**Low Light Cam
End Cap**

SIZE
B

DWG. NO.
100221101

REV
B

SCALE: 1:2

WEIGHT:

SHEET 1 OF 1