

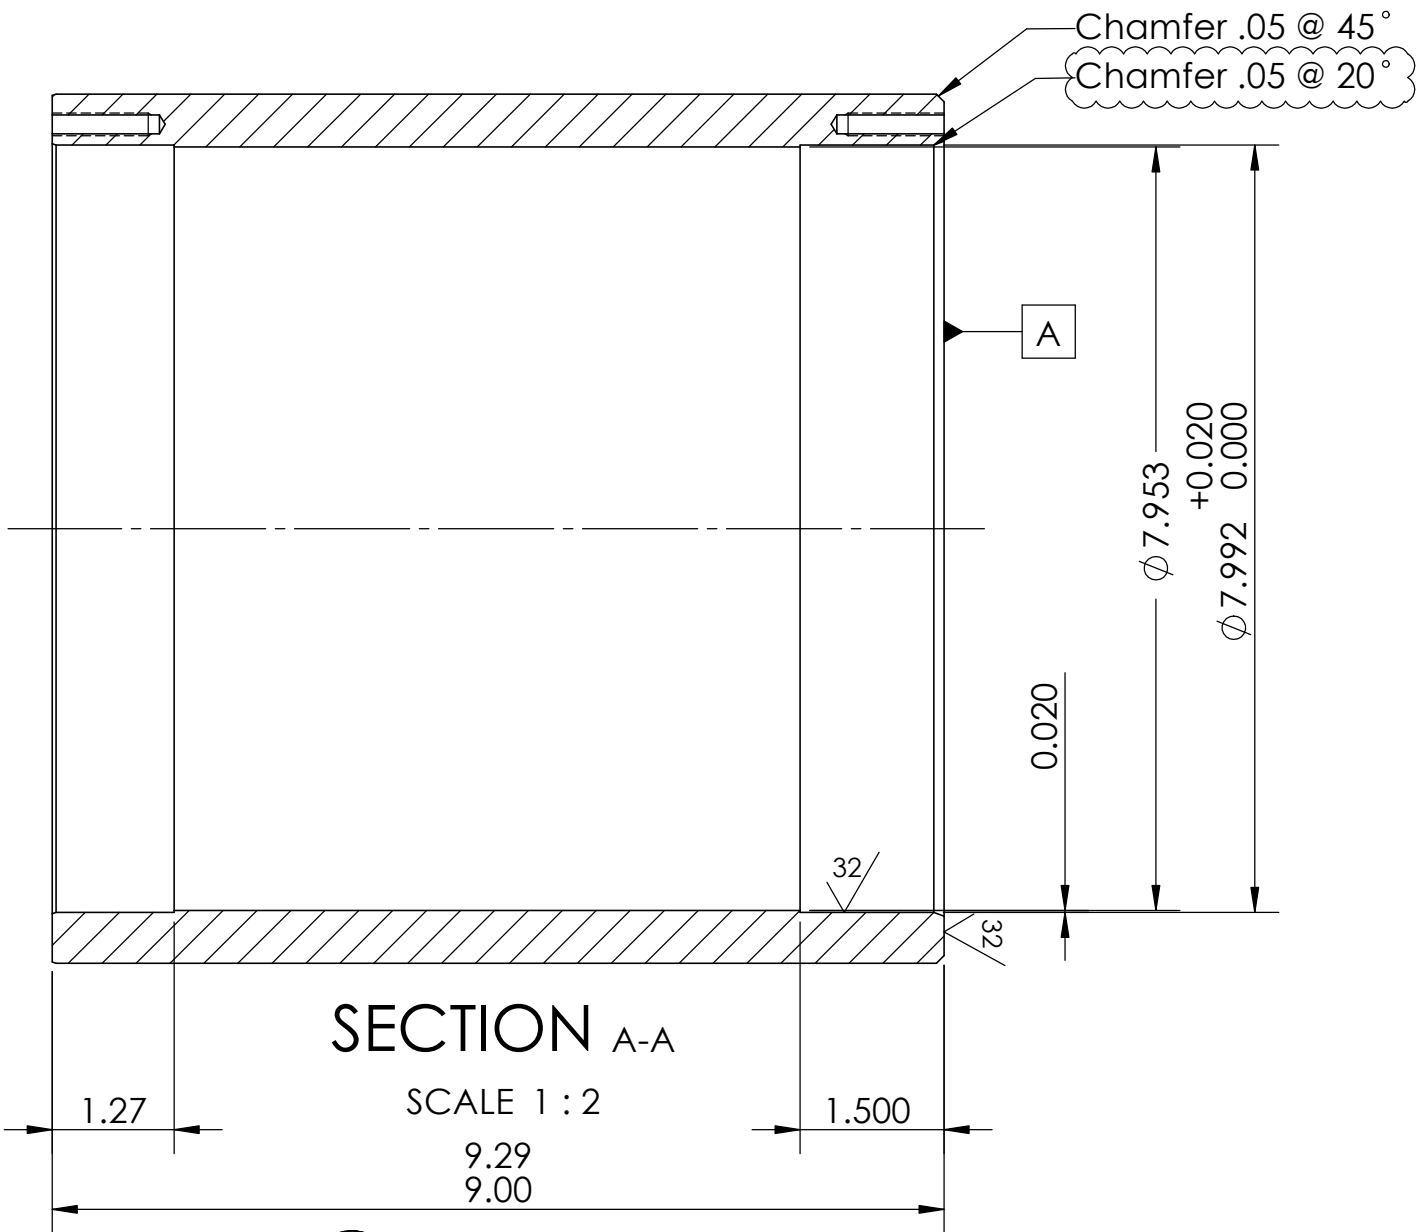


A	Original Release	3/10/16
B	Changed Chamfer of ID lip to 20°	3/11/16

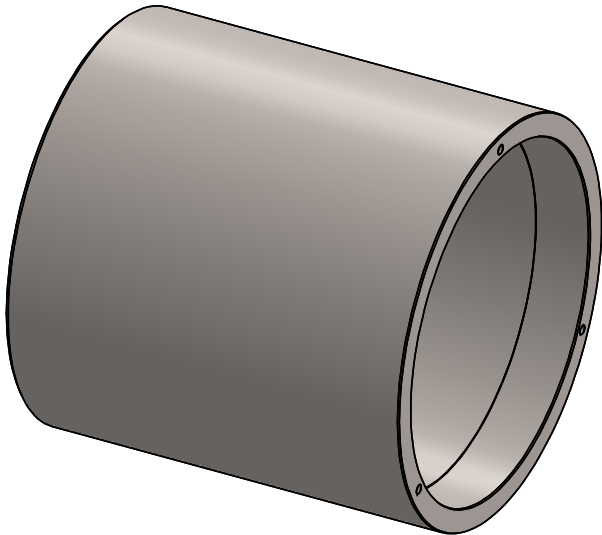

3X $\phi .20 \nabla 1.12$
M6X1.0 - 6H $\nabla 1.00$

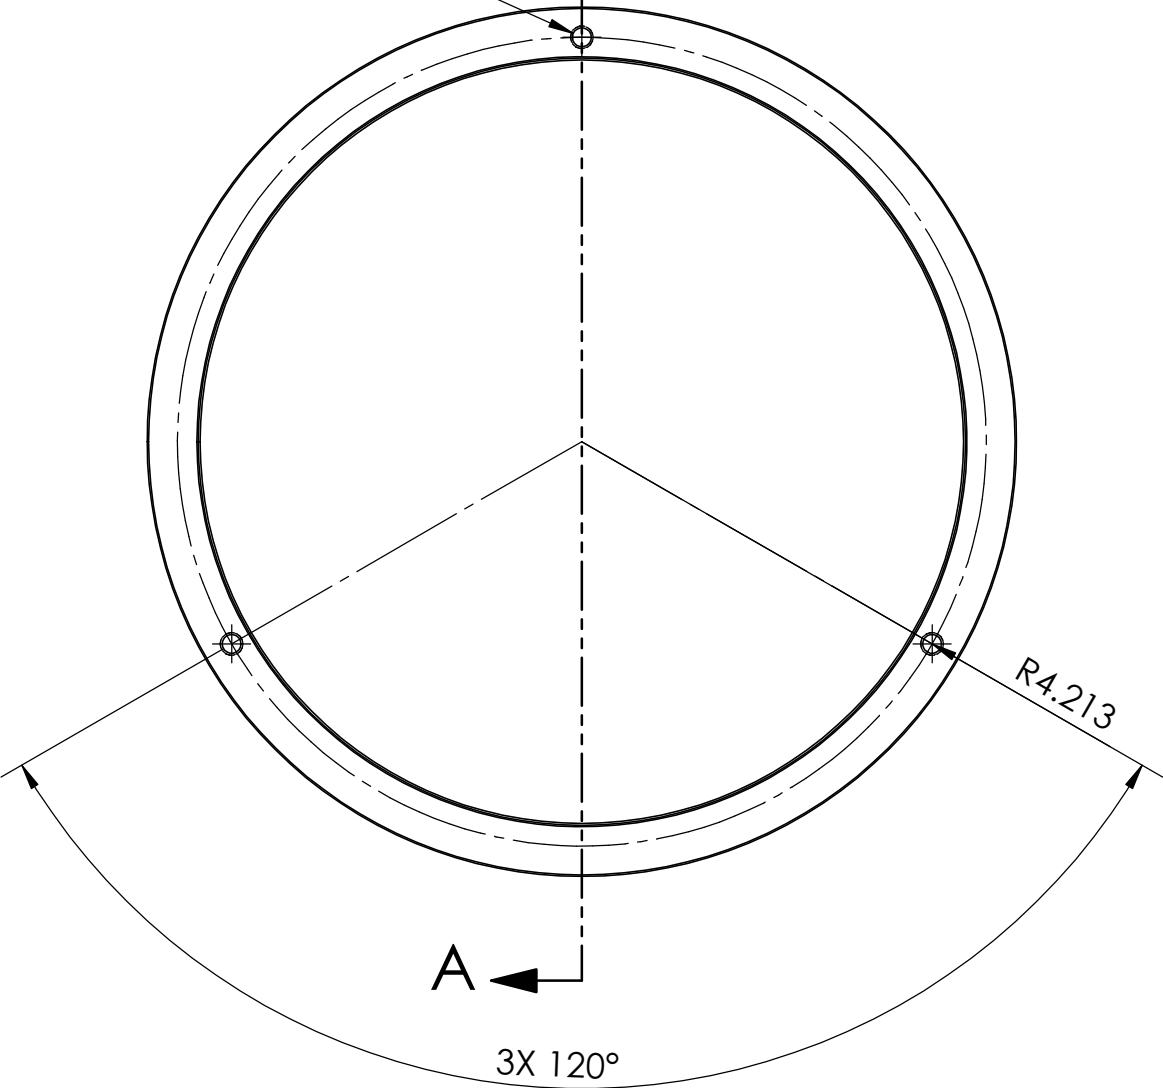

PROPRIETARY AND CONFIDENTIAL
THE INFORMATION CONTAINED IN THIS DRAWING IS THE SOLE PROPERTY OF <INSERT COMPANY NAME HERE>. ANY REPRODUCTION IN PART OR AS A WHOLE WITHOUT THE WRITTEN PERMISSION OF <INSERT COMPANY NAME HERE> IS PROHIBITED.

		UNLESS OTHERWISE SPECIFIED:		NAME	DATE	TITLE: Low Light Camera Housing (DeepPIV)	
		DIMENSIONS ARE IN INCHES	DRAWN	Ben E.			
		TOLERANCES:	CHECKED				
		FRACTIONAL $\pm$	ENG APPR.				
		ANGULAR: MACH $\pm$ BEND $\pm$	MFG APPR.				
		TWO PLACE DECIMAL $\pm .02$	Q.A.			SIZE B	DWG. NO. 100221120
		THREE PLACE DECIMAL $\pm .005$	COMMENTS:			REV B	
		INTERPRET GEOMETRIC TOLERANCING PER:				SCALE: 1:4	WEIGHT:
		MATERIAL					SHEET 1 OF 1
NEXT ASSY	USED ON	FINISH					
APPLICATION		DO NOT SCALE DRAWING					