


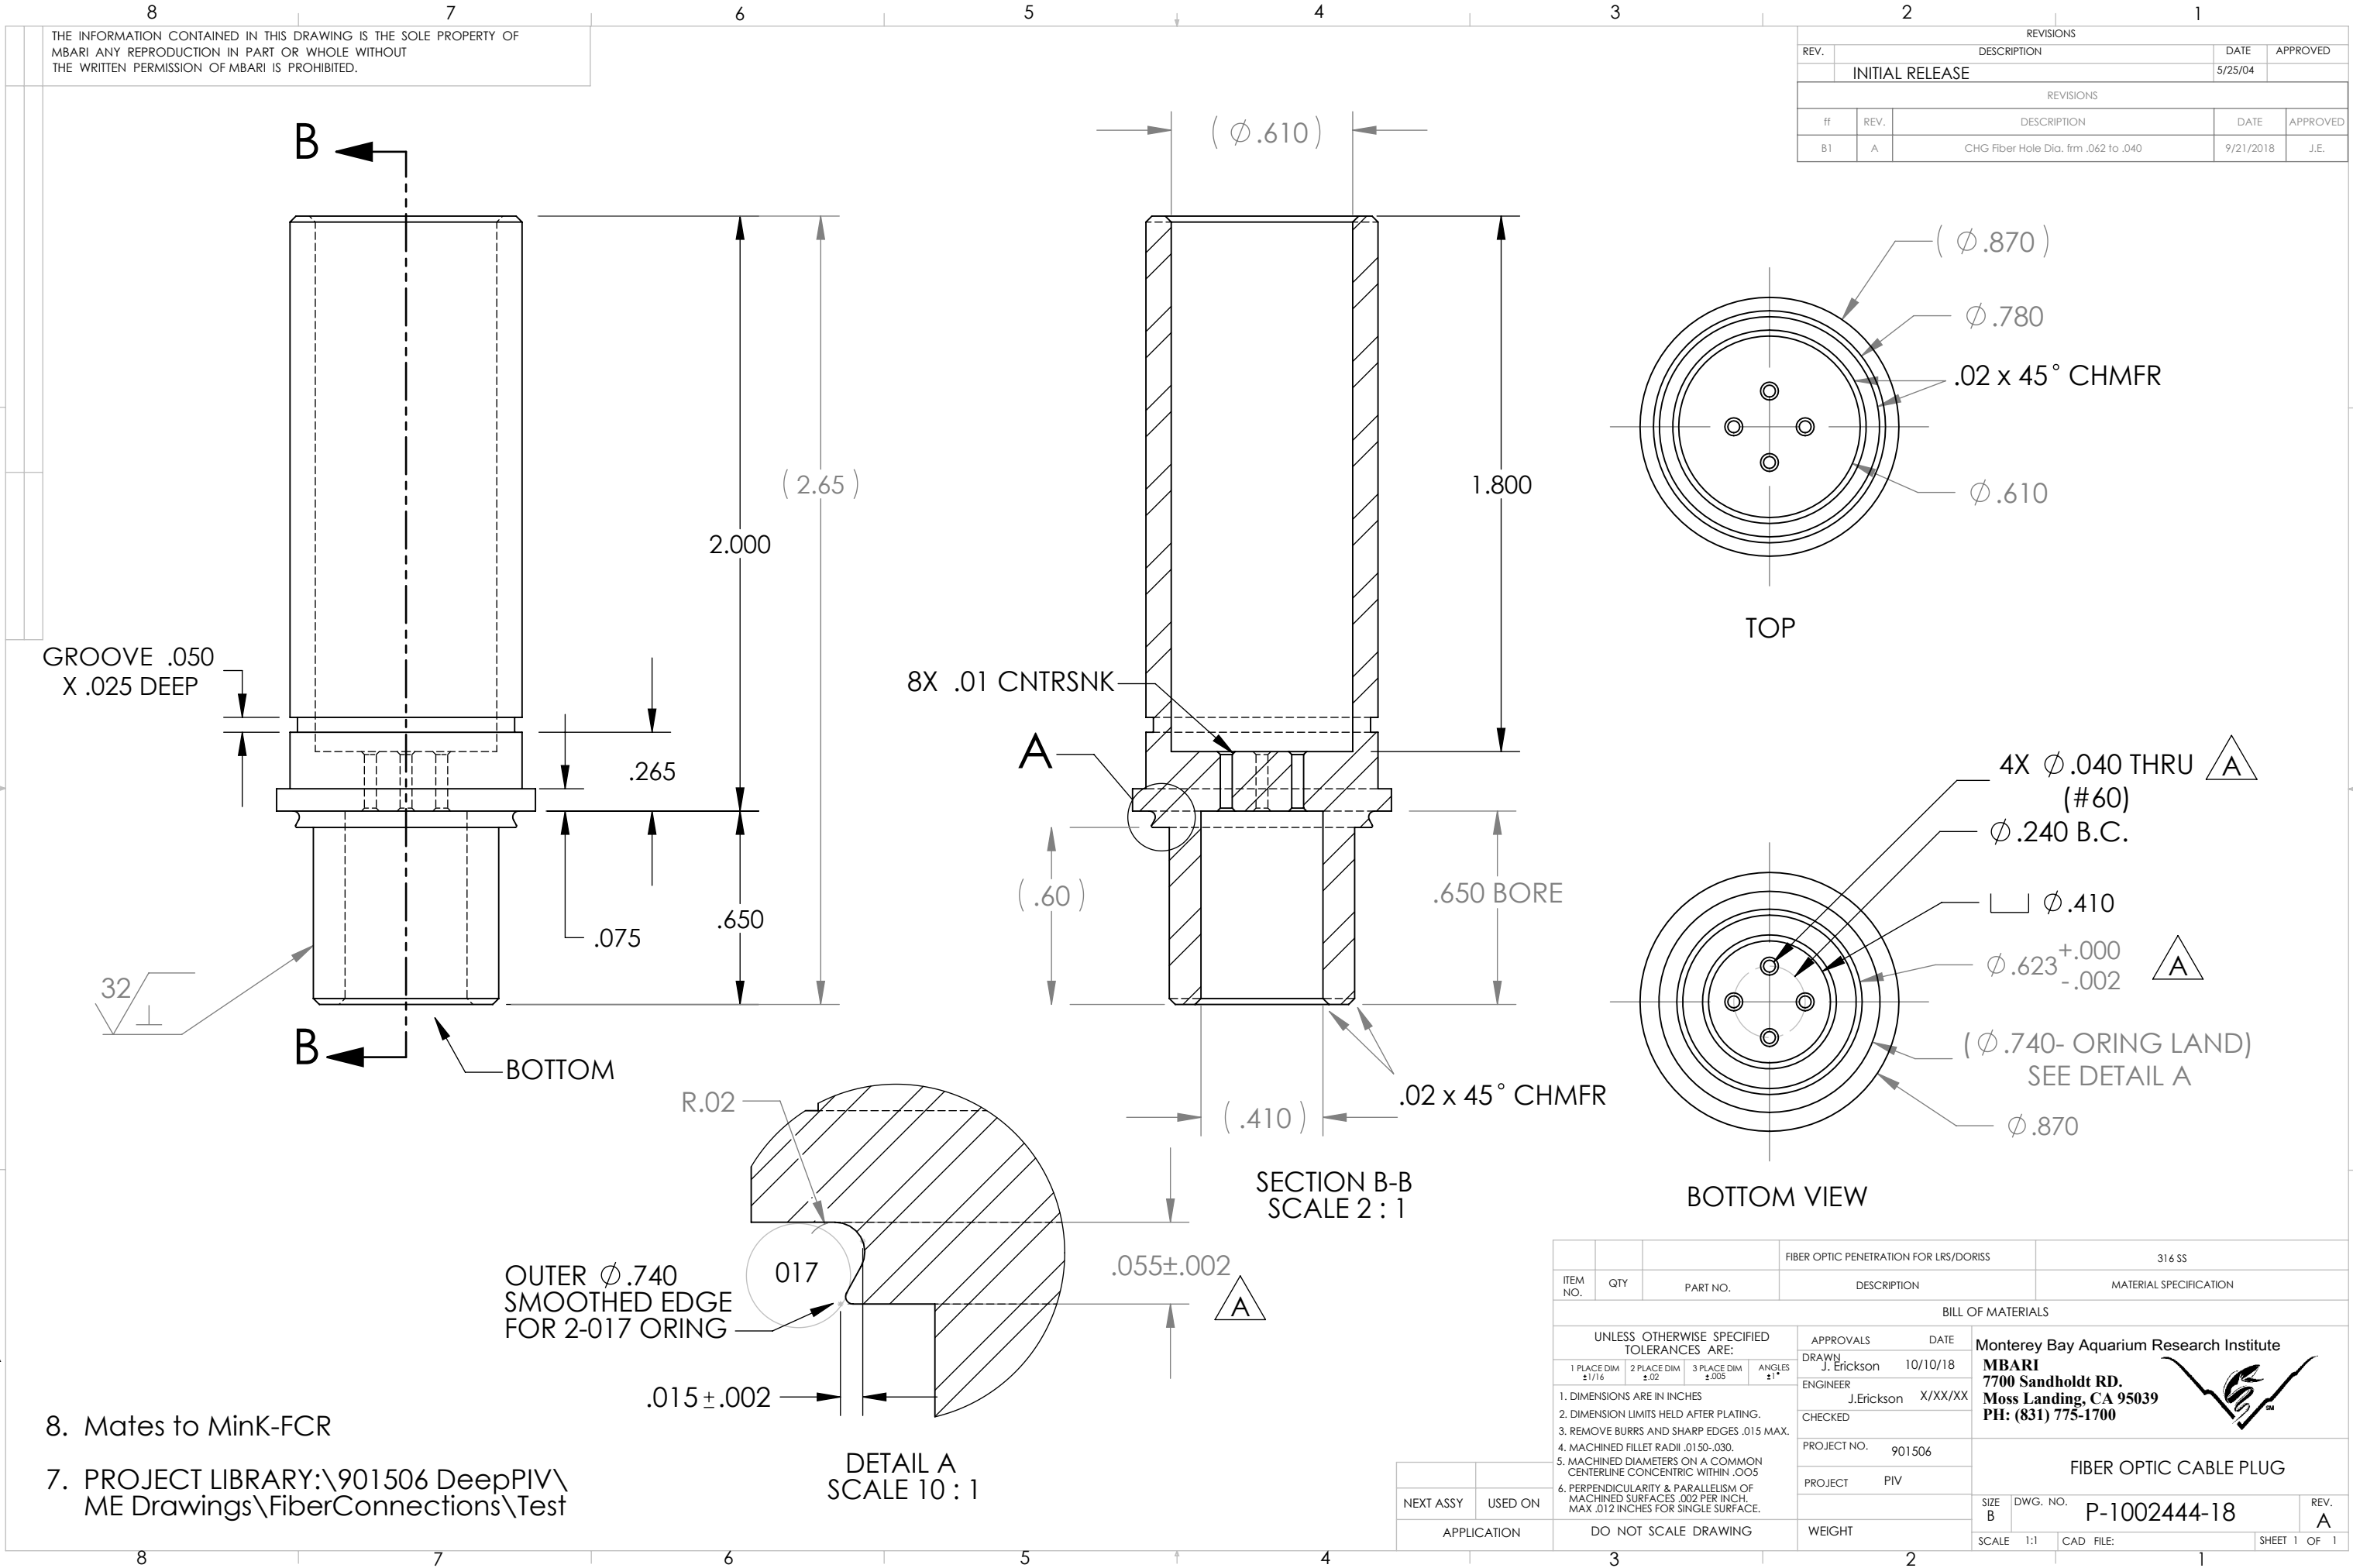

8. Mates to MinK-FCR

7. PROJECT LIBRARY:\901506 DeepPIV\ME Drawings\FiberConnections\Test