



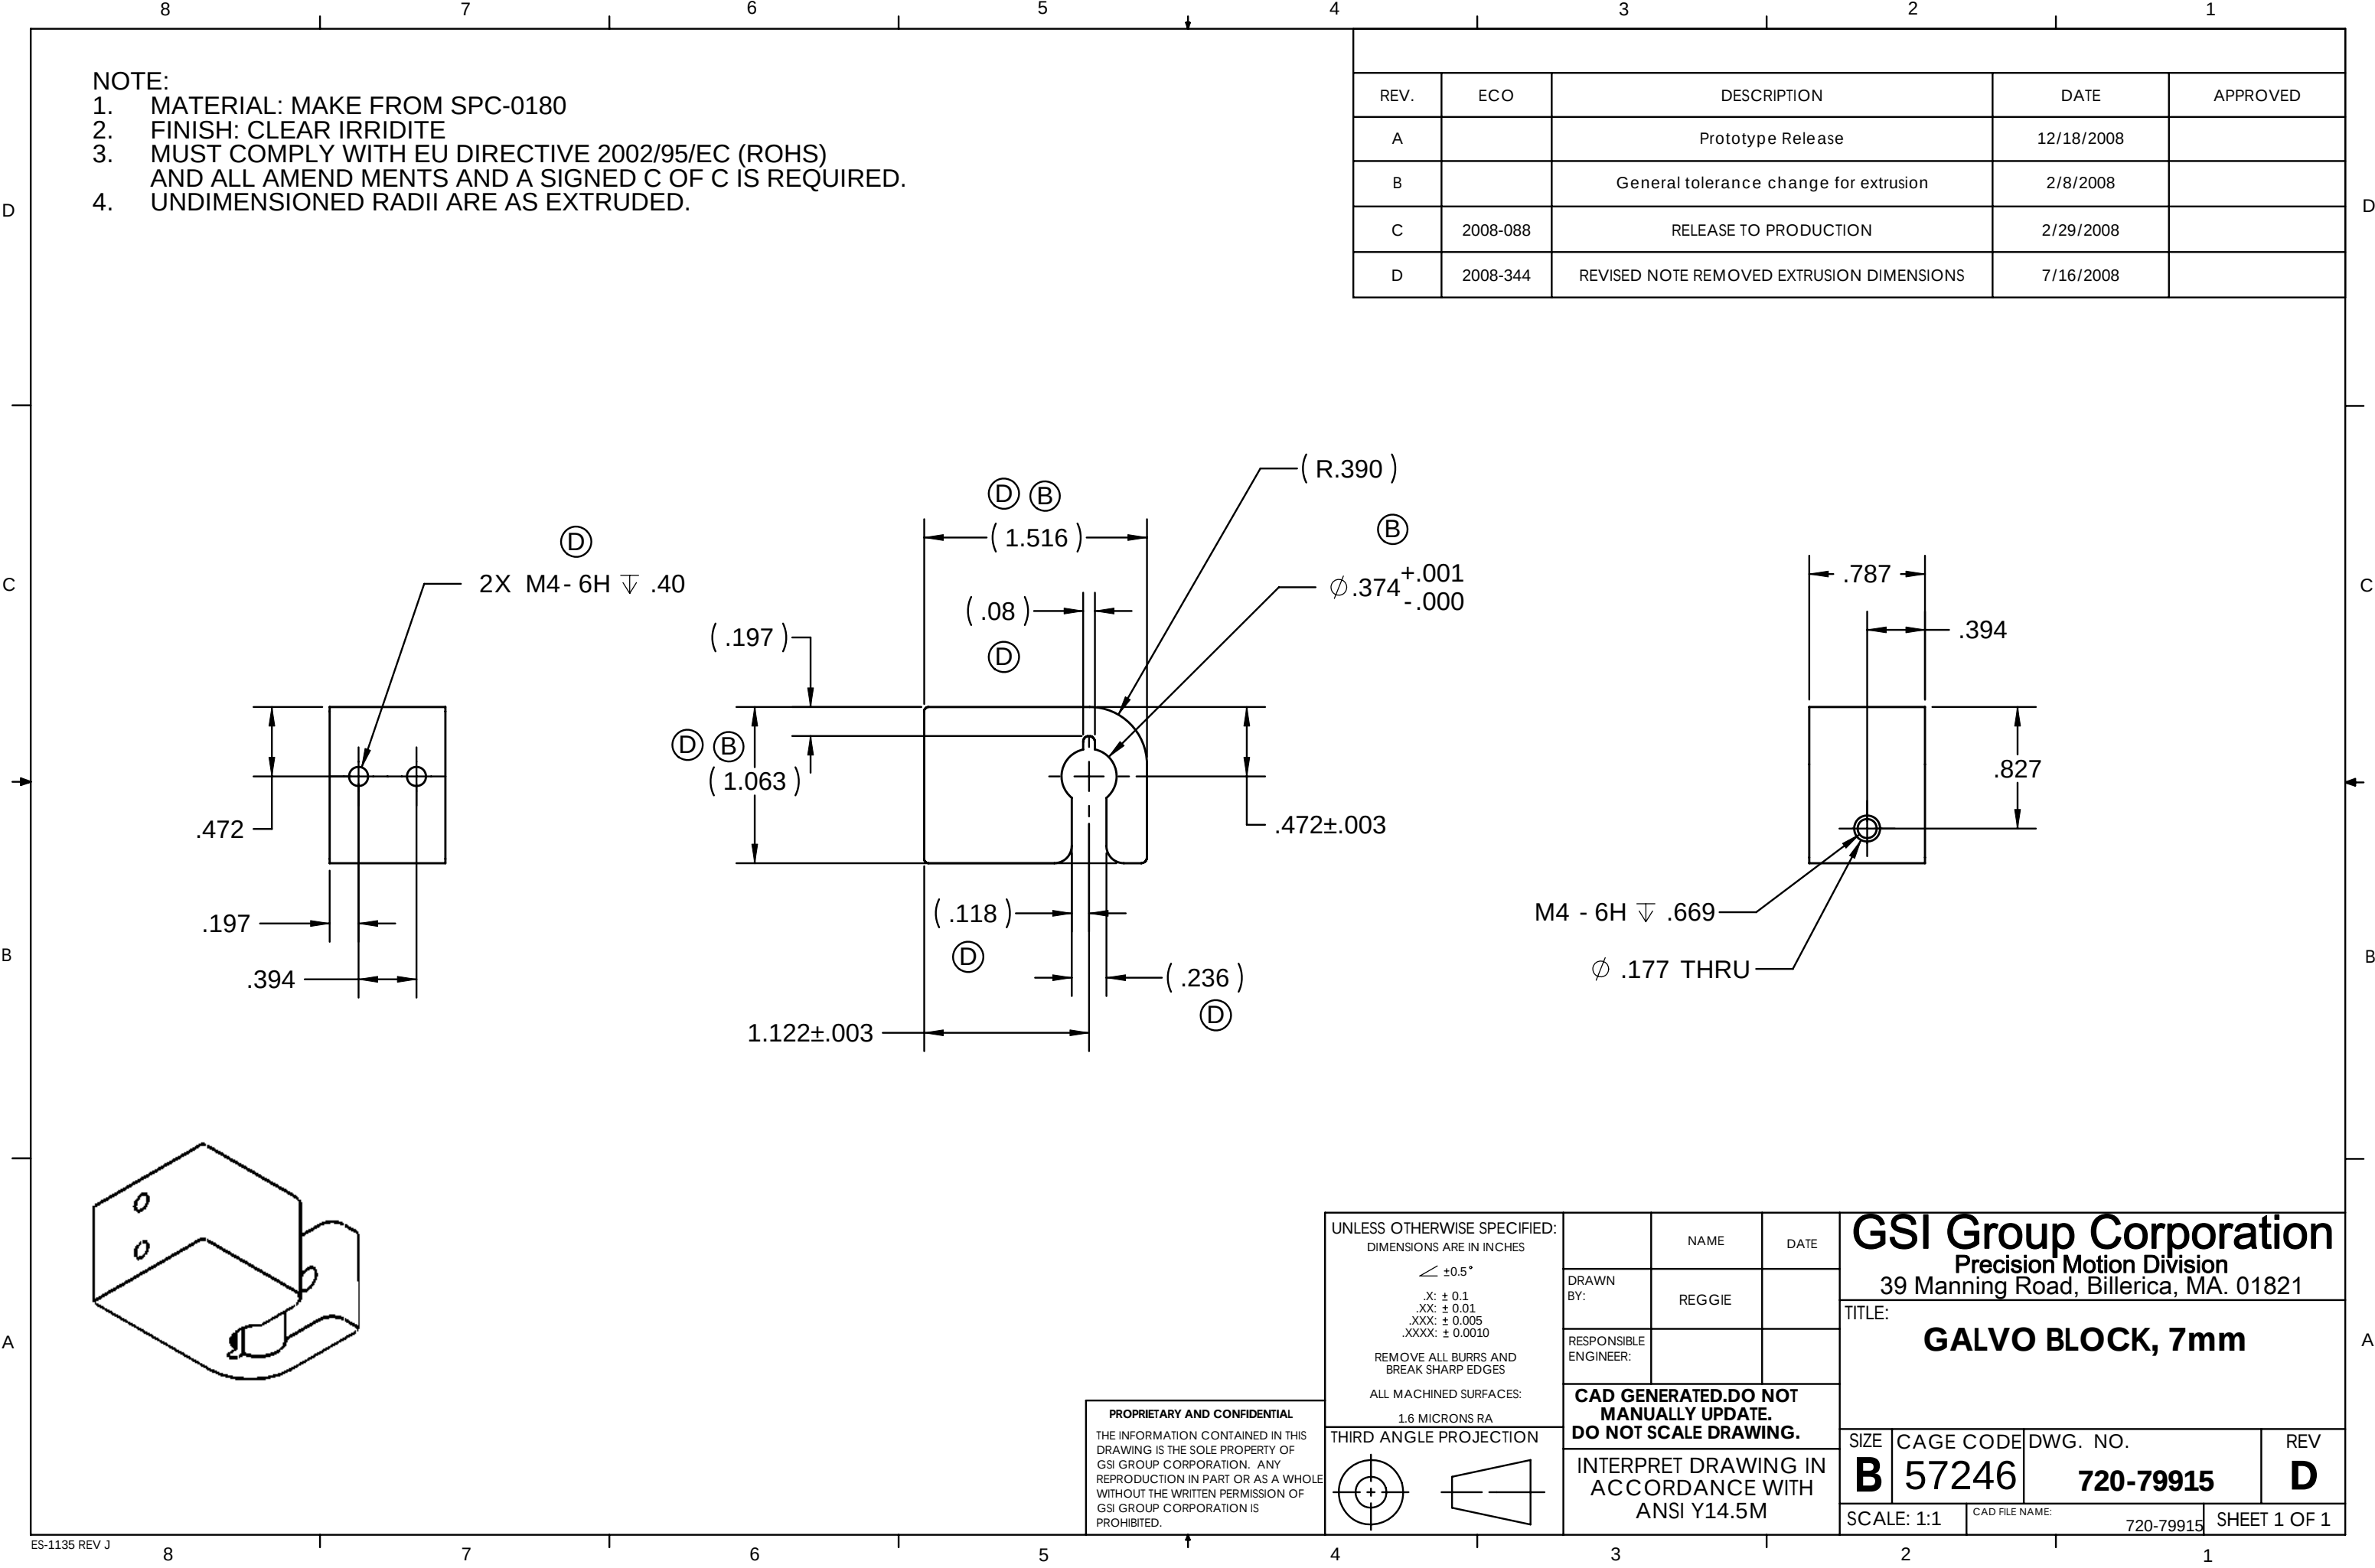

NOTE:
1. MATERIAL: MAKE FROM SPC-0180
2. FINISH: CLEAR IRRIDITE
3. MUST COMPLY WITH EU DIRECTIVE 2002/95/EC (ROHS)
AND ALL AMEND MENTS AND A SIGNED C OF C IS REQUIRED.
4. UNDIMENSIONED RADII ARE AS EXTRUDED.


REV.	ECO	DESCRIPTION	DATE	APPROVED
A		Prototype Release	12/18/2008	
B		General tolerance change for extrusion	2/8/2008	
C	2008-088	RELEASE TO PRODUCTION	2/29/2008	
D	2008-344	REVISED NOTE REMOVED EXTRUSION DIMENSIONS	7/16/2008	

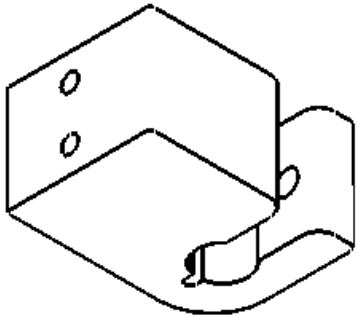

PROPRIETARY AND CONFIDENTIAL
THE INFORMATION CONTAINED IN THIS
DRAWING IS THE SOLE PROPERTY OF
GSI GROUP CORPORATION. ANY
REPRODUCTION IN PART OR AS A WHOLE
WITHOUT THE WRITTEN PERMISSION OF
GSI GROUP CORPORATION IS
PROHIBITED.

UNLESS OTHERWISE SPECIFIED:
DIMENSIONS ARE IN INCHES
 $\angle \pm 0.5^\circ$
.X: ± 0.1
.XX: ± 0.01
.XXX: ± 0.005
.XXXX: ± 0.0010
REMOVE ALL BURRS AND
BREAK SHARP EDGES
ALL MACHINED SURFACES:
1.6 MICRONS RA

THIRD ANGLE PROJECTION

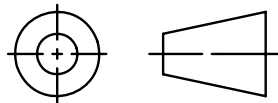

	NAME	DATE
DRAWN BY:	REGGIE	
RESPONSIBLE ENGINEER:		
CAD GENERATED.DO NOT MANUALLY UPDATE. DO NOT SCALE DRAWING.		
INTERPRET DRAWING IN ACCORDANCE WITH ANSI Y14.5M		

GSI Group Corporation Precision Motion Division 39 Manning Road, Billerica, MA. 01821			
TITLE: GALVO BLOCK, 7mm			
SIZE	CAGE CODE	DWG. NO.	REV
B	57246	720-79915	D
SCALE: 1:1		CAD FILE NAME: 720-79915	SHEET 1 OF 1