

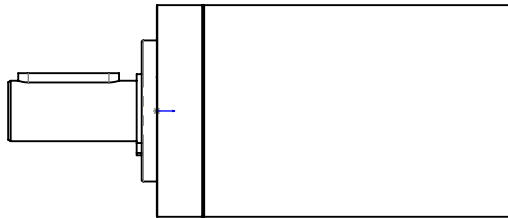
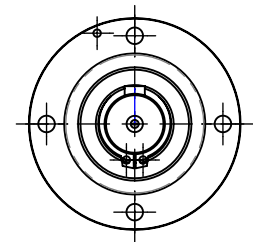


THE INFORMATION CONTAINED IN THIS DRAWING IS THE SOLE PROPERTY OF MBARI ANY REPRODUCTION IN PART OR WHOLE WITHOUT THE WRITTEN PERMISSION OF MBARI IS PROHIBITED.

		REVISIONS		
ZONE	REV.	DESCRIPTION	DATE	APPROVED
		INITIAL RELEASE	XX/XX/02	J.E.

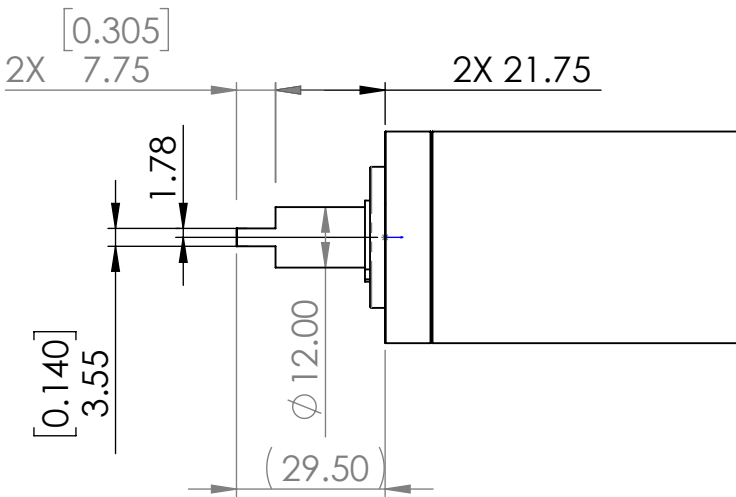

STOCK

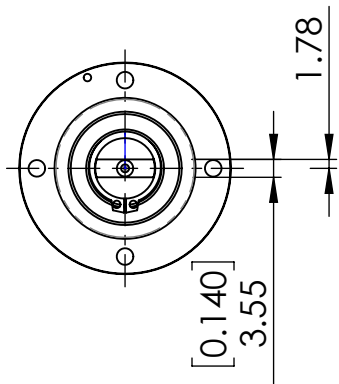

MODIFIED

PART MODIFICATION DRAWING

		DIMENSIONS ARE IN INCHES TOLERANCES: FRACTIONAL ± ANGULAR: MACH ± BEND ± TWO PLACE DECIMAL ± THREE PLACE DECIMAL ±	APPROVALS		DATE	Monterey Bay Aquarium Research Institute MBARI 7700 Sandholdt RD. Moss Landing, CA 95039 PH: (831) 775-1700			
			DRAWN						
			ENGINEER						
			CHECKED						
		MATERIAL	PROJECT NO.		XXXXXXXX	PIV INJECTOR PUMP GP42C-3st_203129_PARTMOD			
		FINISH	PROJECT		XXXXXXXX				
NEXT ASSY	USED ON	--	WEIGHT		0.109 lb.	SIZE A	DWG. NO. .DWG	REV.	
APPLICATION		DO NOT SCALE DRAWING	SCALE:1:1					WEIGHT: X0.109X	SHEET 1 OF 1