
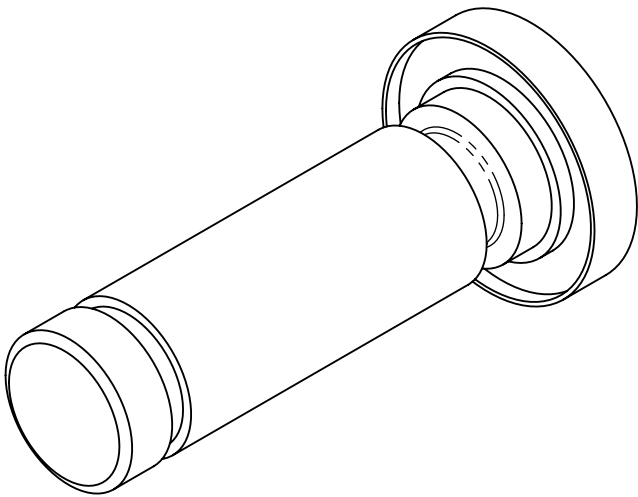
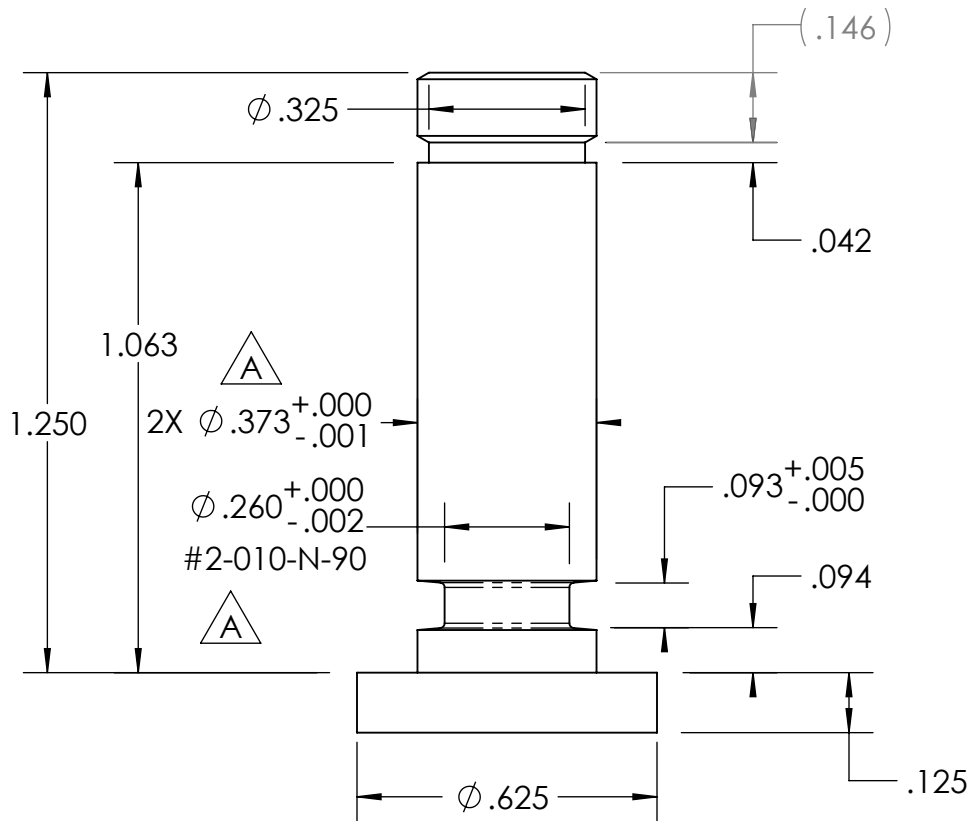
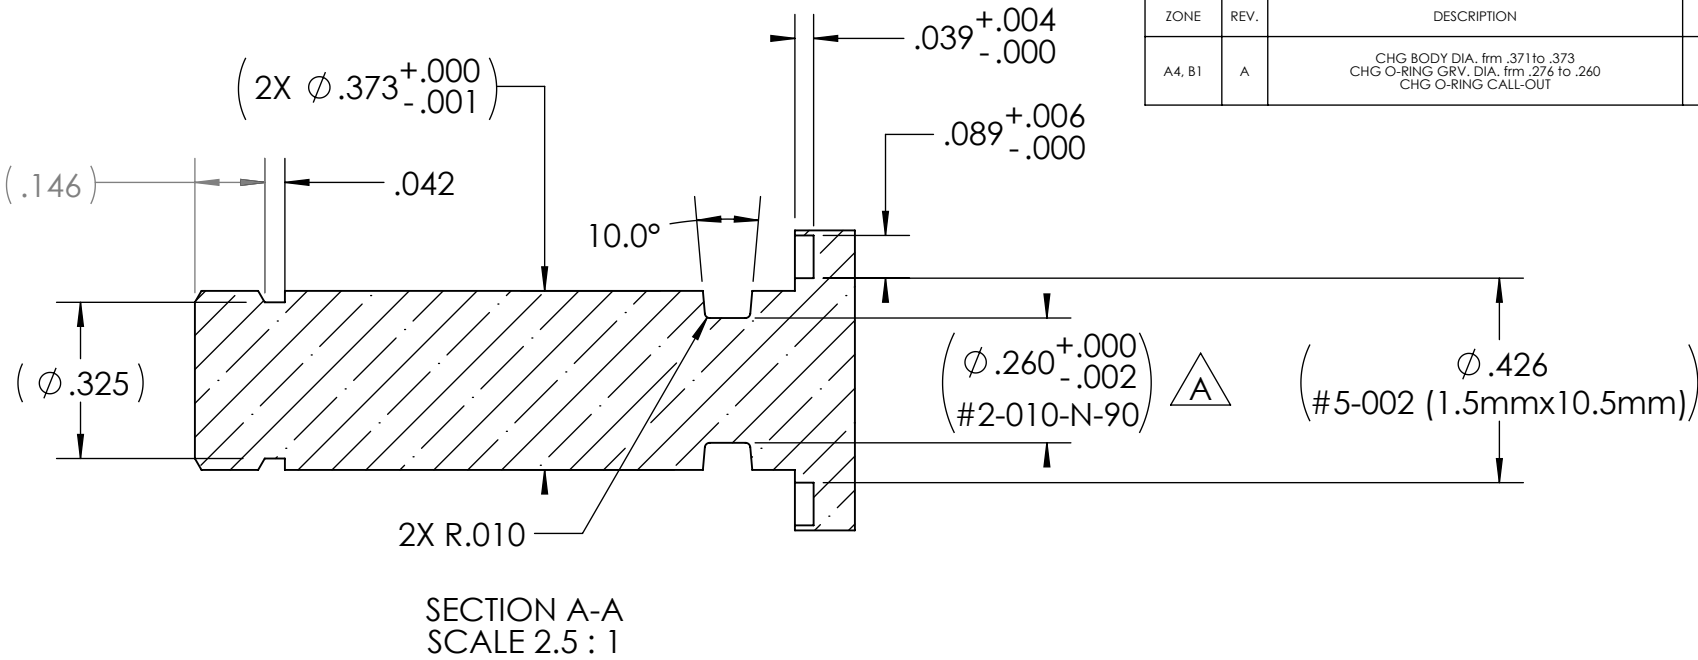


THE INFORMATION CONTAINED IN THIS DRAWING IS THE SOLE PROPERTY OF MBARI ANY REPRODUCTION IN PART OR WHOLE WITHOUT THE WRITTEN PERMISSION OF MBARI IS PROHIBITED.

REVISIONS				
INITIAL RELEASE			X/XX/01	J.E.
REVISIONS				
ZONE	REV.	DESCRIPTION	DATE	APPROVED
A4, B1	A	CHG BODY DIA. frm .371 to .373 CHG O-RING GRV. DIA. frm .276 to .260 CHG O-RING CALL-OUT	10/4/2022	J.E.

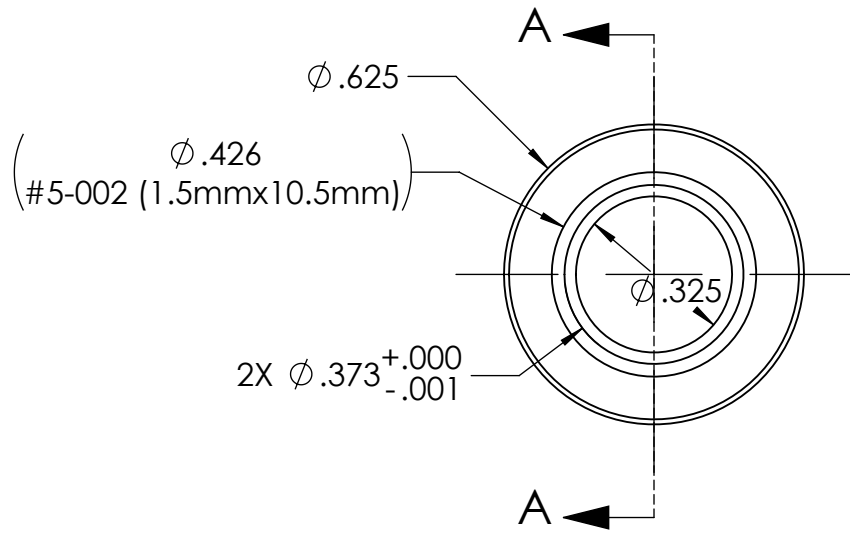

8. FOR BORE $\phi .375^{+.002}_{-.000}$. $\nabla 1.125$

7. PROJECT LIBRARY:\901506 DeepPIV\ME Drawings\Camera Housing\Sony Box Camera FCB-EV7320_V3
NOTES: (CONT. FROM TITLE BLOCK)

	1	P-202067-22	Lancer Port Blank		MBARI	6AL-4V Titanium	
ITEM NO.	QTY.	Part Number	DESCRIPTION		Vendor	MATERIAL	
BILL OF MATERIALS							
Shop / Q.C.		UNLESS OTHERWISE SPECIFIED TOLERANCES ARE:			APPROVALS DATE		
Inspector		1 PLACE DIM ±1/16	2 PLACE DIM ±.02	3 PLACE DIM ±.005	ANGLES ±1°	DRAWN J. ERICKSON 2/26/19	
Shop Foreman		1. DIMENSIONS ARE IN INCHES				ENGINEER J. ERICKSON 2/26/19	
Engineer		2. DIMENSION LIMITS HELD AFTER PLATING.				CHECKED	
		3. REMOVE BURRS AND SHARP EDGES .015 MAX.				PROJECT NO. 901506	
		4. MACHINED FILLET RADII .0150-.030.				PROJECT PIV	
NEXT ASSY Description	NEXT ASSY Number	5. MACHINED DIAMETERS ON A COMMON CENTERLINE CONCENTRIC WITHIN .005				SIZE B DWG. NO. P-202067-22.DWG	
	A-201874-19	6. PERPENDICULARITY & PARALLELISM OF MACHINED SURFACES .002 PER INCH. MAX .012 INCHES FOR SINGLE SURFACE.				REV. A	
Application		DO NOT SCALE DRAWING			WEIGHT 0.027		
					SCALE 2:1	CAD FILE: MECH ENG ON TORNADO	SHEET 1 OF 1

Monterey Bay Aquarium Research Institute
MBARI
7700 Sandholdt RD.
Moss Landing, CA 95039
PH: (831) 775-1700



SONY BOX CAMERA_V3

Lancer Port Blank

P-202067-22.DWG

REV. A