
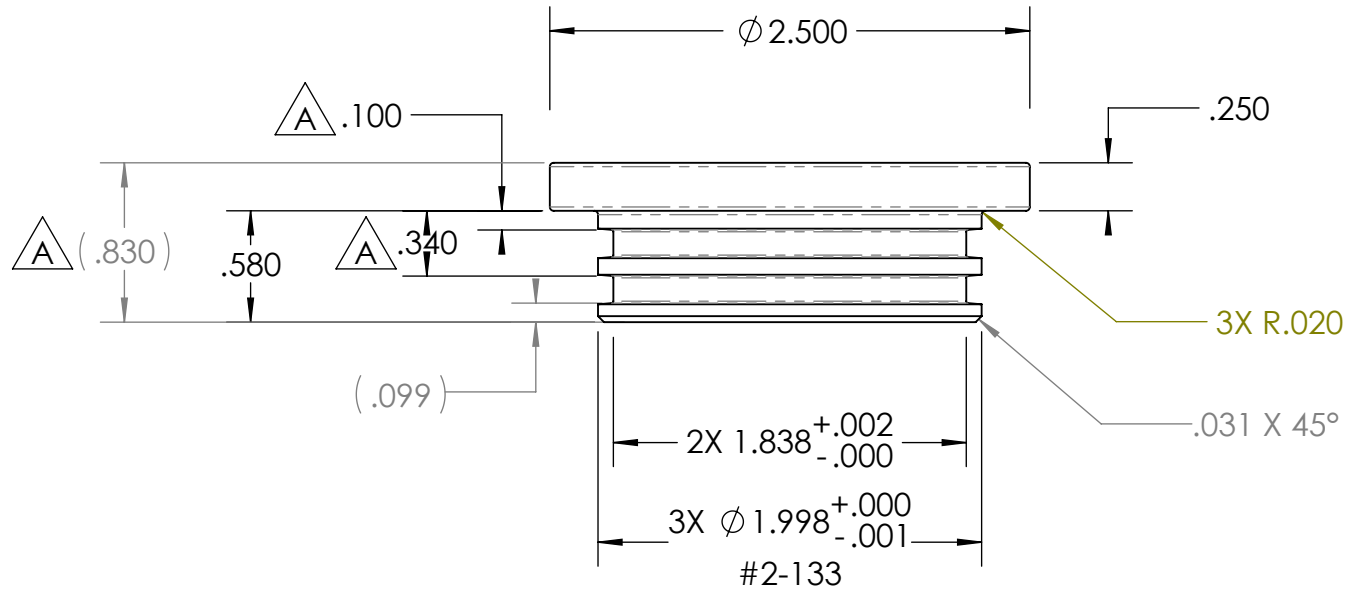
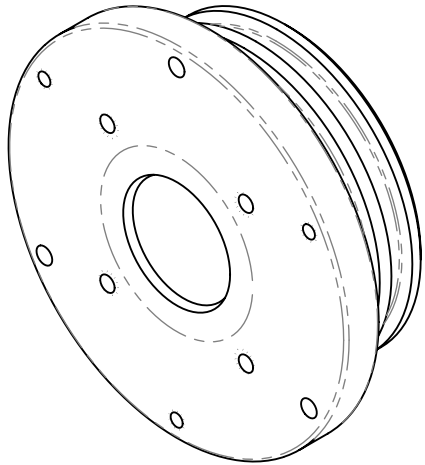
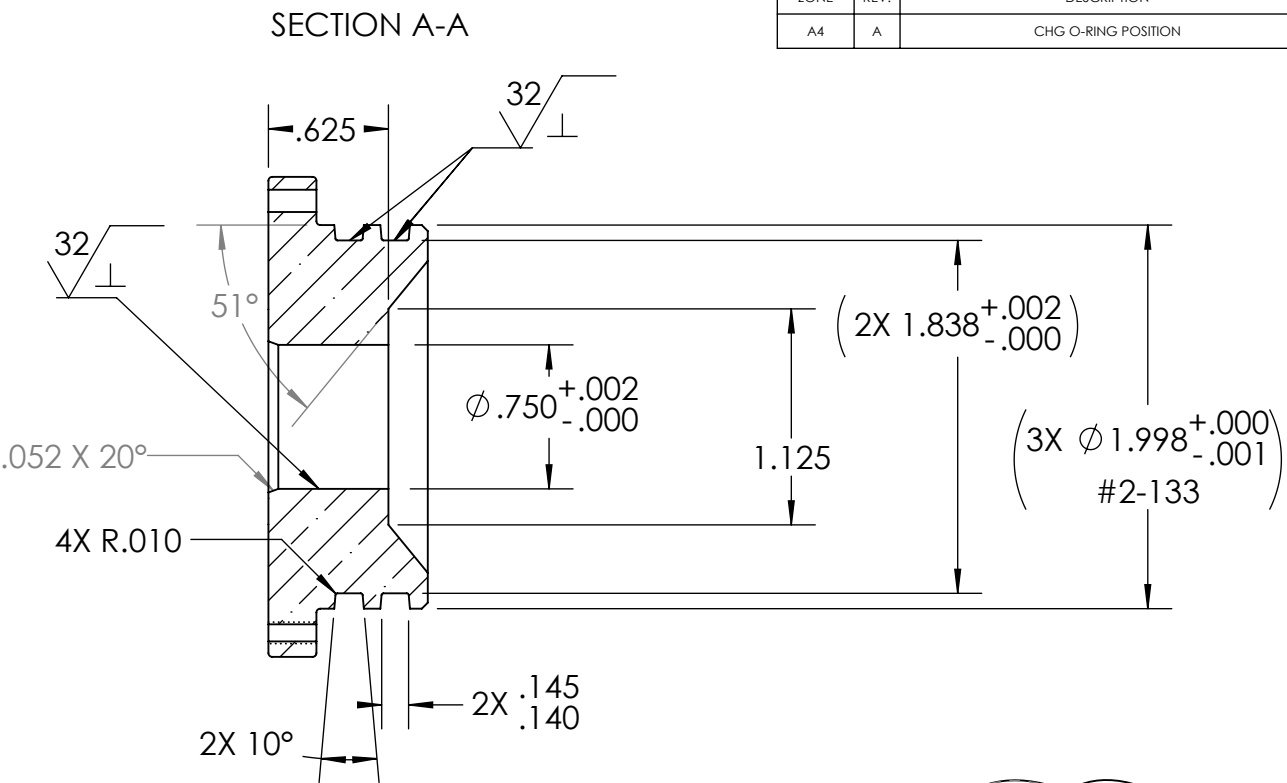


THE INFORMATION CONTAINED IN THIS DRAWING IS THE SOLE PROPERTY OF MBARI ANY REPRODUCTION IN PART OR WHOLE WITHOUT THE WRITTEN PERMISSION OF MBARI IS PROHIBITED.

REVISIONS				
INITIAL RELEASE			X/XX/01	J.E.
REVISIONS				
ZONE	REV.	DESCRIPTION	DATE	APPROVED
A4	A	CHG O-RING POSITION	2/14/2018	J.E.

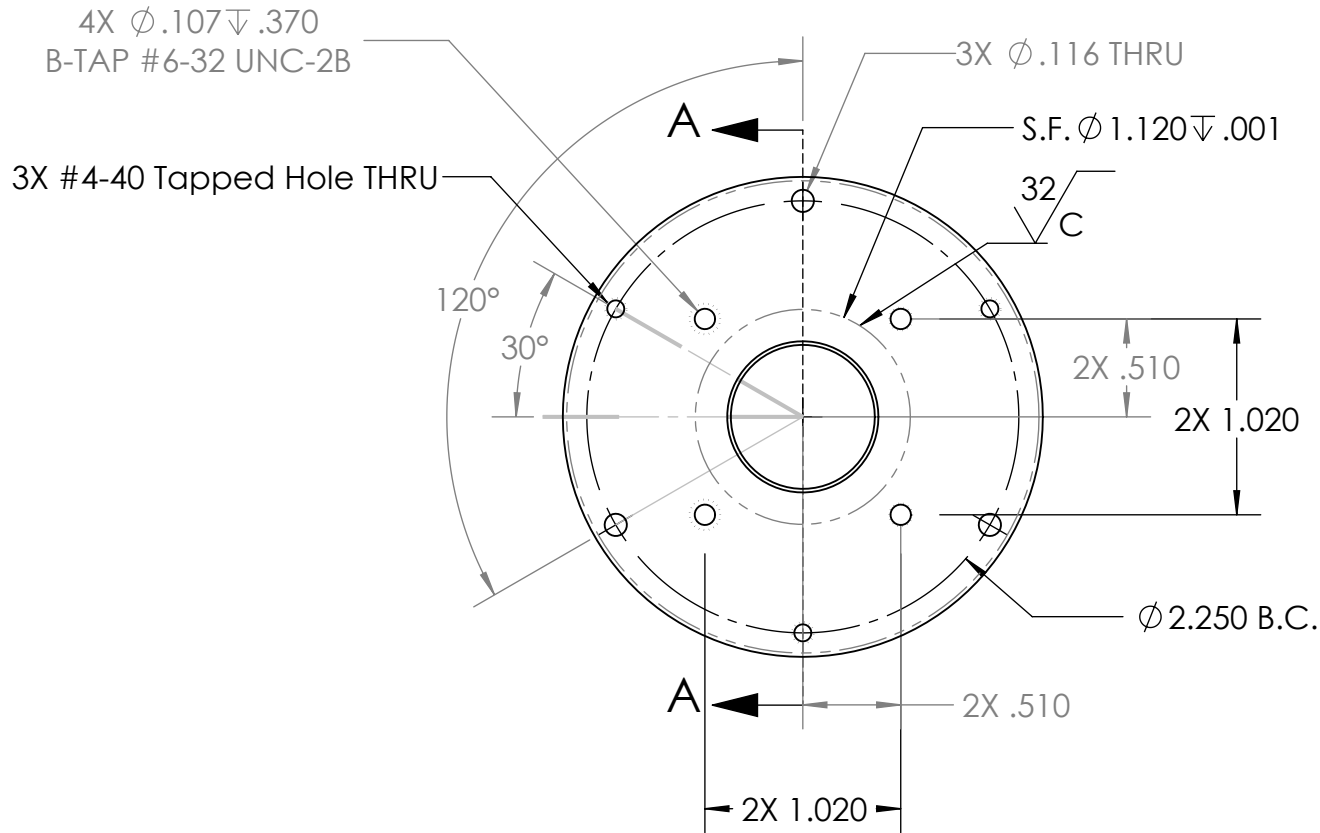

8. SWD = 4,000 m.

7. PROJECT LIBRARY:\901506 DeepPIV\ME Drawings\Laser Assembly\Remote Head

NOTES: (CONT. FROM TITLE BLOCK)

1	1	P-201782-16	PIV Fiber End Cap	MBARI	6AL-4V Titanium
ITEM NO.	QTY.	Part_Number	DESCRIPTION	Vendor	MATERIAL
BILL OF MATERIALS					
Shop / Q.C.		UNLESS OTHERWISE SPECIFIED TOLERANCES ARE:		APPROVALS DATE	
Inspector		1 PLACE DIM $\pm 1/16$	2 PLACE DIM $\pm .02$	3 PLACE DIM $\pm .005$	ANGLES $\pm 1^\circ$
Shop Foreman		1. DIMENSIONS ARE IN INCHES		DRAWN J. ERICKSON 2/3/16	
Engineer		2. DIMENSION LIMITS HELD AFTER PLATING.		ENGINEER J. ERICKSON 2/3/16	
		3. REMOVE BURRS AND SHARP EDGES .015 MAX.		CHECKED	
		4. MACHINED FILLET RADII .0150-.030.		PROJECT NO. 901506	
NEXT ASSY Description	NEXT ASSY Number	5. MACHINED DIAMETERS ON A COMMON CENTERLINE CONCENTRIC WITHIN .005		PROJECT Deep PIV	
	A-201785-16	6. PERPENDICULARITY & PARALLELISM OF MACHINED SURFACES .002 PER INCH, MAX .012 INCHES FOR SINGLE SURFACE.		WEIGHT 0.380	
Application		DO NOT SCALE DRAWING		SIZE B DWG. NO. P-201782-16.DWG	
				SCALE 1:1 CAD FILE: MECH ENG ON TORNADO SHEET 1 OF 1	

Monterey Bay Aquarium Research Institute
MBARI
7700 Sandholdt RD.
Moss Landing, CA 95039
PH: (831) 775-1700



REMOTE LASER HEAD

PIV Fiber End Cap

P-201782-16.DWG

REV. A